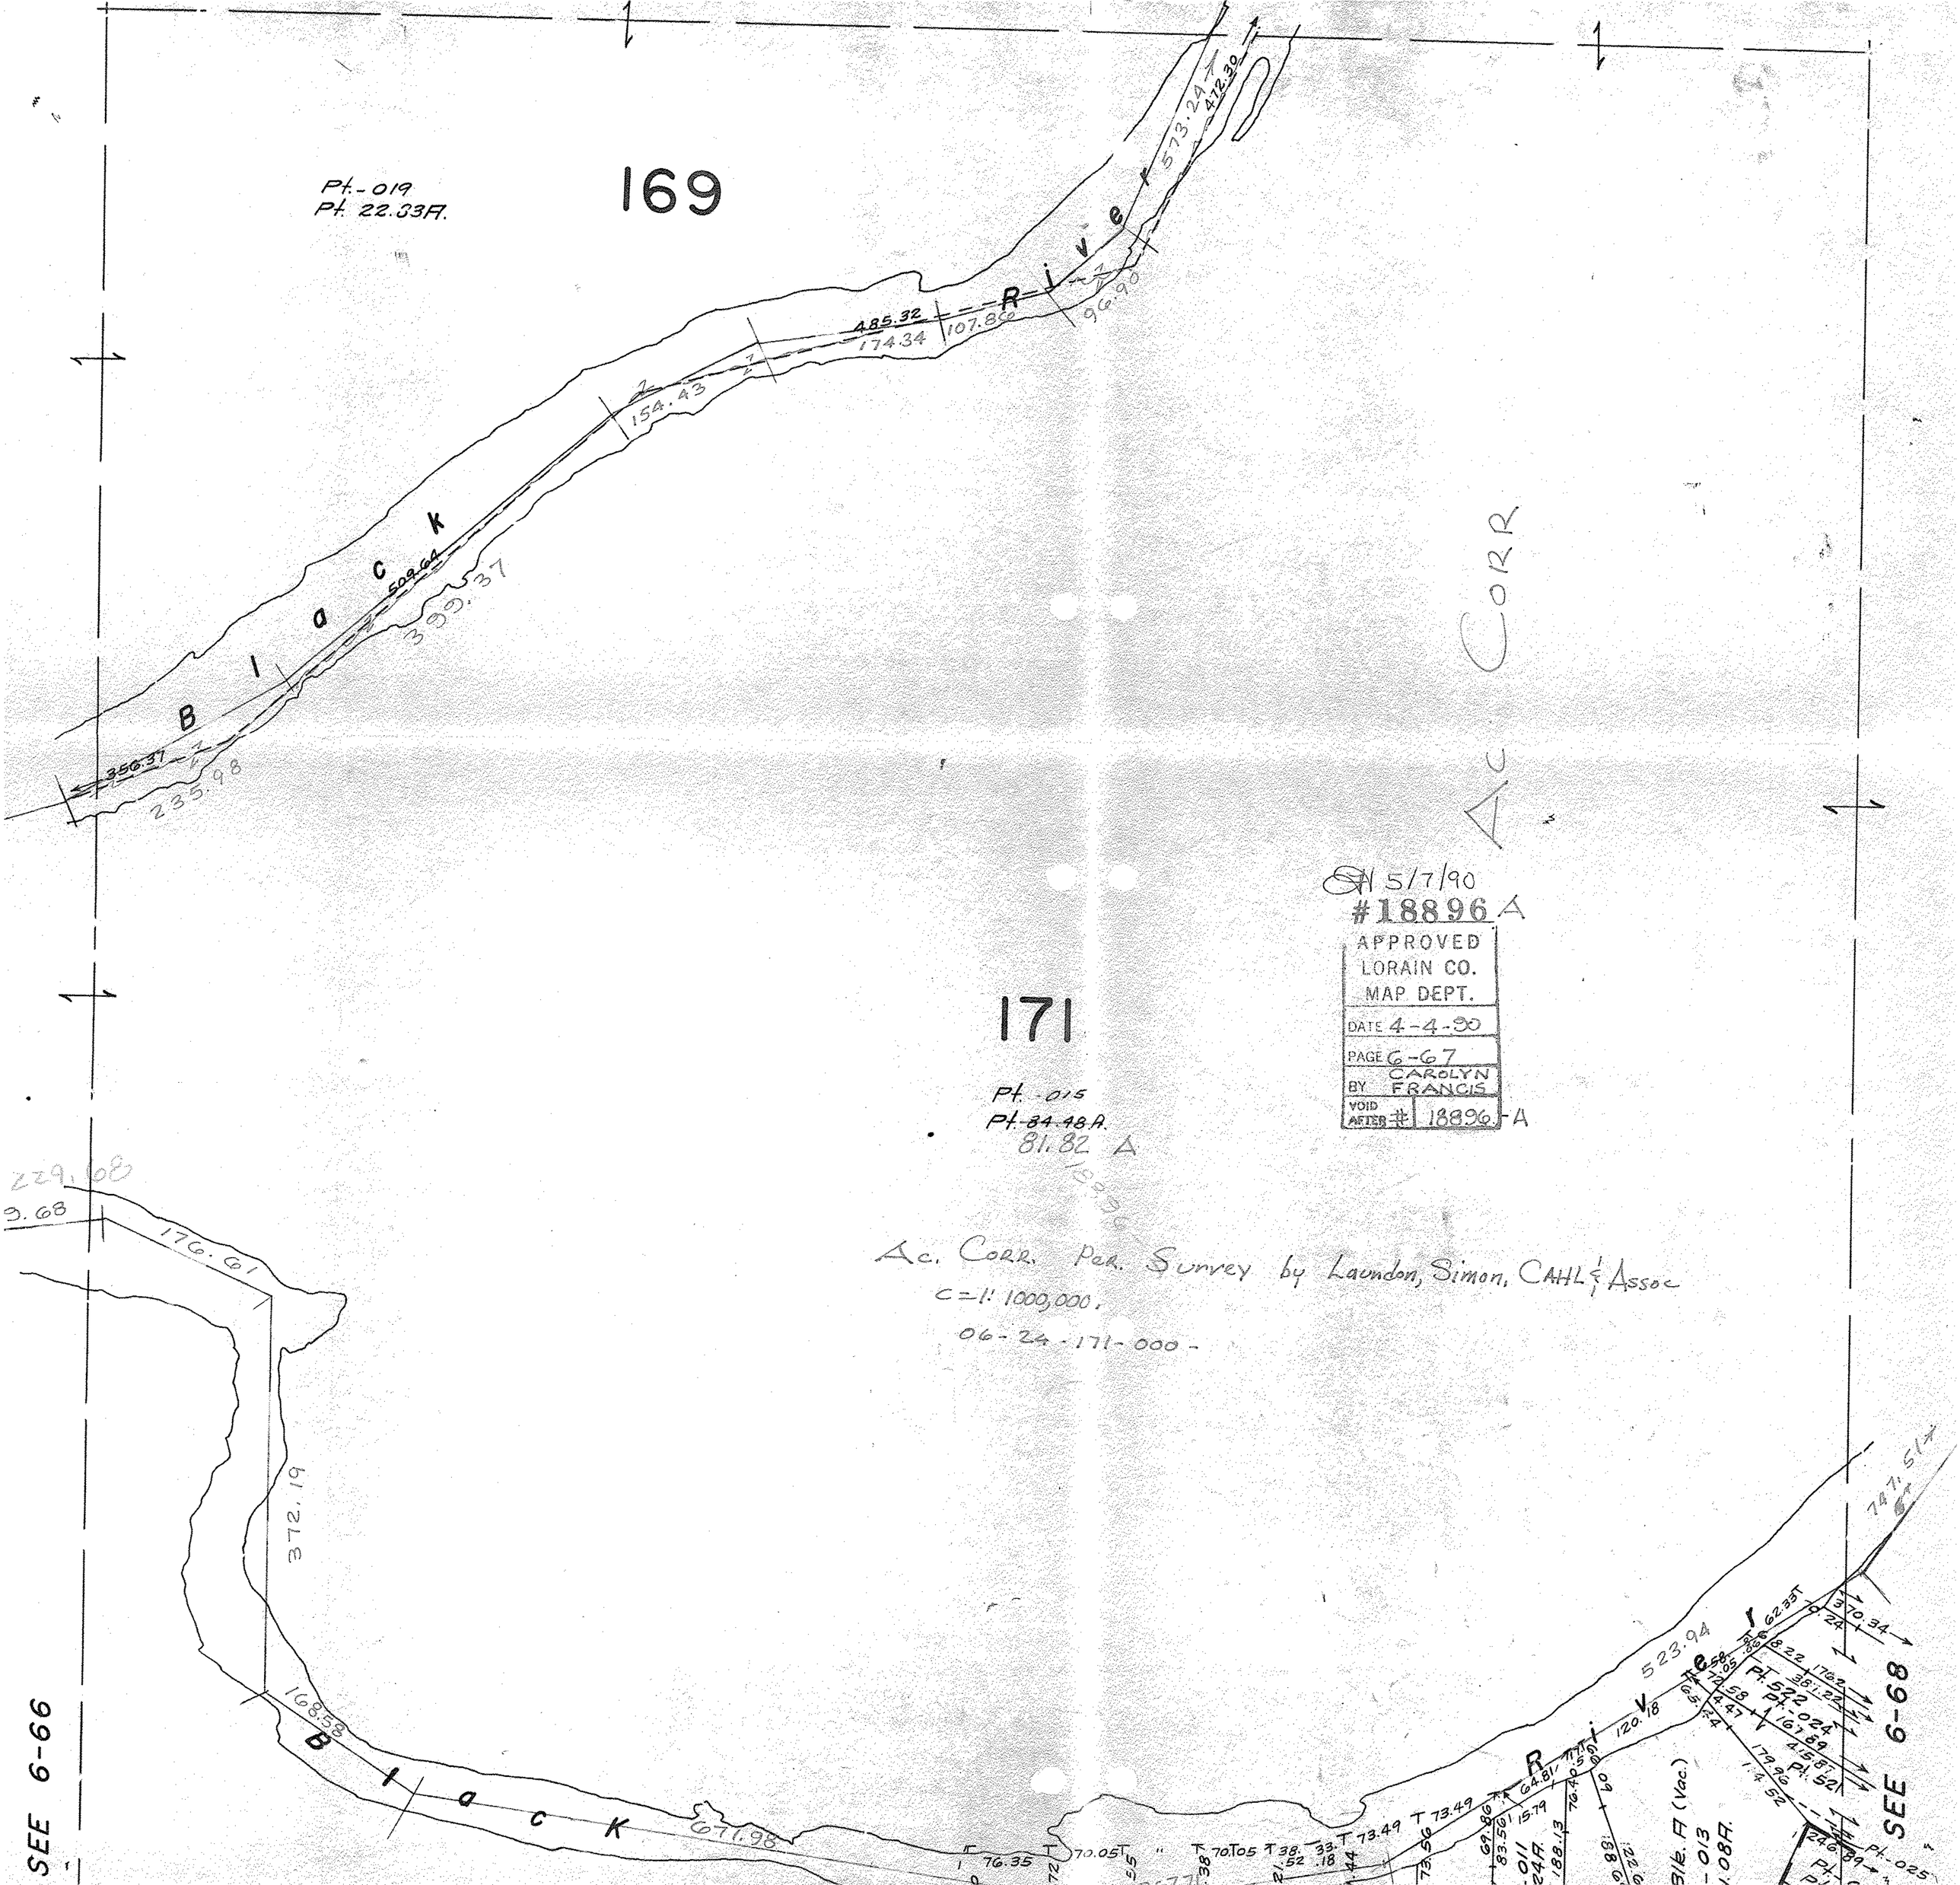

169
Pt.-019
Pt. 22.33A.
Black River
485.32
174.34
107.86
96.90
573.24
472.30
154.43
509.64
399.37
356.37
235.98
Ac. Corr
5/7/90
#18896 A
APPROVED
LORAIN CO.
MAP DEPT.
DATE 4-4-90
PAGE 6-67
BY CAROLYN FRANCIS
VOID AFTER # 18896-A
171
Pt.-015
Pt.-84.48A.
81.82 A
Ac. Corr. Per. Survey by Laundon, Simon, CAHL & Assoc
c=1:1000,000.
06-24-171-000-
229.68
176.61
372.19
168.58
671.98
523.94
747.51
SEE 6-66
SEE 6-68