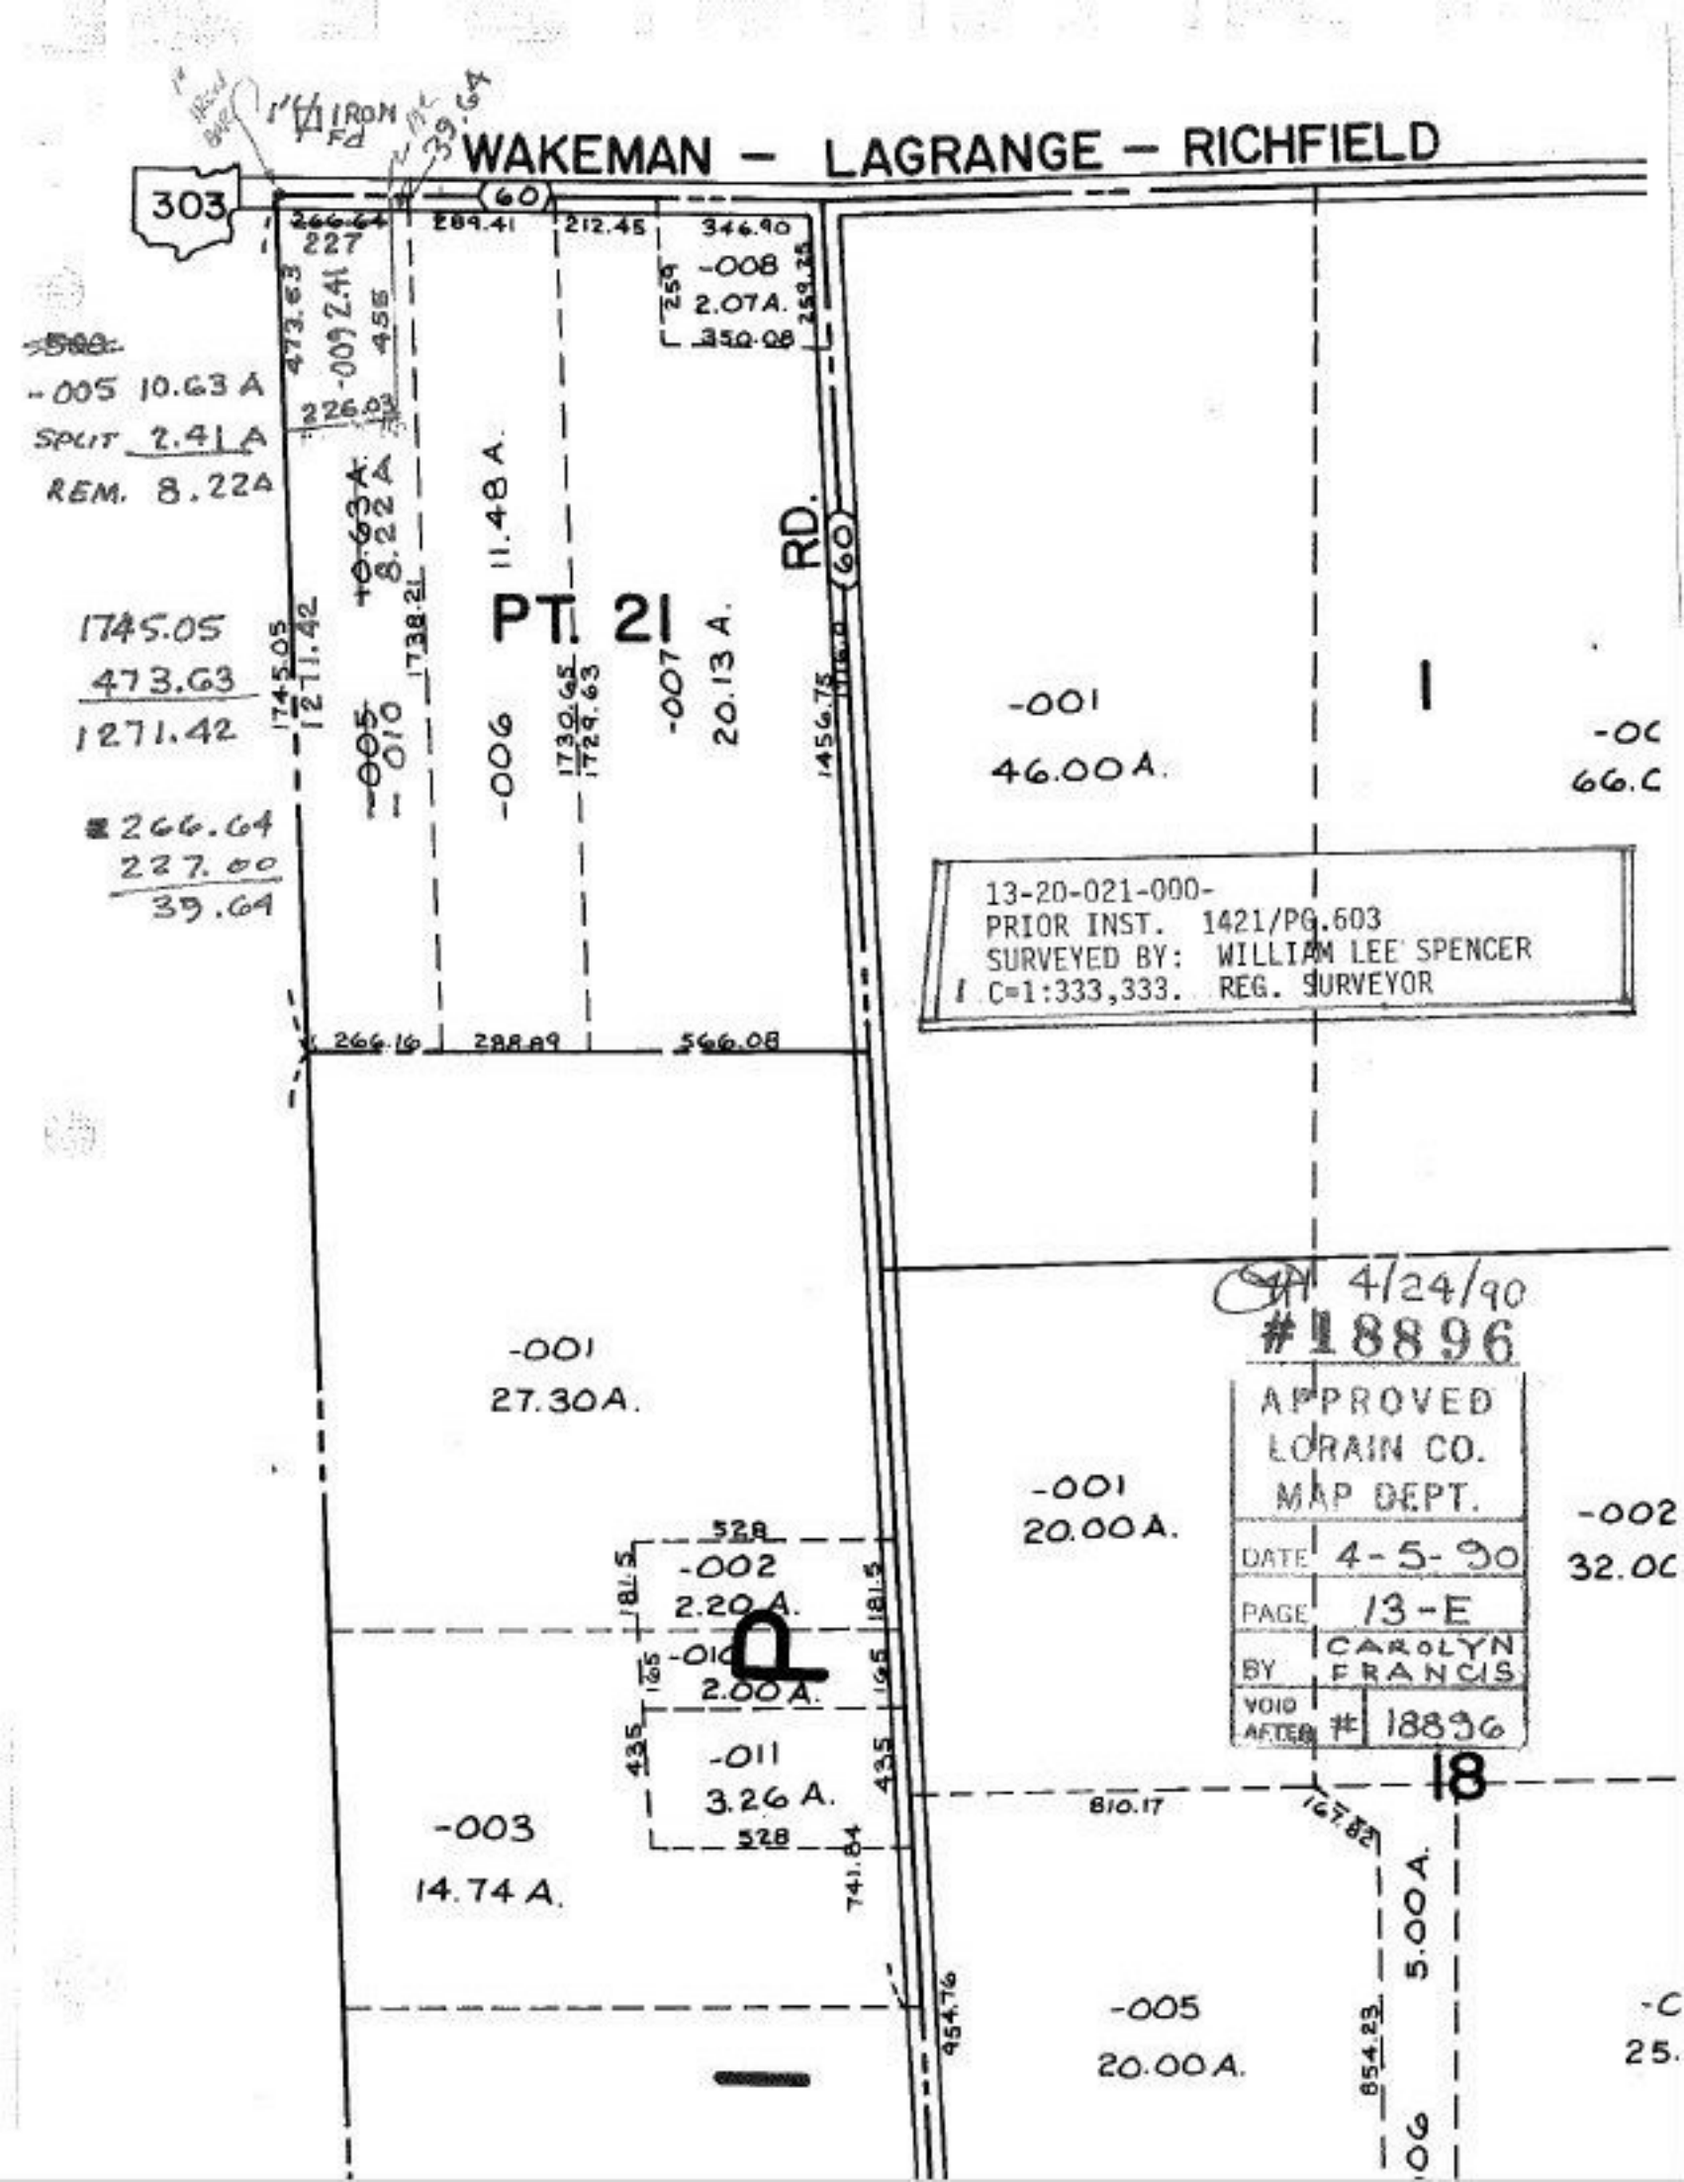
WAKEMAN – LAGRANGE – RICHFIELD
303
60
1" IRON FD
39.64
266.64
227
289.41
212.45
346.90
-008
2.07A.
350.08
259.25
473.63
-009 2.41
455
226.03
-005 10.63 A
SPLIT 2.41 A
REM. 8.22A
+0.63 A
8.22 A
11.48 A.
PT. 21
RD.
60
1745.05
473.63
1271.42
1738.21
-005
-010
-006
1730.65
1729.63
-007
20.13 A.
1456.75
-001
46.00A.
1
13-20-021-000-
PRIOR INST. 1421/PG.603
SURVEYED BY: WILLIAM LEE SPENCER
1 C=1:333,333. REG. SURVEYOR
266.64
227.00
39.64
266.16
288.89
566.08
-001
27.30A.
-001
20.00A.
528
-002
2.20A.
181.5
-010
2.00A.
165
435
-011
3.26A.
-003
14.74A.
741.84
810.17
167.82
5.00A.
-005
20.00A.
454.76
854.23
4/24/90
#18896
APPROVED
LORAIN CO.
MAP DEPT.
DATE 4-5-90
PAGE 13-E
BY CAROLYN FRANCIS
VOID AFTER # 18896
18