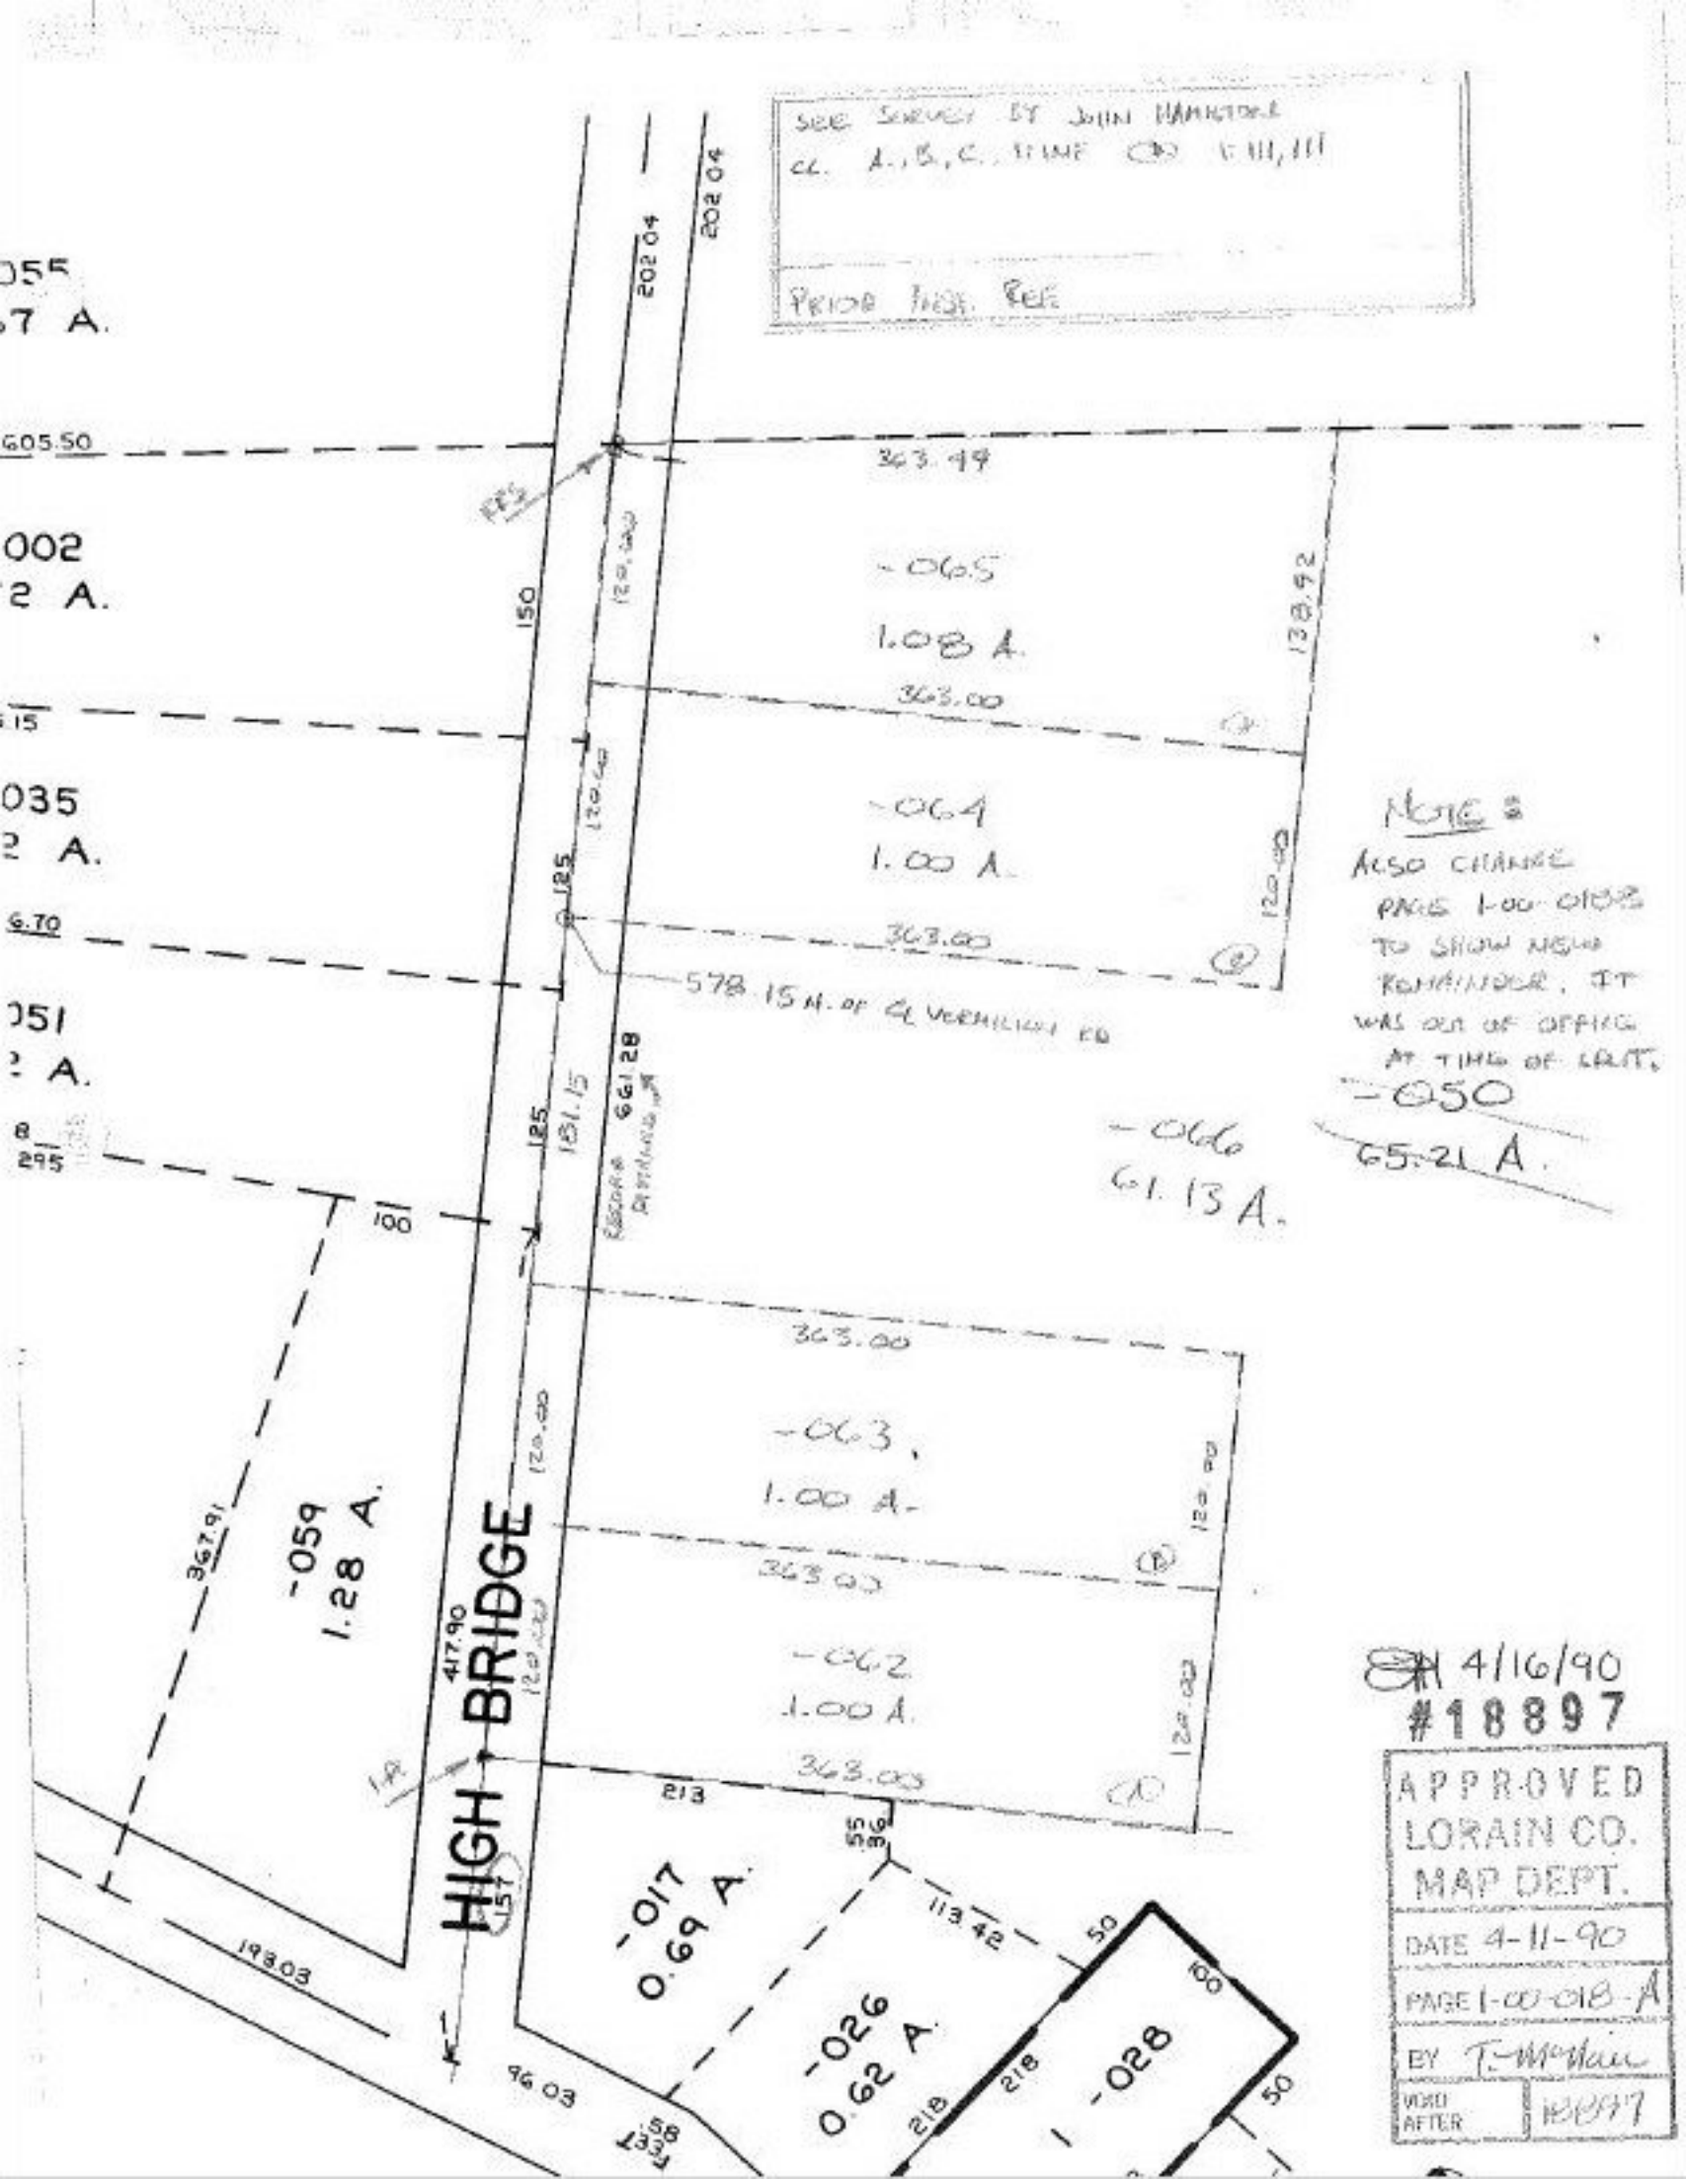
SEE SURVEY BY JOHN HAMILTON
cl. A., B., C. NONE
PRIOR PROP. REF.
202.04
202.04
363.49
-065
1.08 A.
363.00
138.92
-064
1.00 A.
363.00
120.00
NOTE:
ALSO CHANGE
PAGE 1-00-010B
TO SHOW NEW
REMAINDER. IT
WAS OUT OF OFFICE
AT TIME OF CALL.
-050
65.21 A.
578.15 N. of ℄ VERMILION RD
-066
61.13 A.
661.28
181.15
363.00
-063
1.00 A.
363.00
-062
1.00 A.
363.00
213
-059
1.28 A.
367.91
417.90
HIGH BRIDGE
-017
0.69 A.
-026
0.62 A.
-028
198.03
96.03
113.42
50
100
218
218
50
4/16/90
#18897
APPROVED
LORAIN CO.
MAP DEPT.
DATE 4-11-90
PAGE 1-00-018-A
BY T. McClain
VOID AFTER
18897