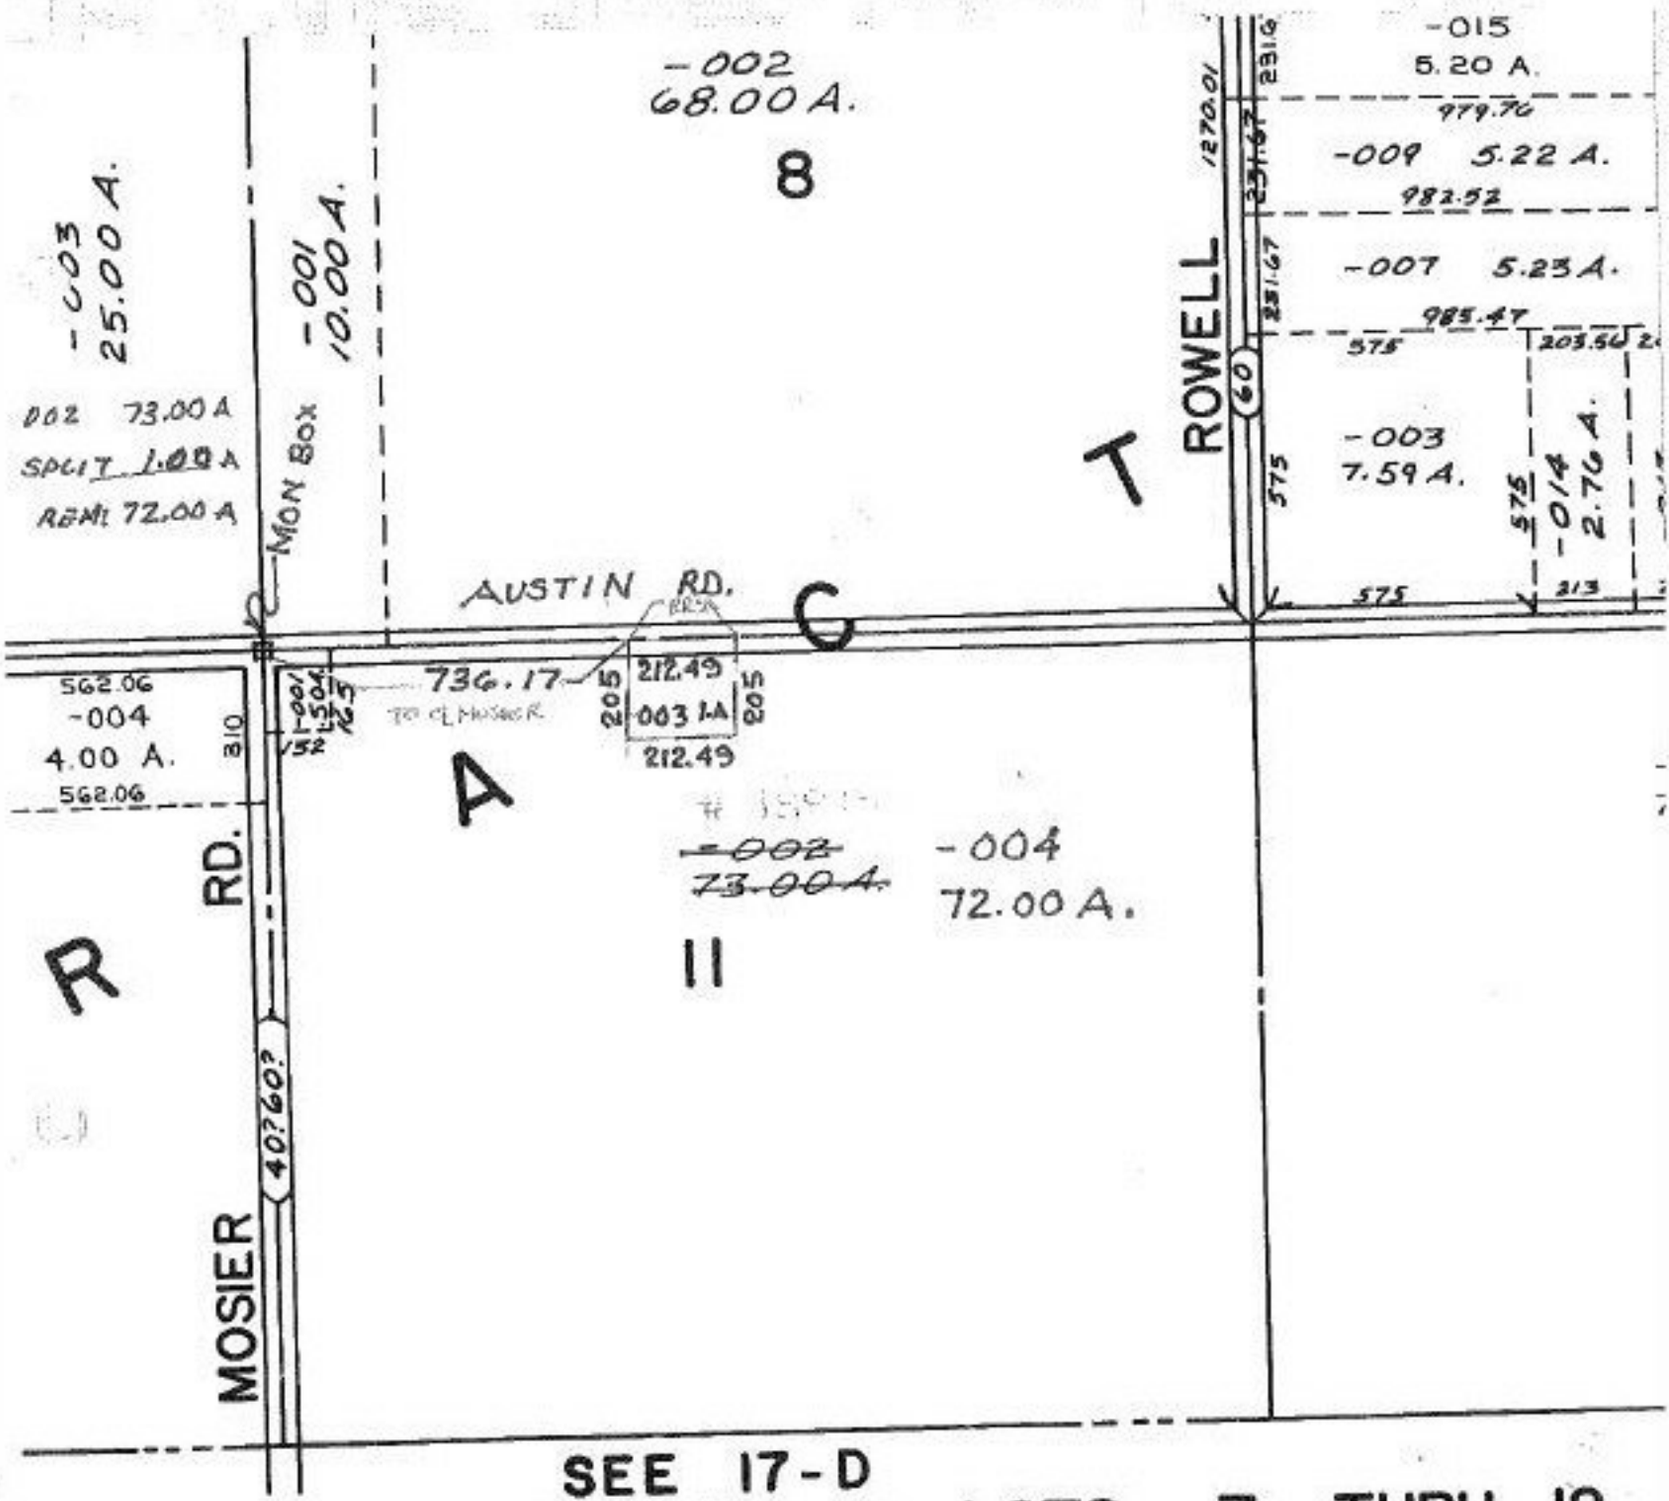


SEE 17-D

TWP. TRACT 8 LOTS 7 THRU 12
" 9 " 7 " 12,

4/24/90
#18898

APPROVED
LORAIN CO.
MAP DEPT.
DATE 4-5-90
PAGE 13-H
BY CAROLYN FRANCIS
VOID AFFIDAVIT # 18898

13-08-011-000- PRIOR INST. O.R.46/534 167/901
SURVEYED BY: WILLIAM L. FOX REG. SURVEYOR
C=1: INF.