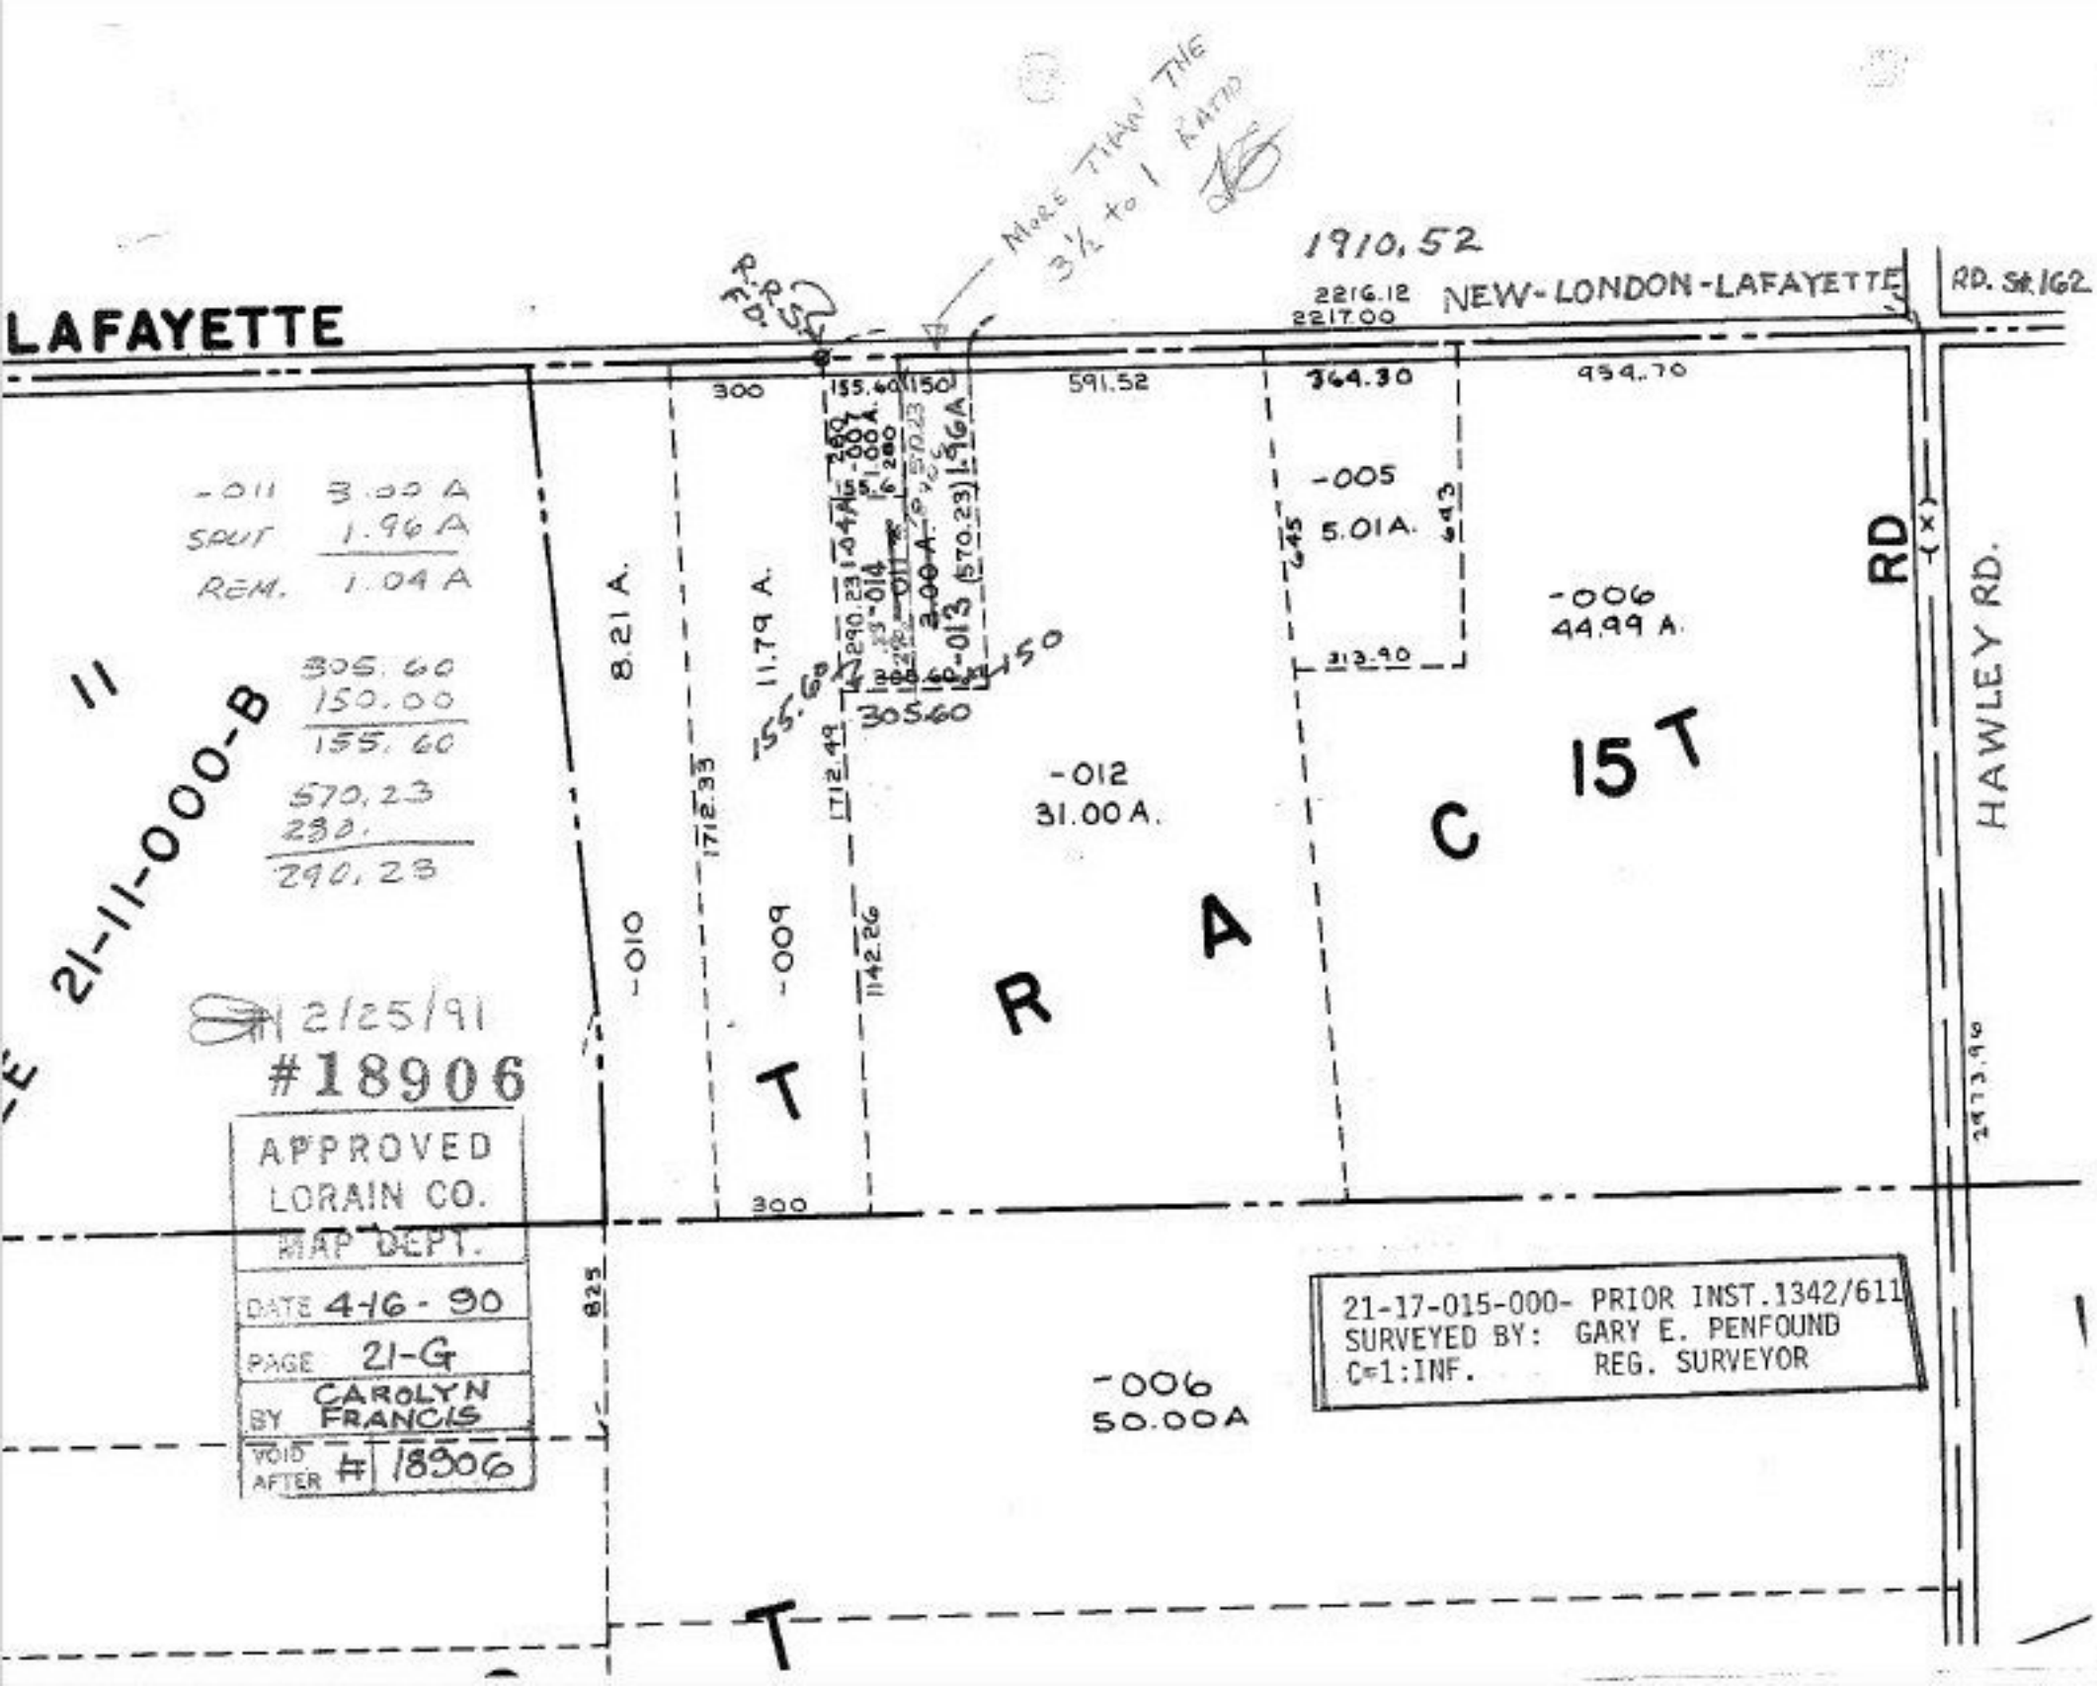

LAFAYETTE
NEW-LONDON-LAFAYETTE
RD. St. 162
1910.52
2216.12
2217.00
More than the 3½ to 1 Ratio
R.R.S.
F.D.
300
155.60
150
591.52
364.30
954.70
-011 3.00 A
SPLIT 1.96 A
REM. 1.04 A
305.60
150.00
155.60
570.23
280.
290.23
21-11-000-B
8.21 A.
11.79 A.
-005
5.01 A.
-006
44.99 A.
-012
31.00 A.
-010
-009
-006
50.00 A
1712.33
1712.49
1142.26
313.90
645
643
305.60
155.60
150
HAWLEY RD.
RD
T R A C 15 T
2973.96
825
2/25/91
#18906
APPROVED
LORAIN CO.
MAP DEPT.
DATE 4-16-90
PAGE 21-G
BY CAROLYN FRANCIS
VOID AFTER # 18906
21-17-015-000- PRIOR INST.1342/611
SURVEYED BY: GARY E. PENFOUND
C=1:INF. REG. SURVEYOR