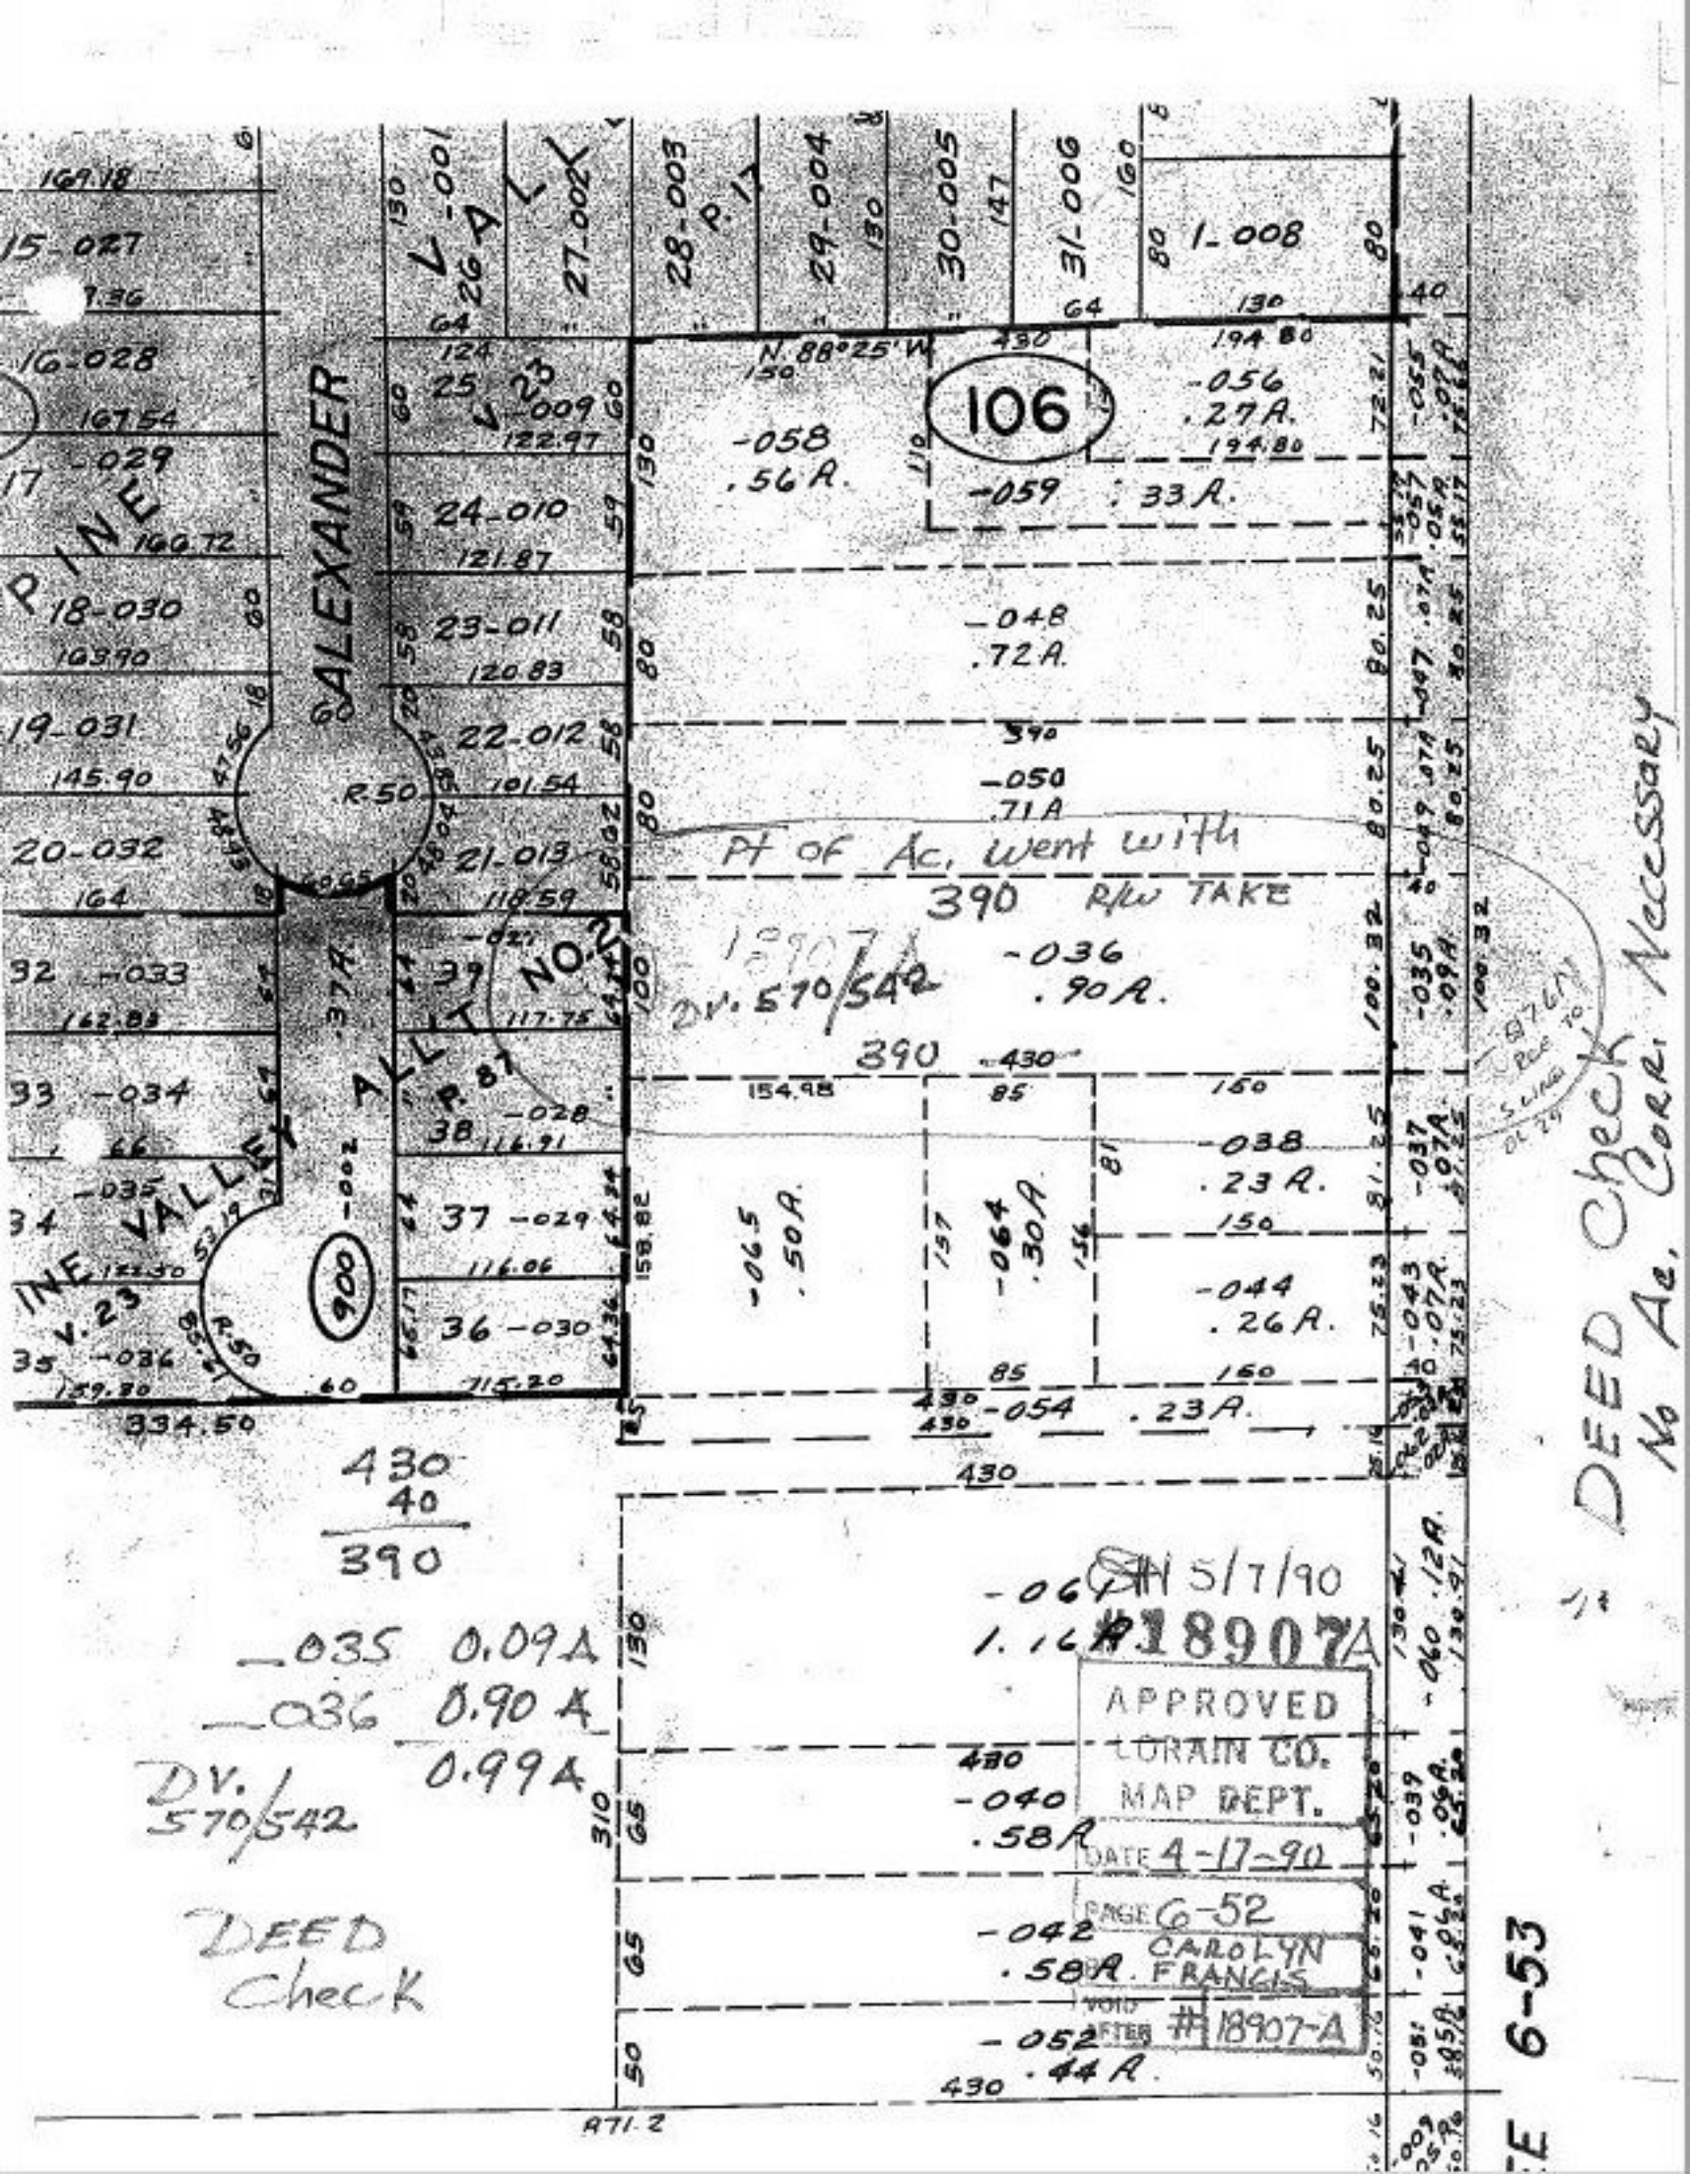

ALEXANDER
PINE VALLEY ALL'T NO. 2
106
900
Pt of Ac. went with
390 R/W TAKE
DV. 570/542
DEED Check
No Ac. Corr. Necessary
430
40
390
-035 0.09A
-036 0.90 A
0.99A
DV. 570/542
DEED Check
5/7/90
#18907A
APPROVED
LORAIN CO.
MAP DEPT.
DATE 4-17-90
PAGE 6-52
CAROLYN FRANCIS
VOID AFTER #18907-A
6-53