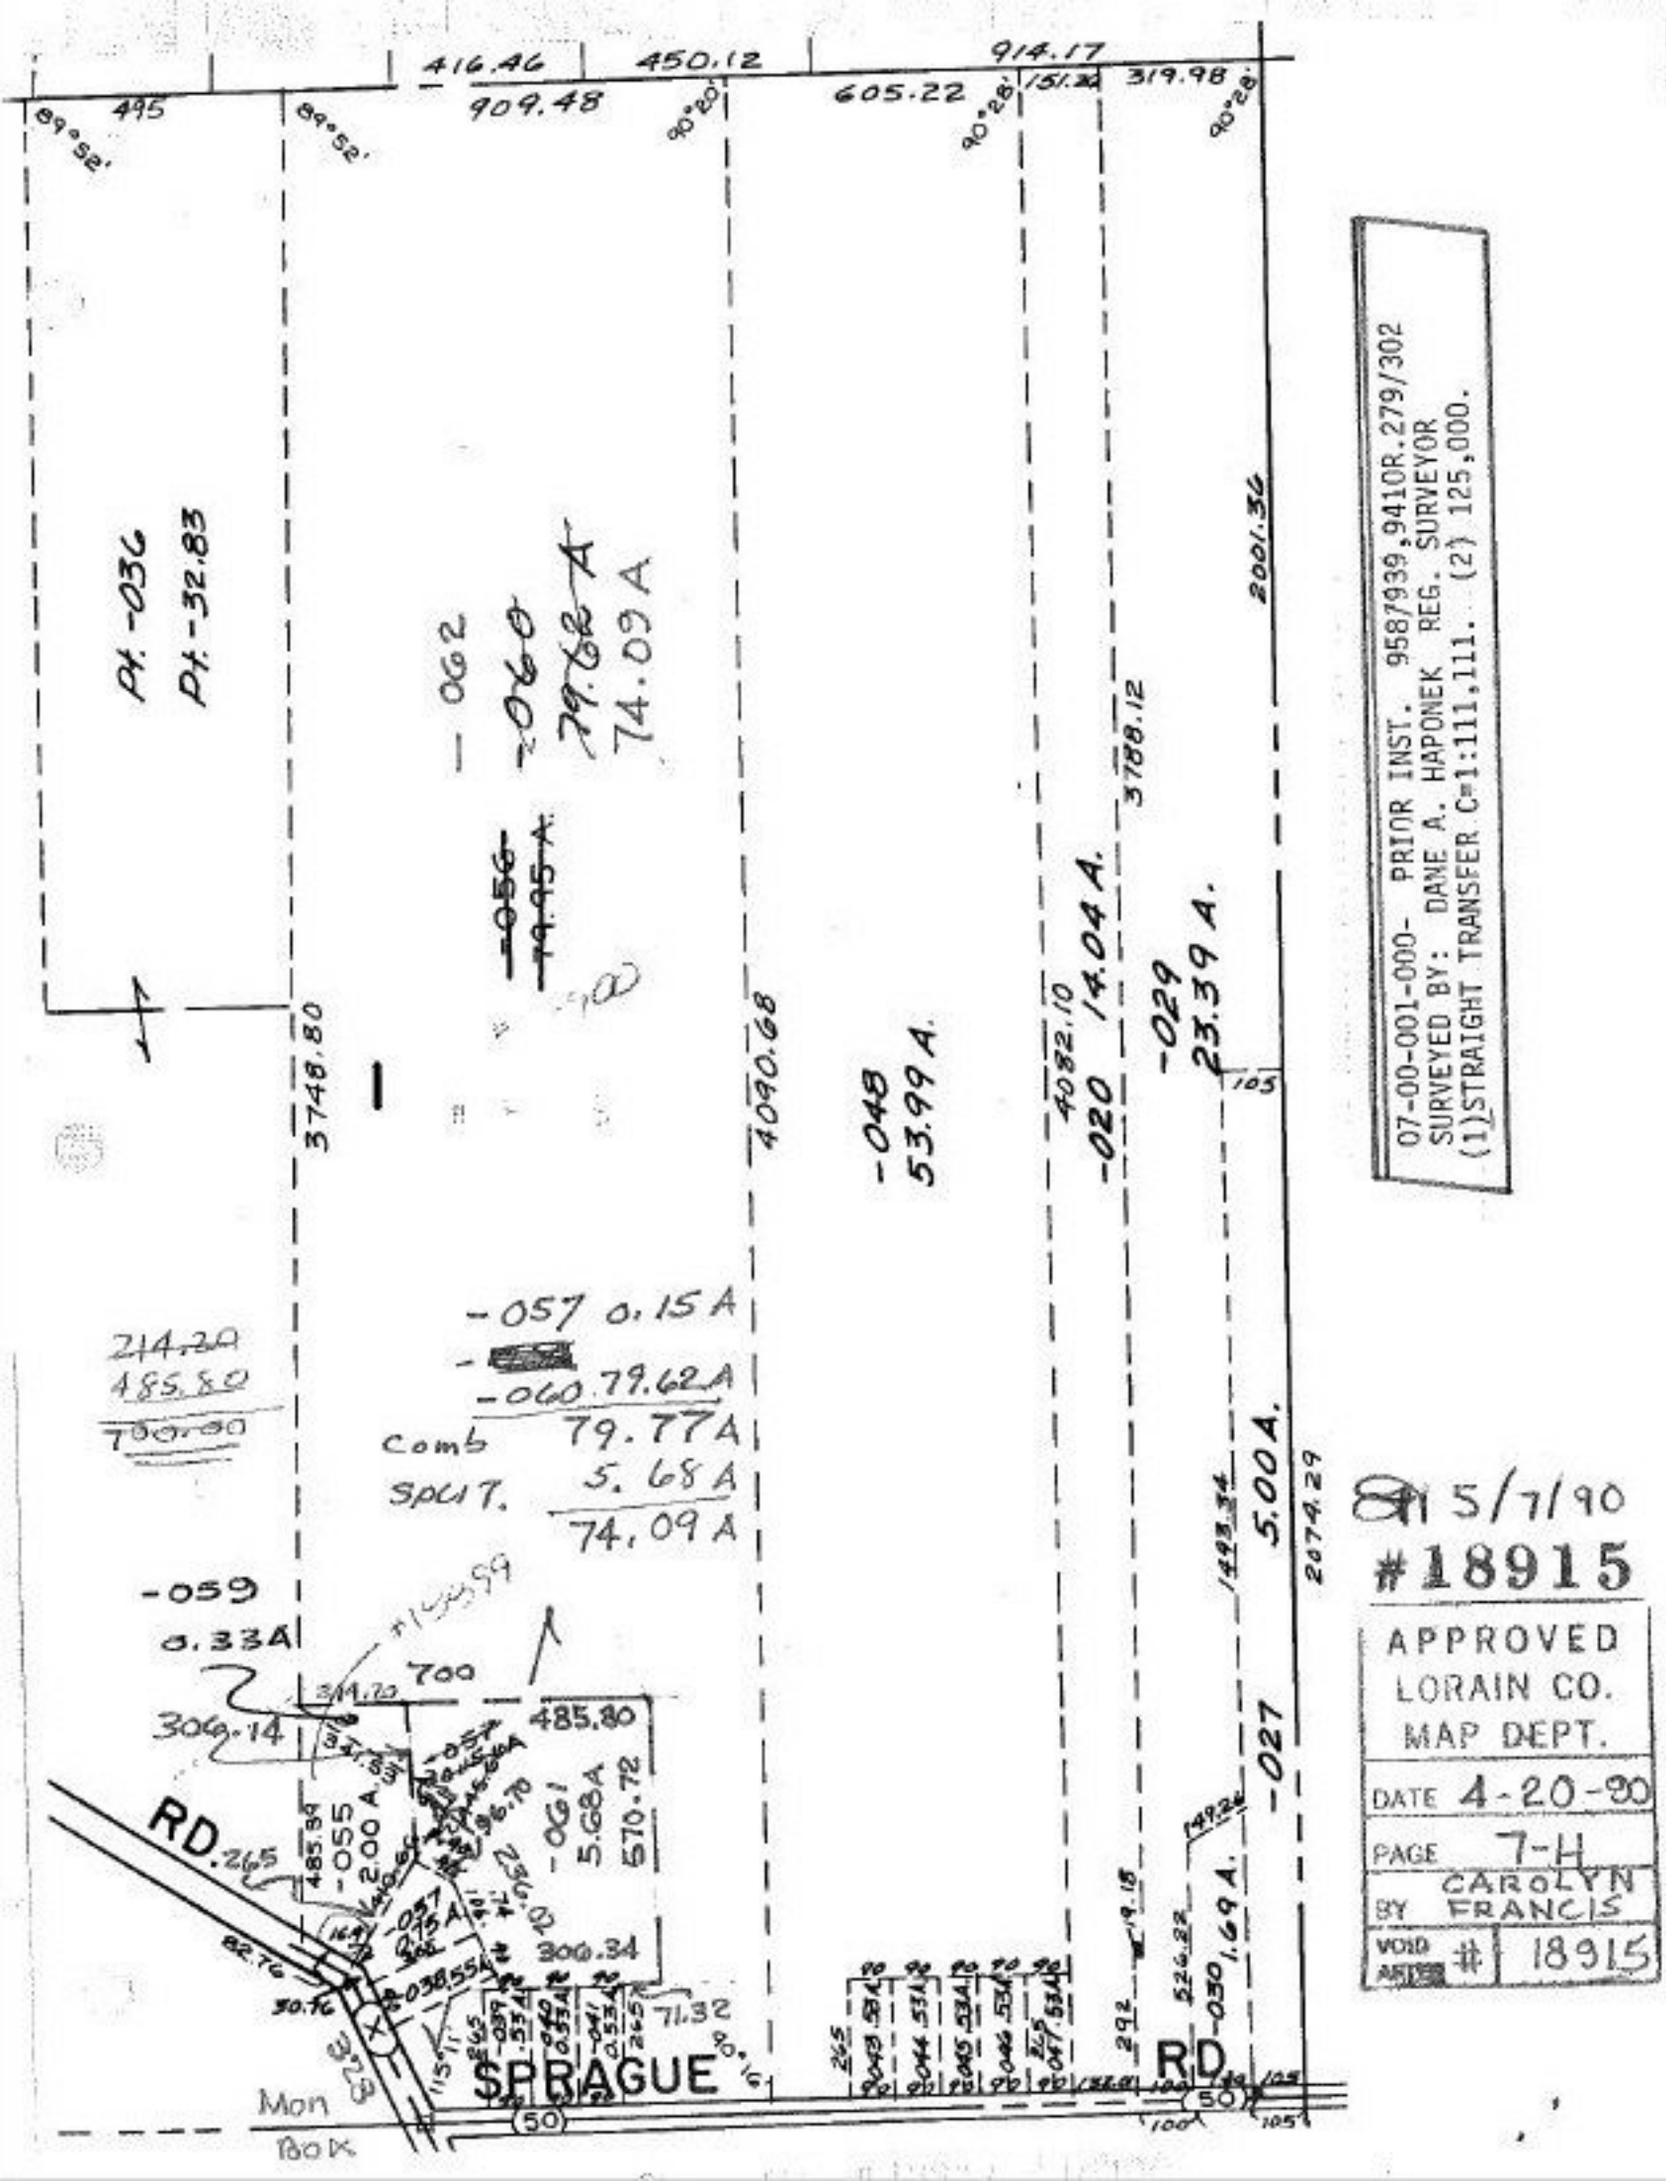
416.46
450.12
914.17
909.48
605.22
319.98
495
89°52'
89°52'
90°20'
90°28'
90°28'
Pt.-036
Pt.-32.83
-062
-060
79.62A
74.09A
-056
79.95A
3748.80
4090.68
-048
53.99A.
4082.10
-020 14.04A.
3788.12
-029
23.39A.
2001.36
105
-057 0.15A
-060 79.62A
comb 79.77A
split 5.68A
74.09A
214.29
485.80
700.00
-059
0.33A
700
311.20
485.80
306.14
-055
2.00A.
-061
5.68A
570.72
485.34
300.34
71.32
RD. 265
SPRAGUE RD.
Mon
Box
5.00A.
1.69A.
-027
-030
2074.29
1498.34
526.22
292
149.26
5/7/90
#18915
APPROVED
LORAIN CO.
MAP DEPT.
DATE 4-20-90
PAGE 7-H
BY CAROLYN FRANCIS
VOID AFFIX # 18915
07-00-001-000- PRIOR INST. 958/939,9410R.279/302
SURVEYED BY: DANE A. HAPONEK REG. SURVEYOR
(1)STRAIGHT TRANSFER C=1:111,111. (2) 125,000.