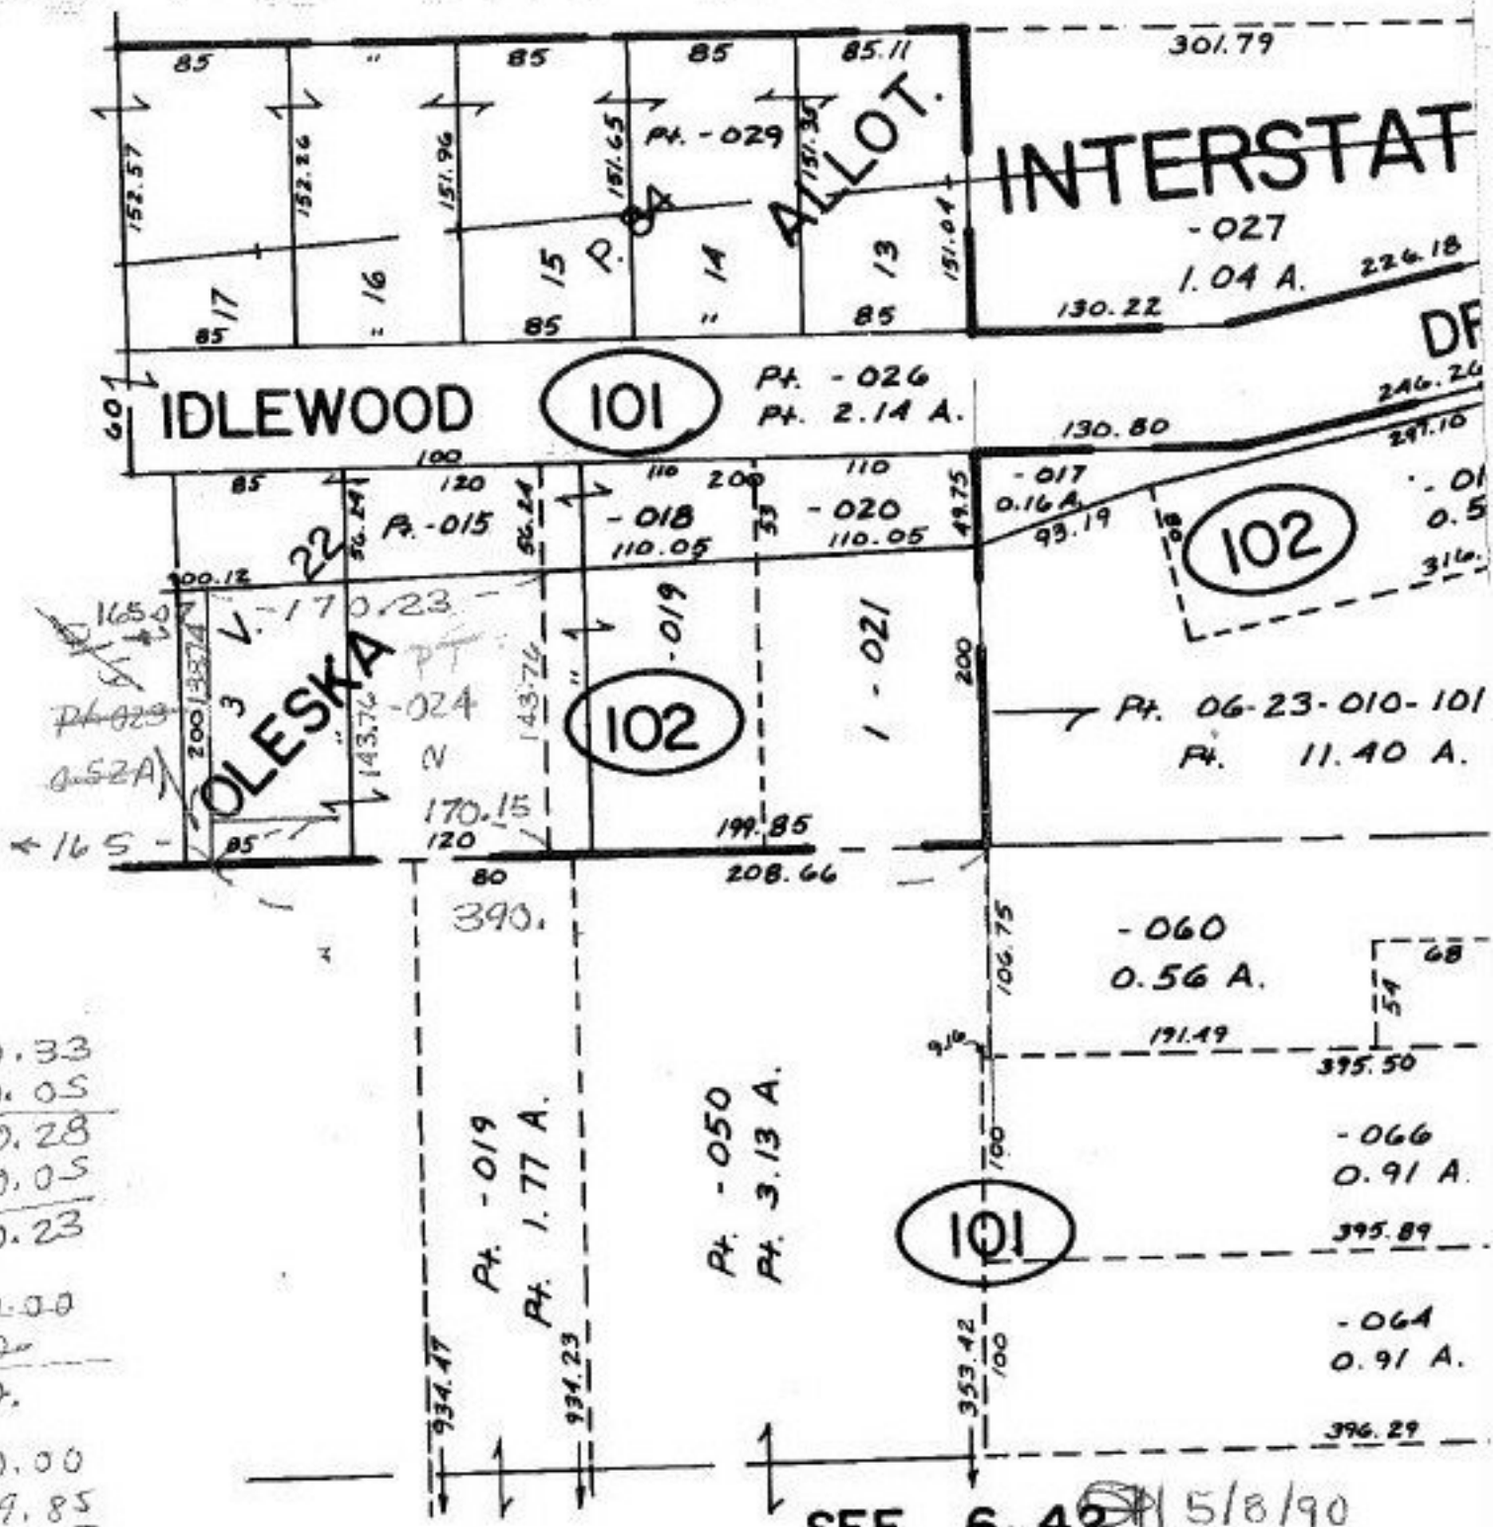

390.33
110.05
280.28
110.05
170.23

390.00
170.
390.00
199.85

200.00
56.24
143.76

5/8/90
#18919

06-23-010-102- PRIOR INST. 1155/744
SURVEYED BY: CHARLES P. NARYU
C=1:142857 REG. SURVEYOR

APPROVED
LORAIN CO.
MAP DEPT.
DATE 4-24-90
PAGE 6-25
BY CAROLYN FRANCIS
VOID AFTER # 18919