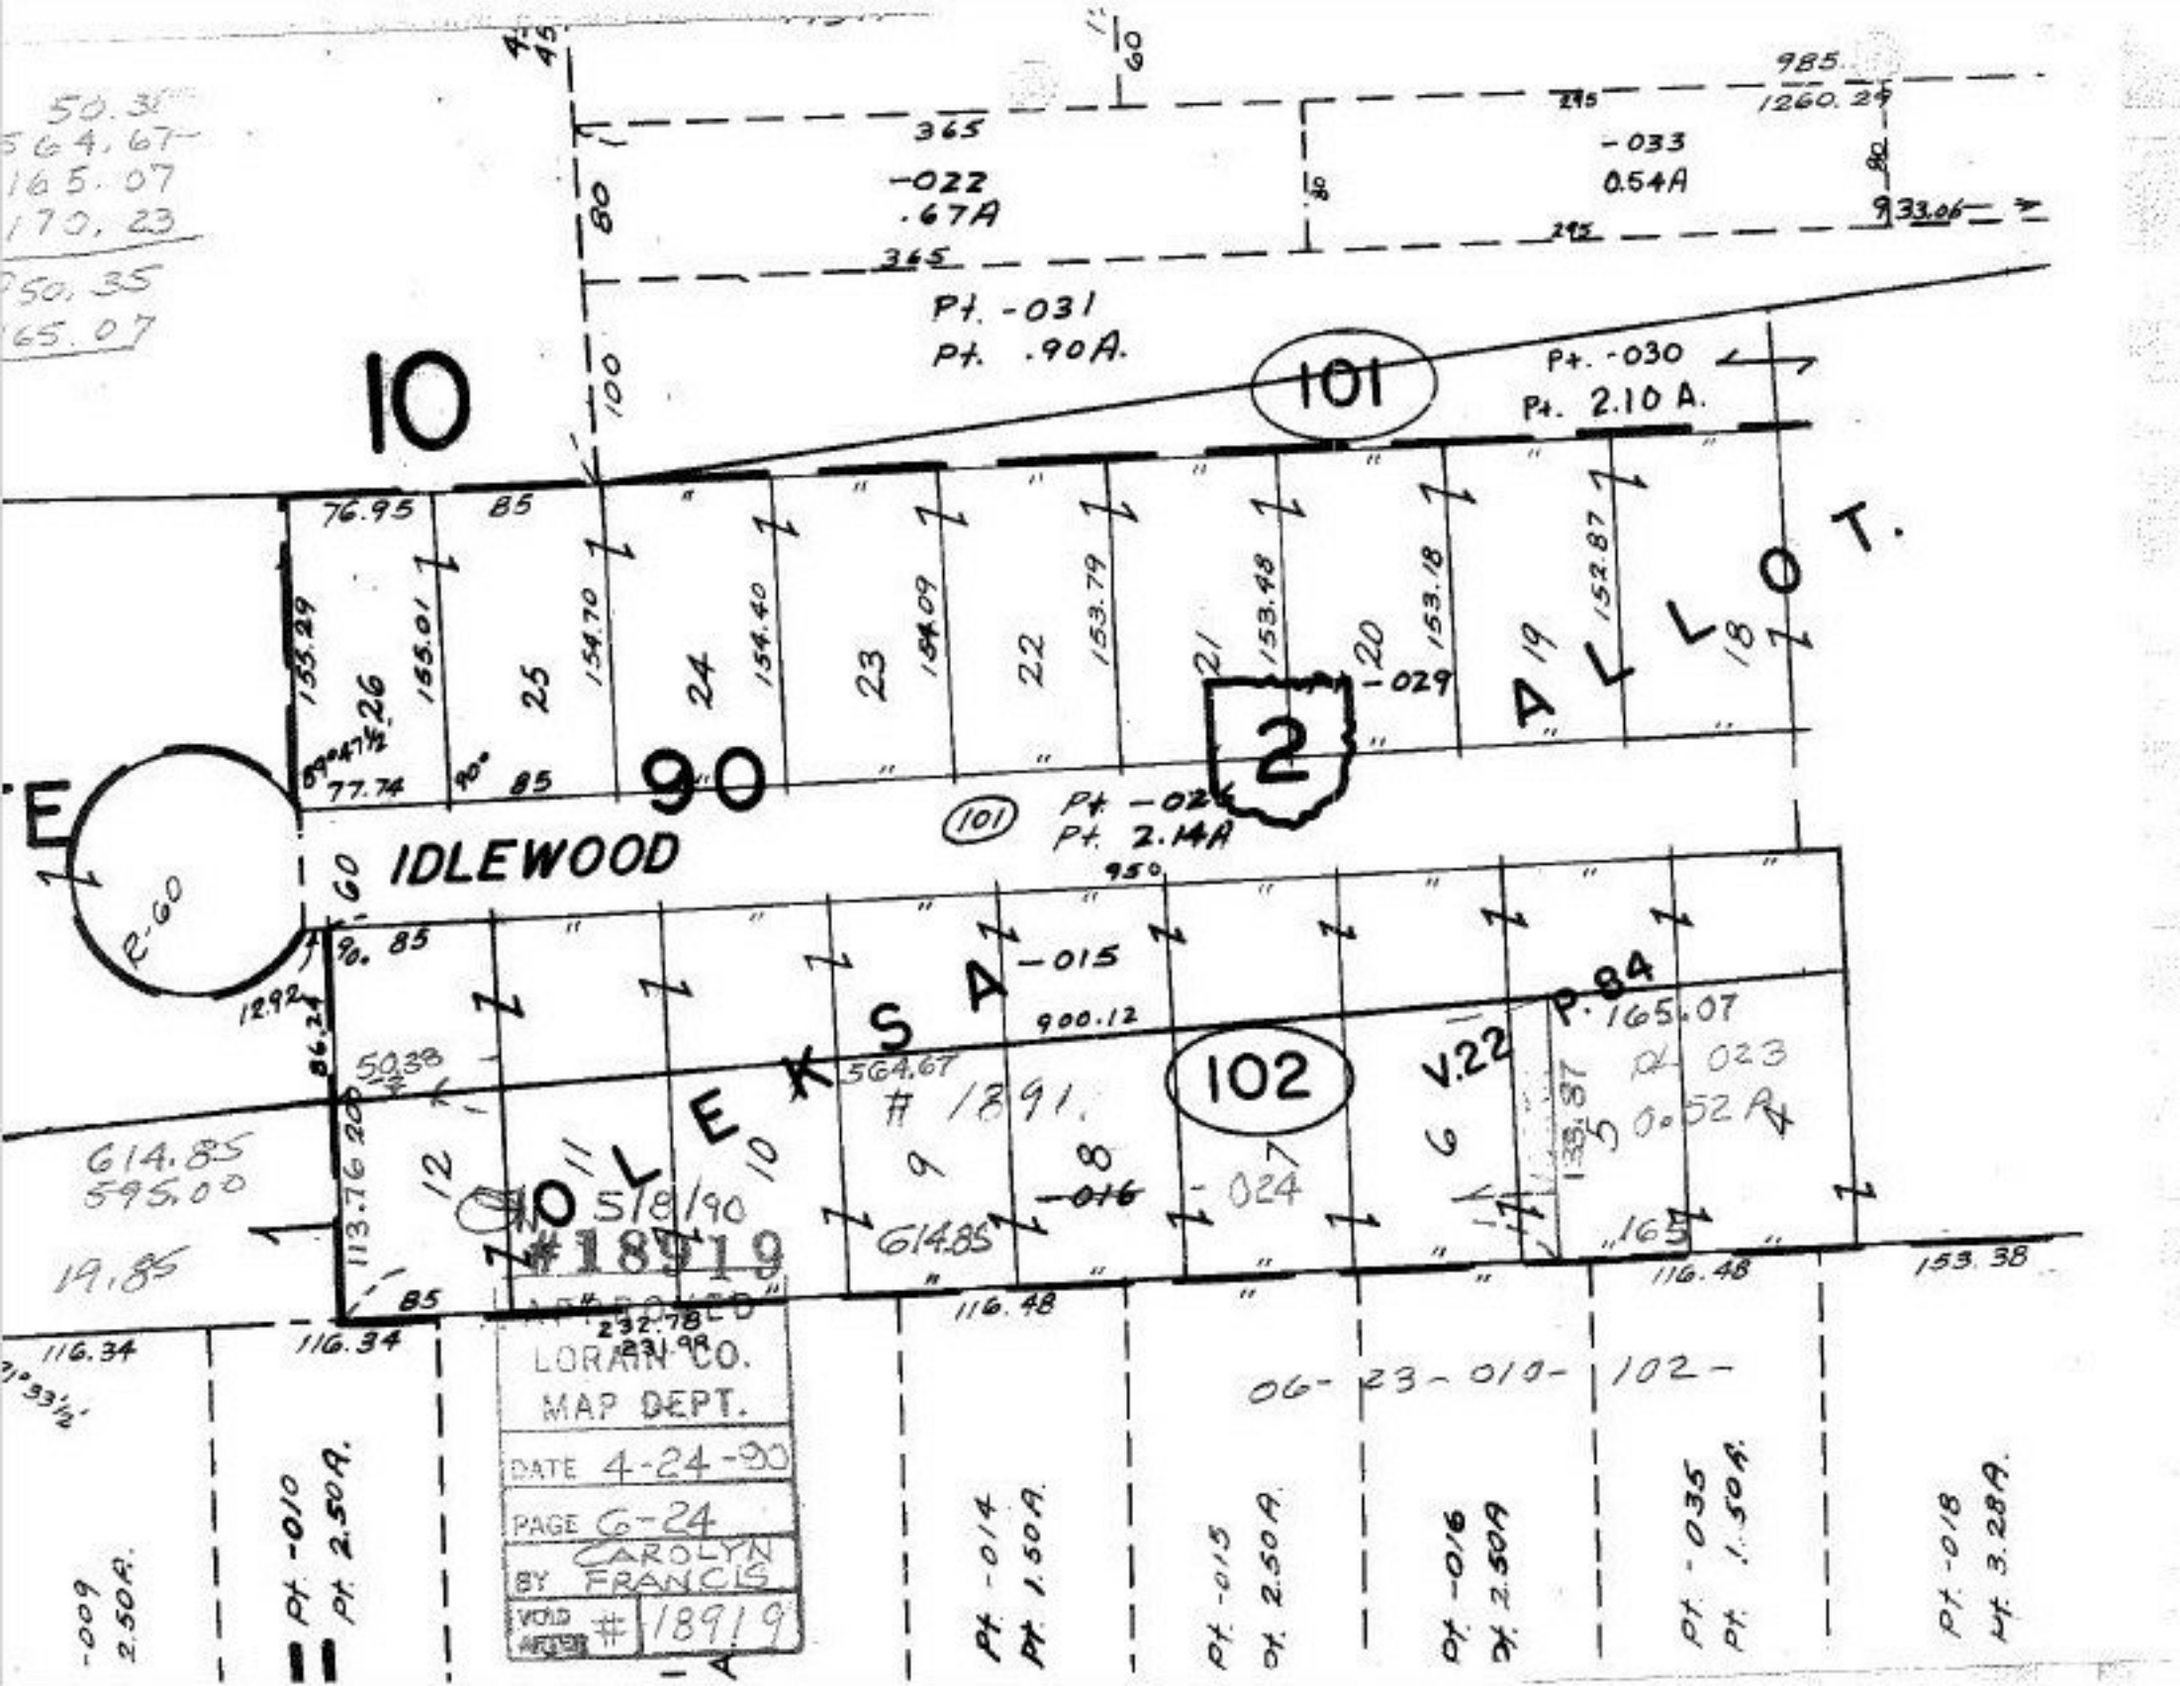

APPROVED
LORAIN CO.
MAP DEPT.
DATE 4-24-90
PAGE 6-24
BY CAROLYN FRANCIS
VOID AFTER # 18919