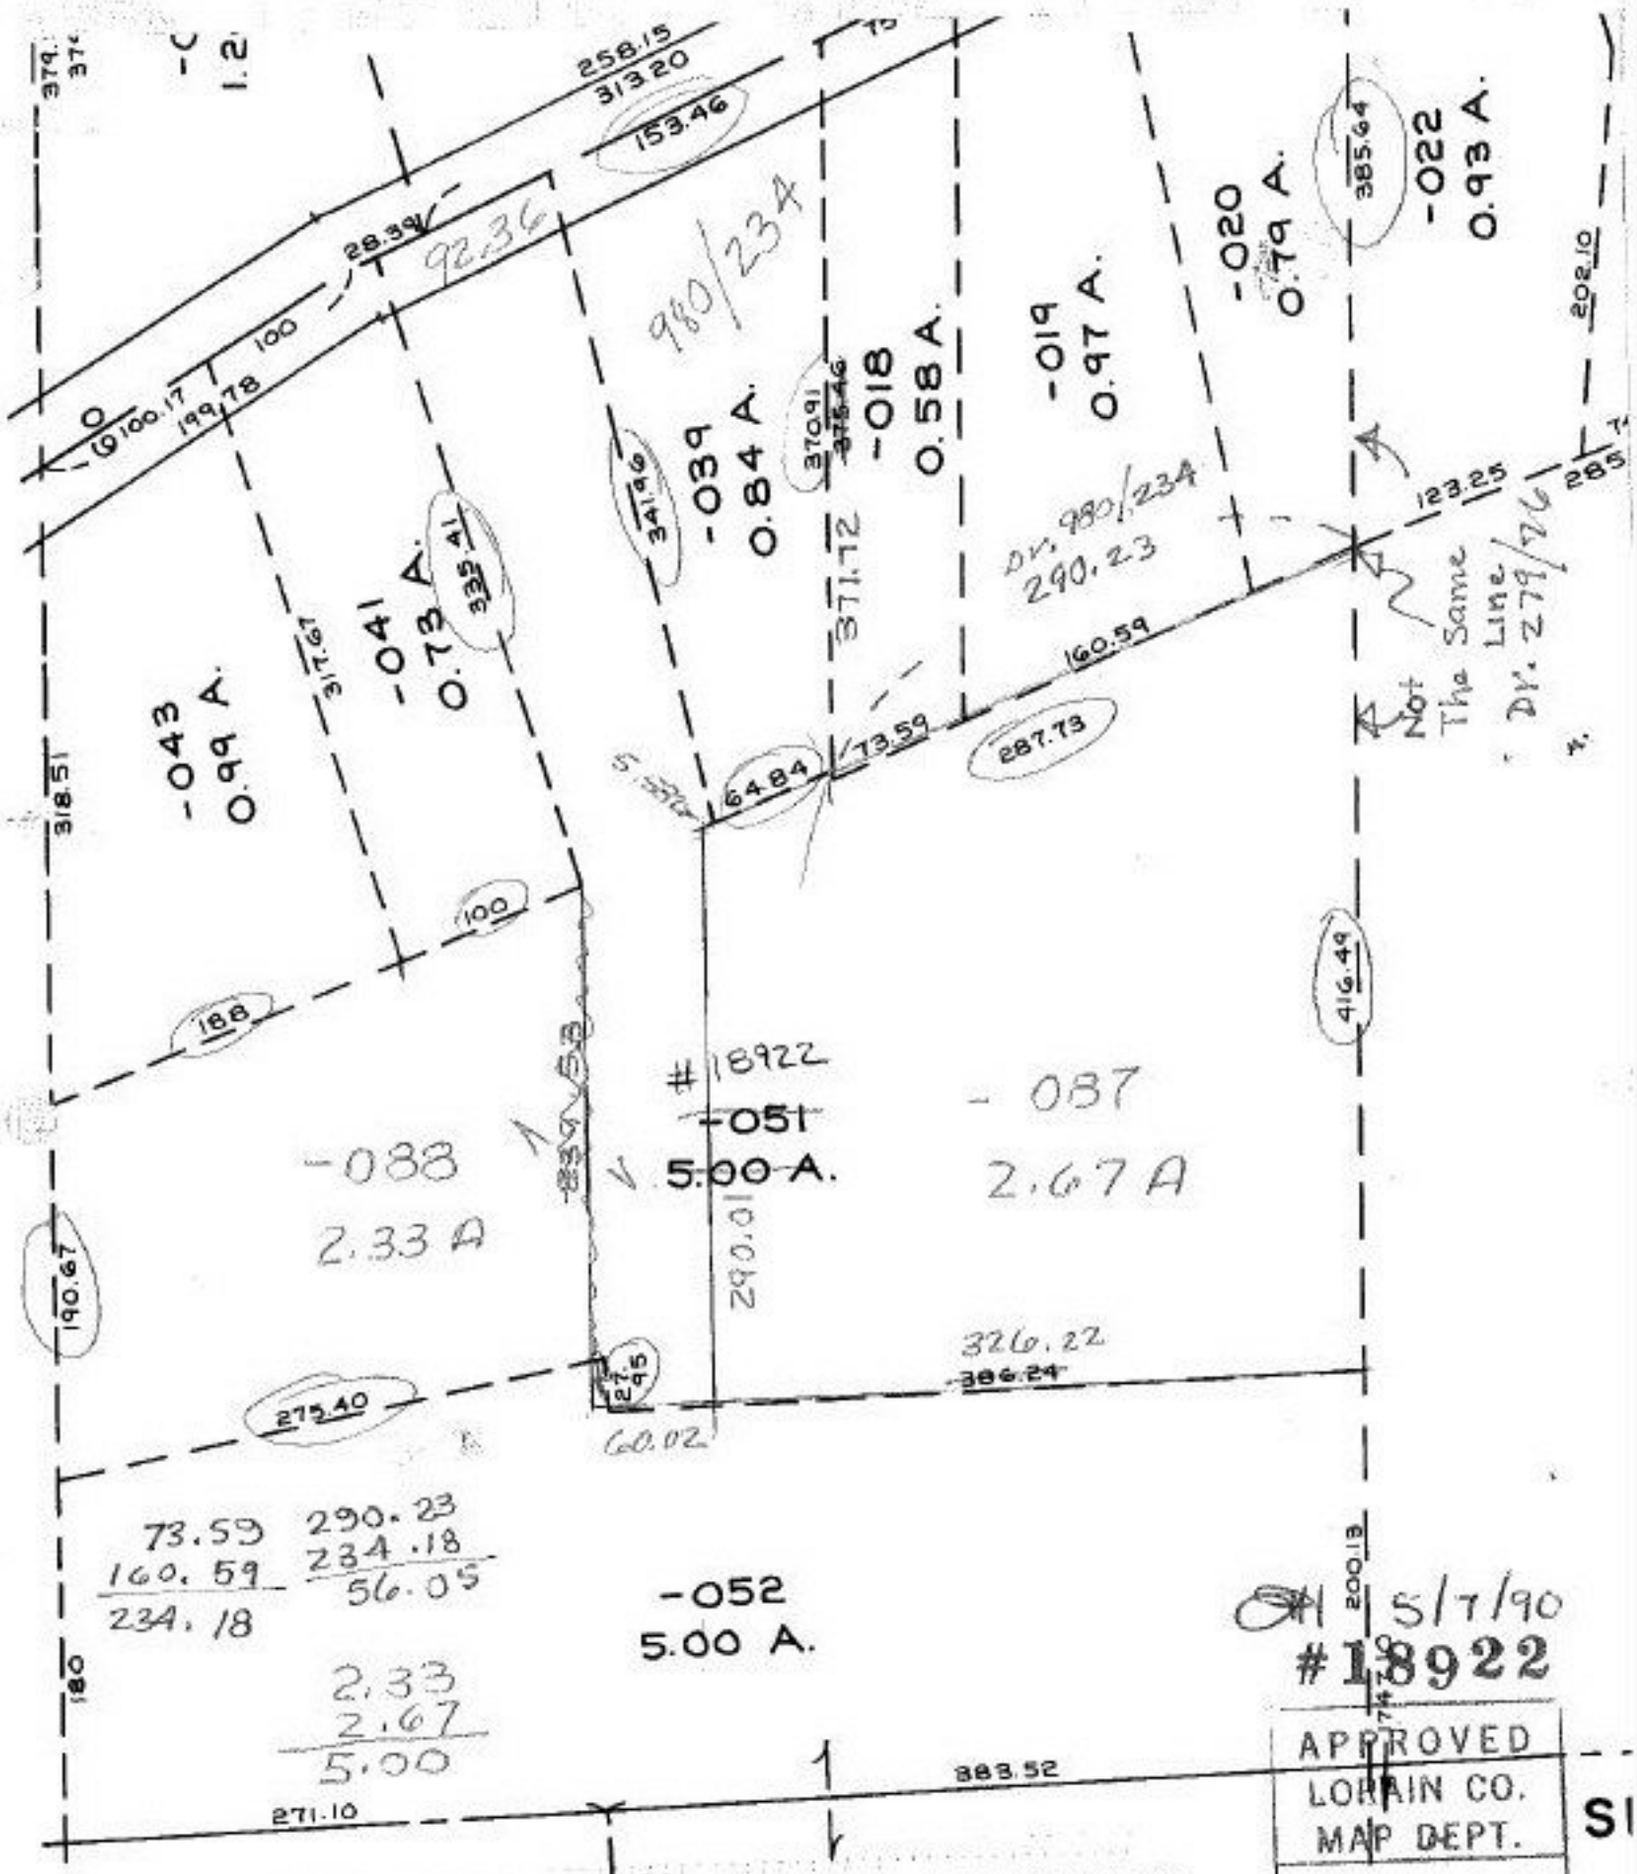


5/7/90
#18922

APPROVED
LORAIN CO.
MAP DEPT.

DATE	4-25-90
PAGE	7-00-047D
BY	CAROLYN FRANCIS
VOID AFTER	# 18922