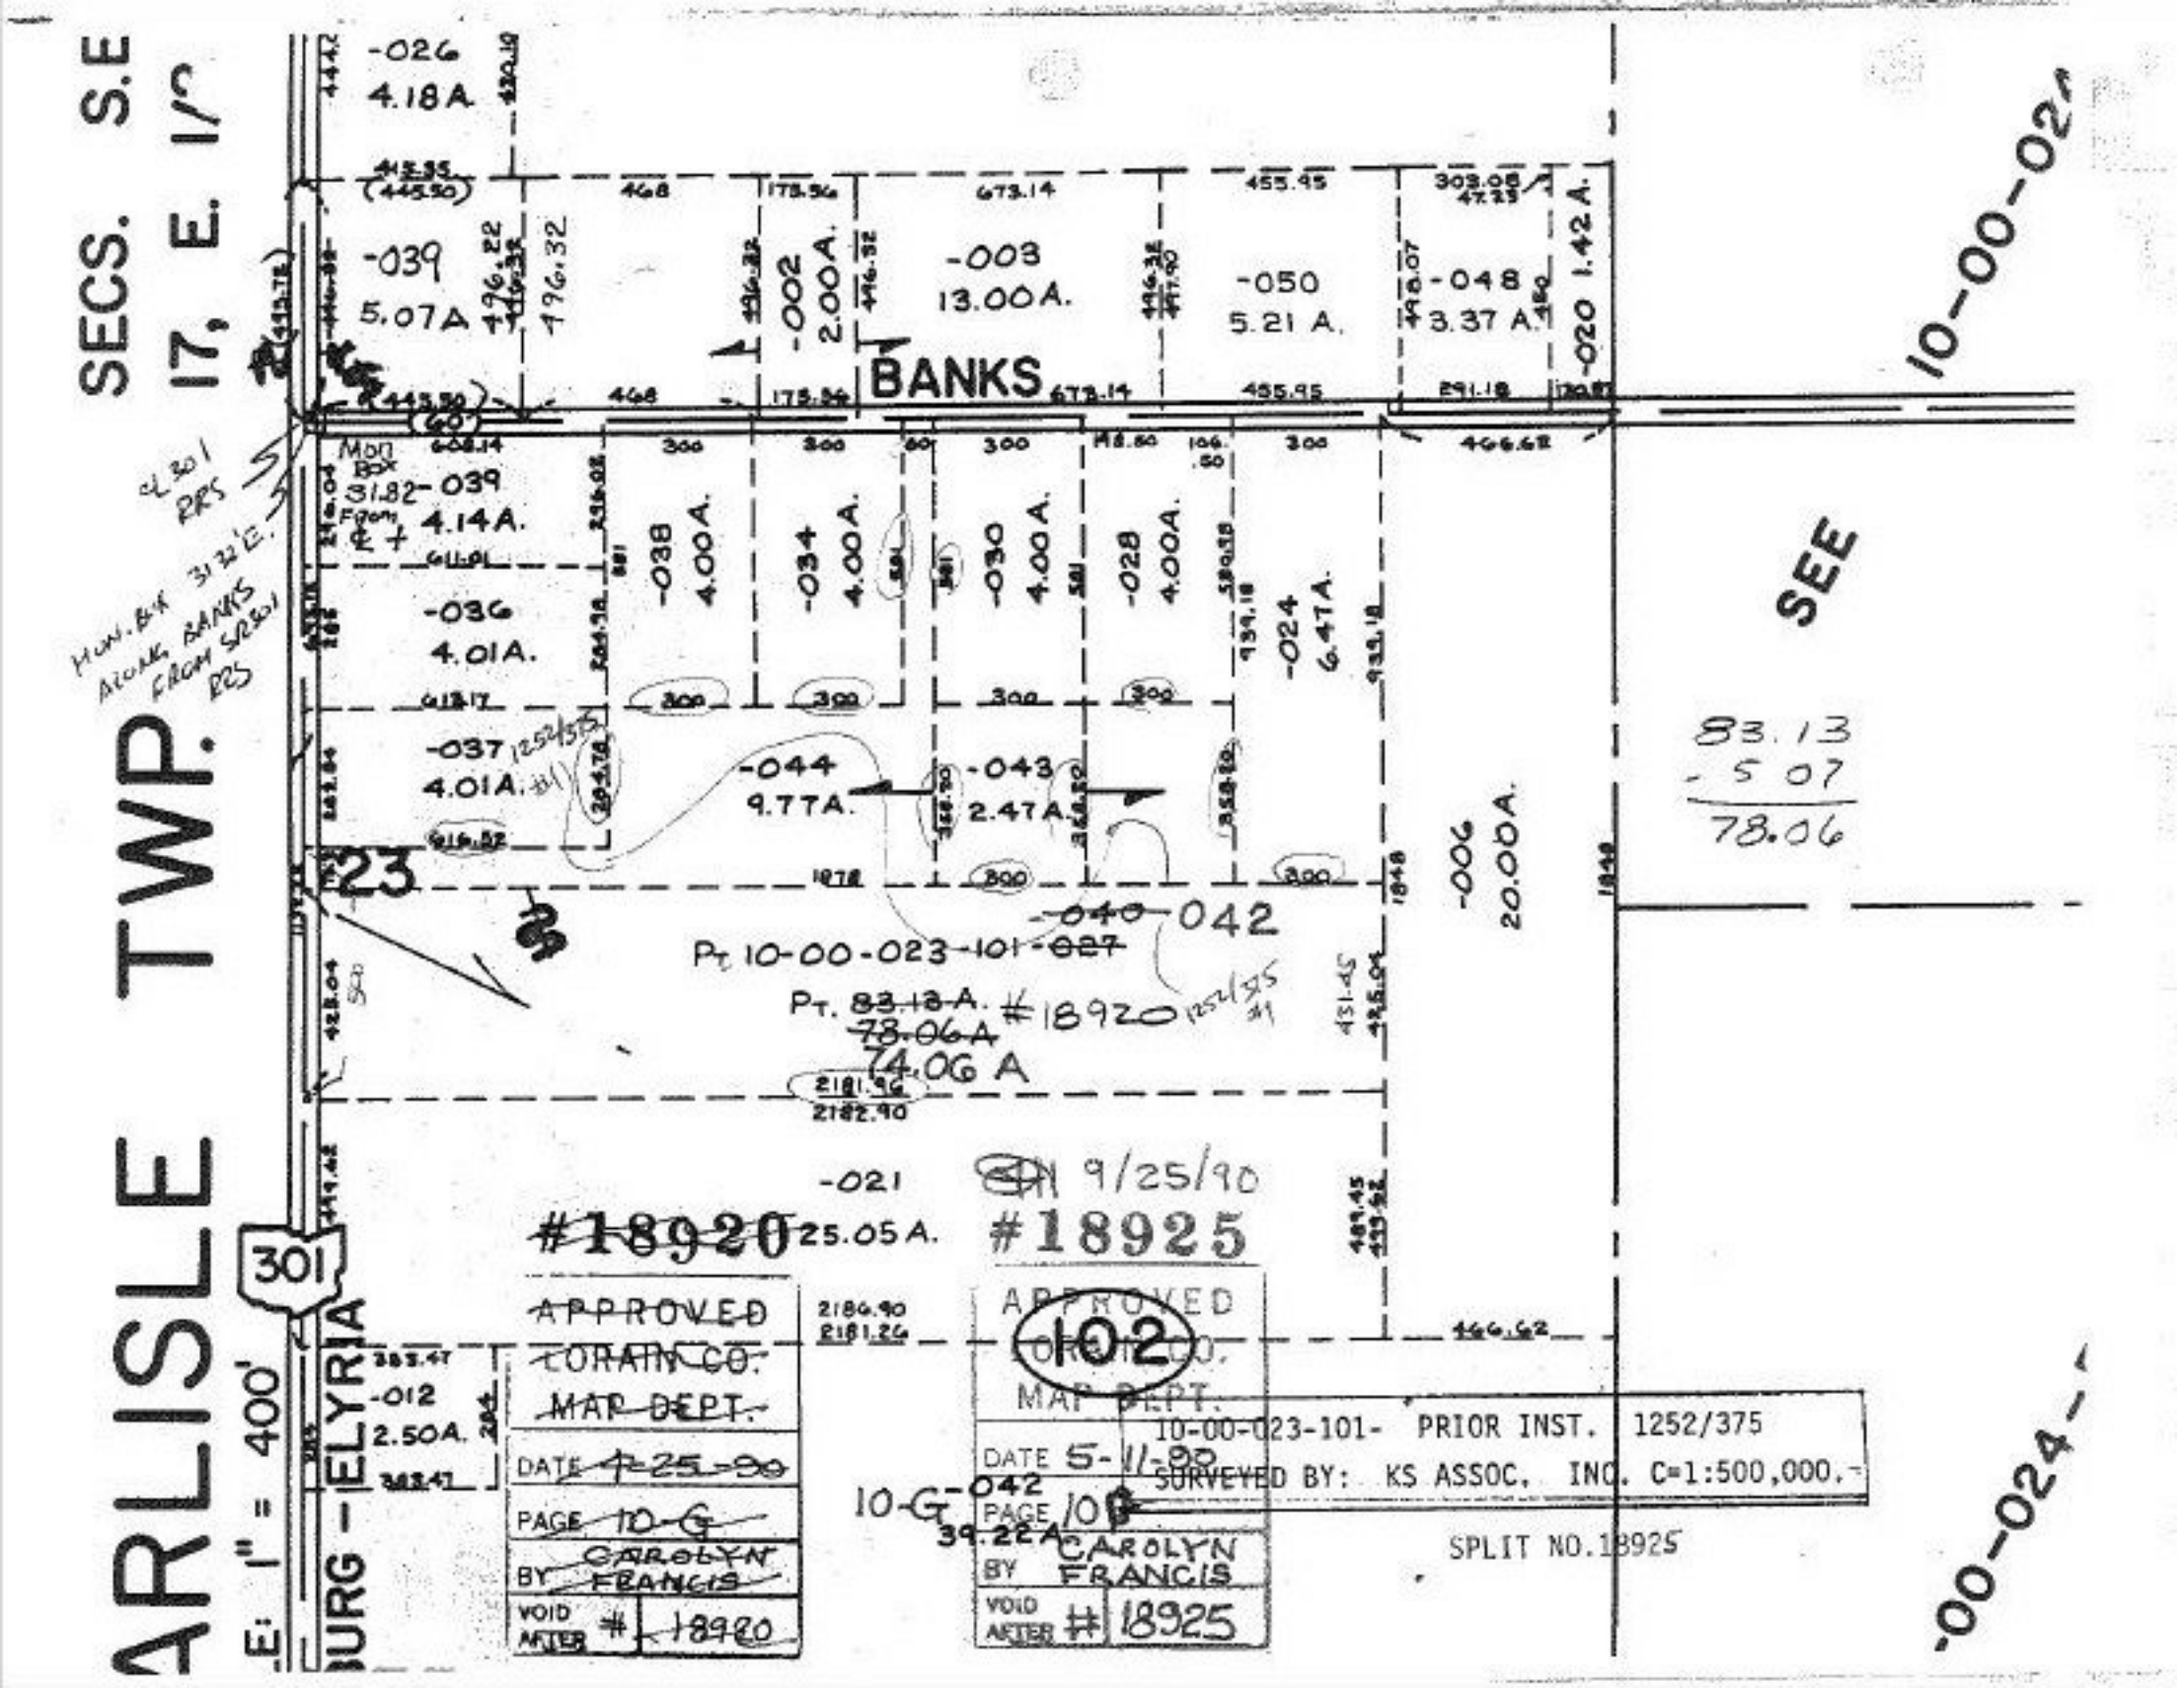

SECS. S.E
17, E. 1/2
ARLISLE TWP.
E: 1" = 400'
BURG - ELYRIA
301
BANKS
-026
4.18A.
-039
5.07A
-002
2.00A.
-003
13.00A.
-050
5.21 A.
-048
3.37 A.
-020 1.42 A.
10-00-024
Mon Box 31.82 From ℄ +
-039
4.14A.
-036
4.01A.
-037
4.01A.
-038
4.00A.
-034
4.00A.
-030
4.00A.
-028
4.00A.
-024
6.47A.
-044
9.77A.
-043
2.47A.
-006
20.00A.
SEE
83.13
- 5.07
78.06
23
-040 042
Pt. 10-00-023-101-027
Pt. 83.13 A. #18920
78.06A
74.06 A
-021
25.05 A.
#18920
#18925
9/25/90
APPROVED
LORAIN CO.
MAP DEPT.
DATE 4-25-90
PAGE 10-G
BY CAROLYN FRANCIS
VOID AFTER # 18920
APPROVED
LORAIN CO.
MAP DEPT.
DATE 5-11-90
PAGE 10
BY CAROLYN FRANCIS
VOID AFTER # 18925
10-G
-042
39.22A
102
10-00-023-101- PRIOR INST. 1252/375
SURVEYED BY: KS ASSOC. INC. C=1:500,000.
SPLIT NO.18925
-00-024-