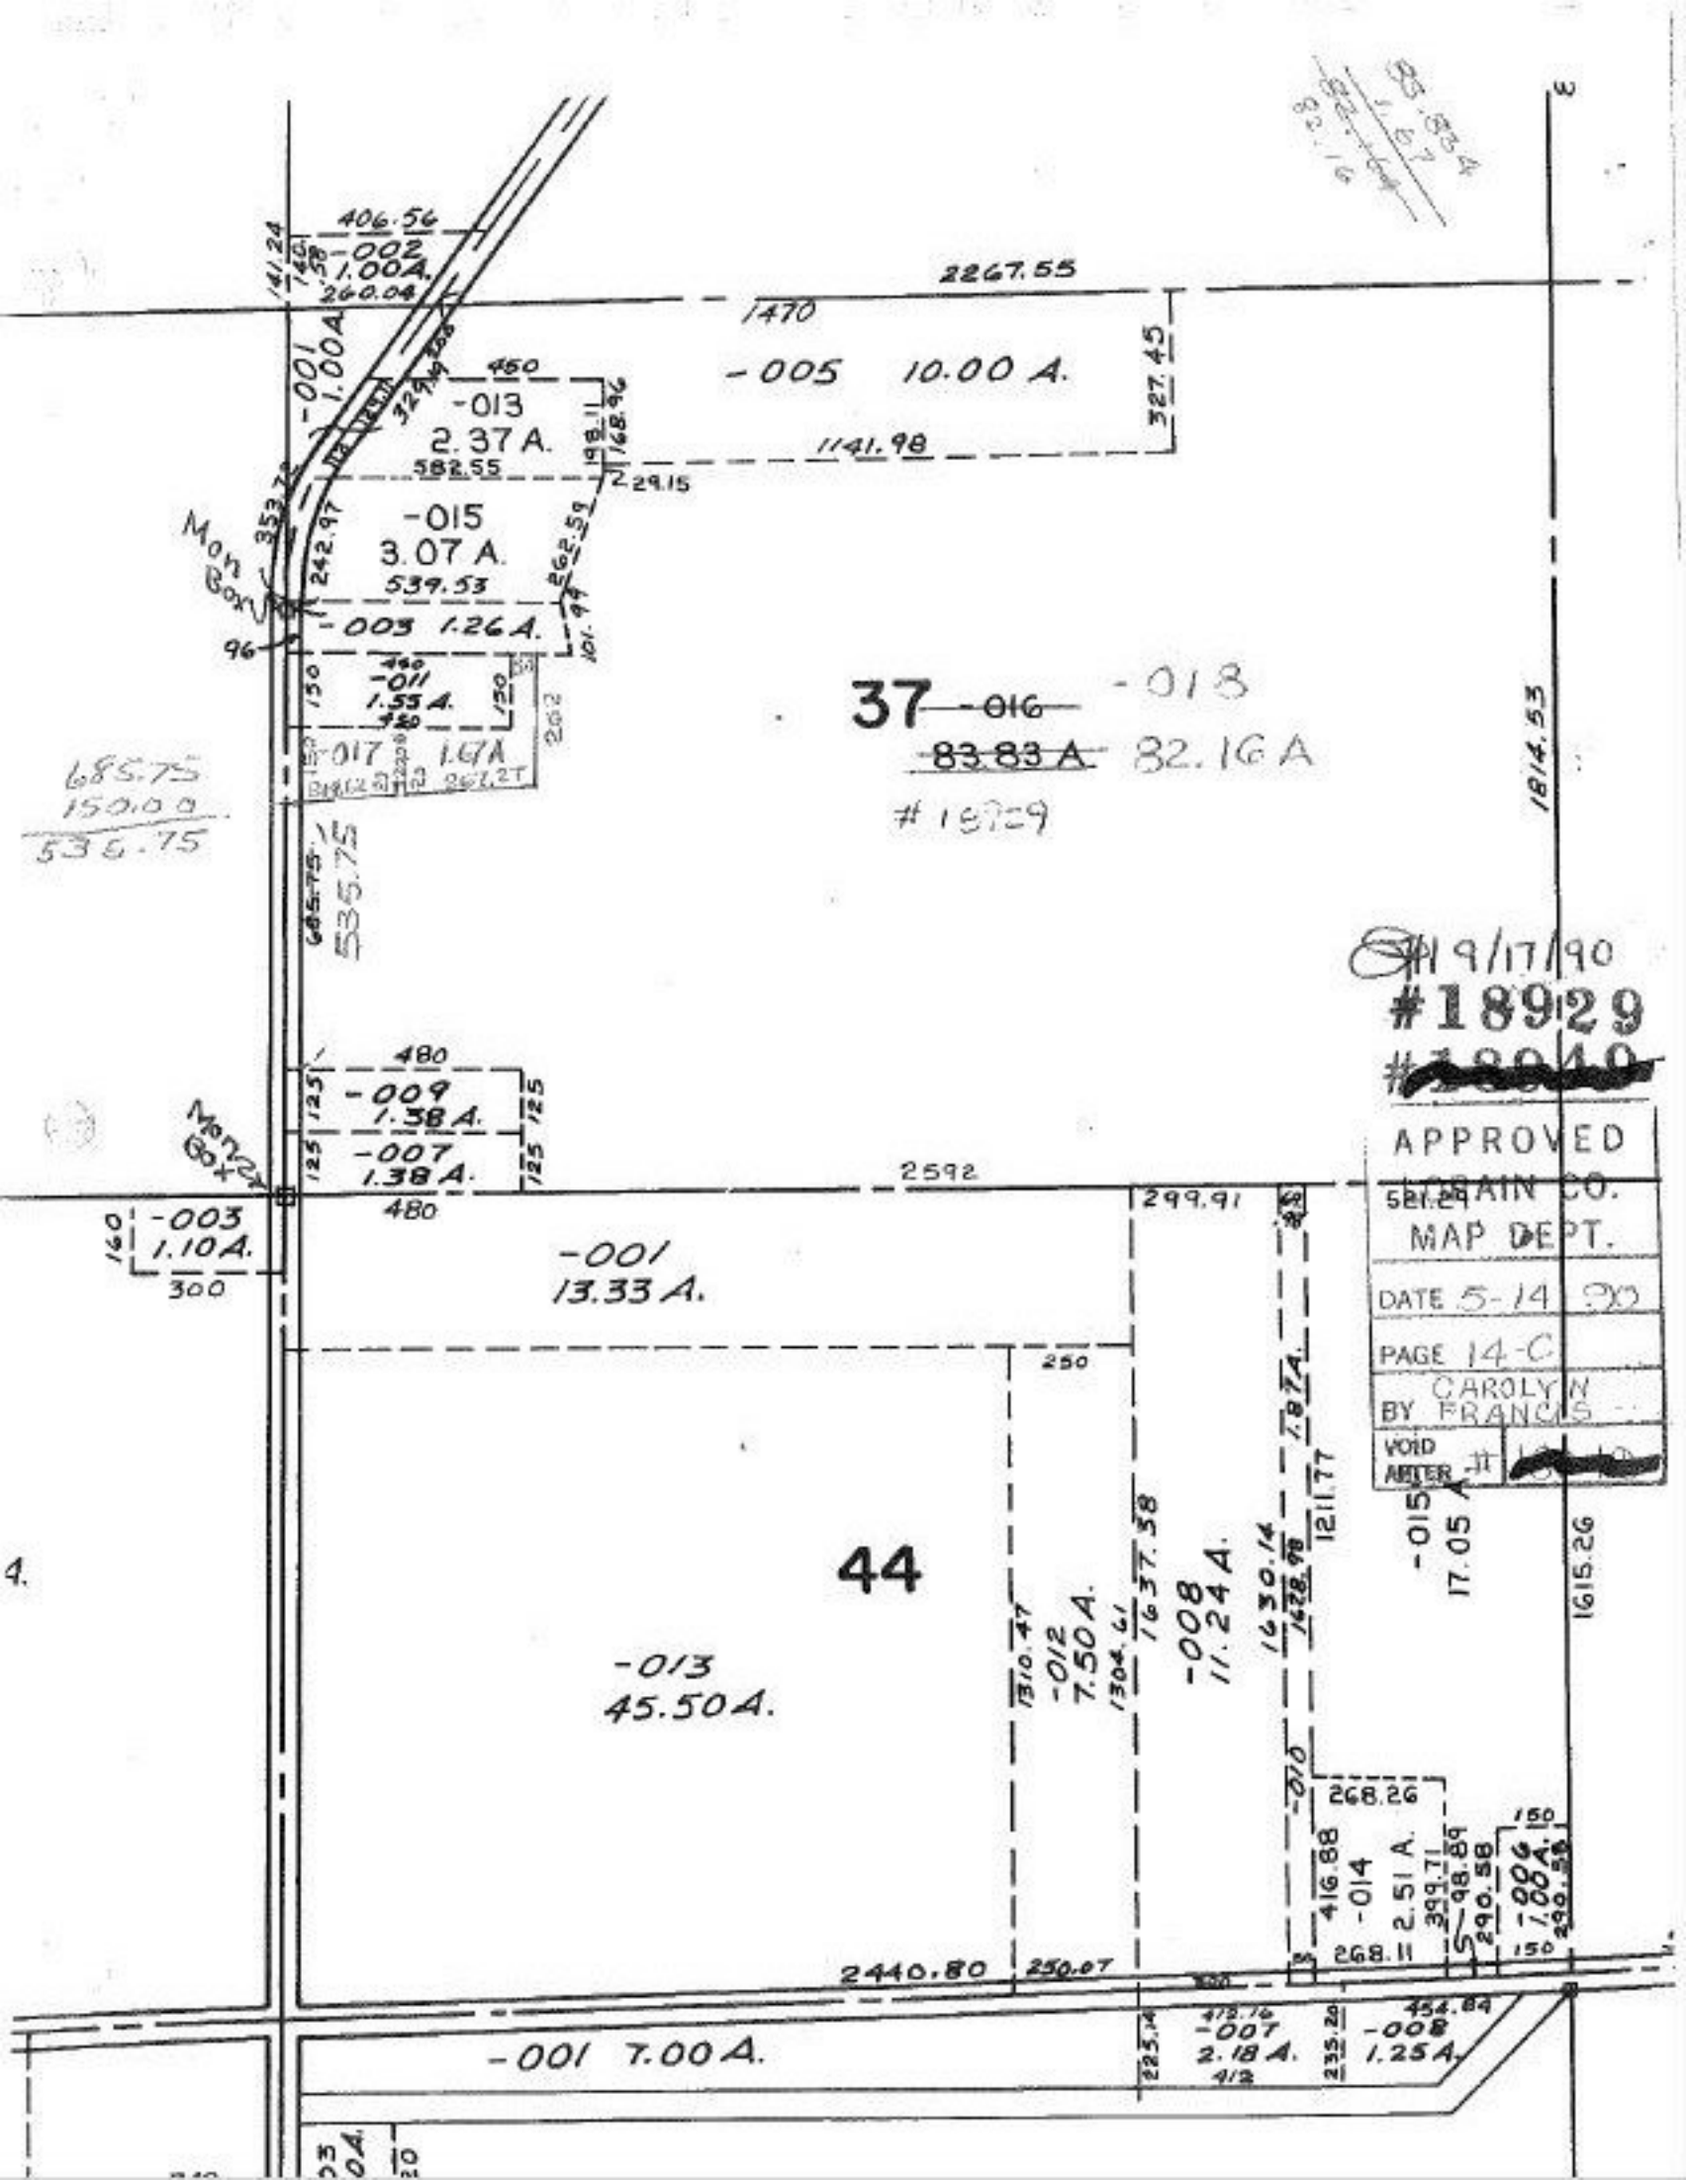
406.56
-002
1.00A.
260.04
2267.55
1470
-005 10.00 A.
327.45
-001
1.00A.
450
-013
2.37 A.
582.55
198.11
168.96
1141.98
29.15
-015
3.07 A.
539.53
-003 1.26A.
242.97
262.59
101.94
353.72
96
450
-011
1.55 A.
150
150
262
-017 1.67A
267.27
685.75
150.00
536.75
535.75
37 -016 -018
83.83 A 82.16 A
#18929
1814.53
9/17/90
#18929
APPROVED
CRAIN CO.
MAP DEPT.
DATE 5-14 90
PAGE 14-C
BY CAROLYN FRANCIS
VOID AFTER
480
-009
1.38 A.
-007
1.38 A.
125
125
125
125
480
2592
299.91
160
-003
1.10A.
300
-001
13.33 A.
250
44
-013
45.50A.
1310.47
-012
7.50A.
1304.61
1637.58
-008
11.24A.
1630.14
1628.98
1211.77
-010
7.82A.
-015
17.05 A.
1615.26
268.26
416.88
-014
2.51 A.
268.11
399.71
98.89
290.58
-006
1.00A.
290.58
150
150
2440.80
250.07
-001 7.00A.
223.14
478.14
-007
2.18 A.
4/2
235.20
454.84
-008
1.25A.