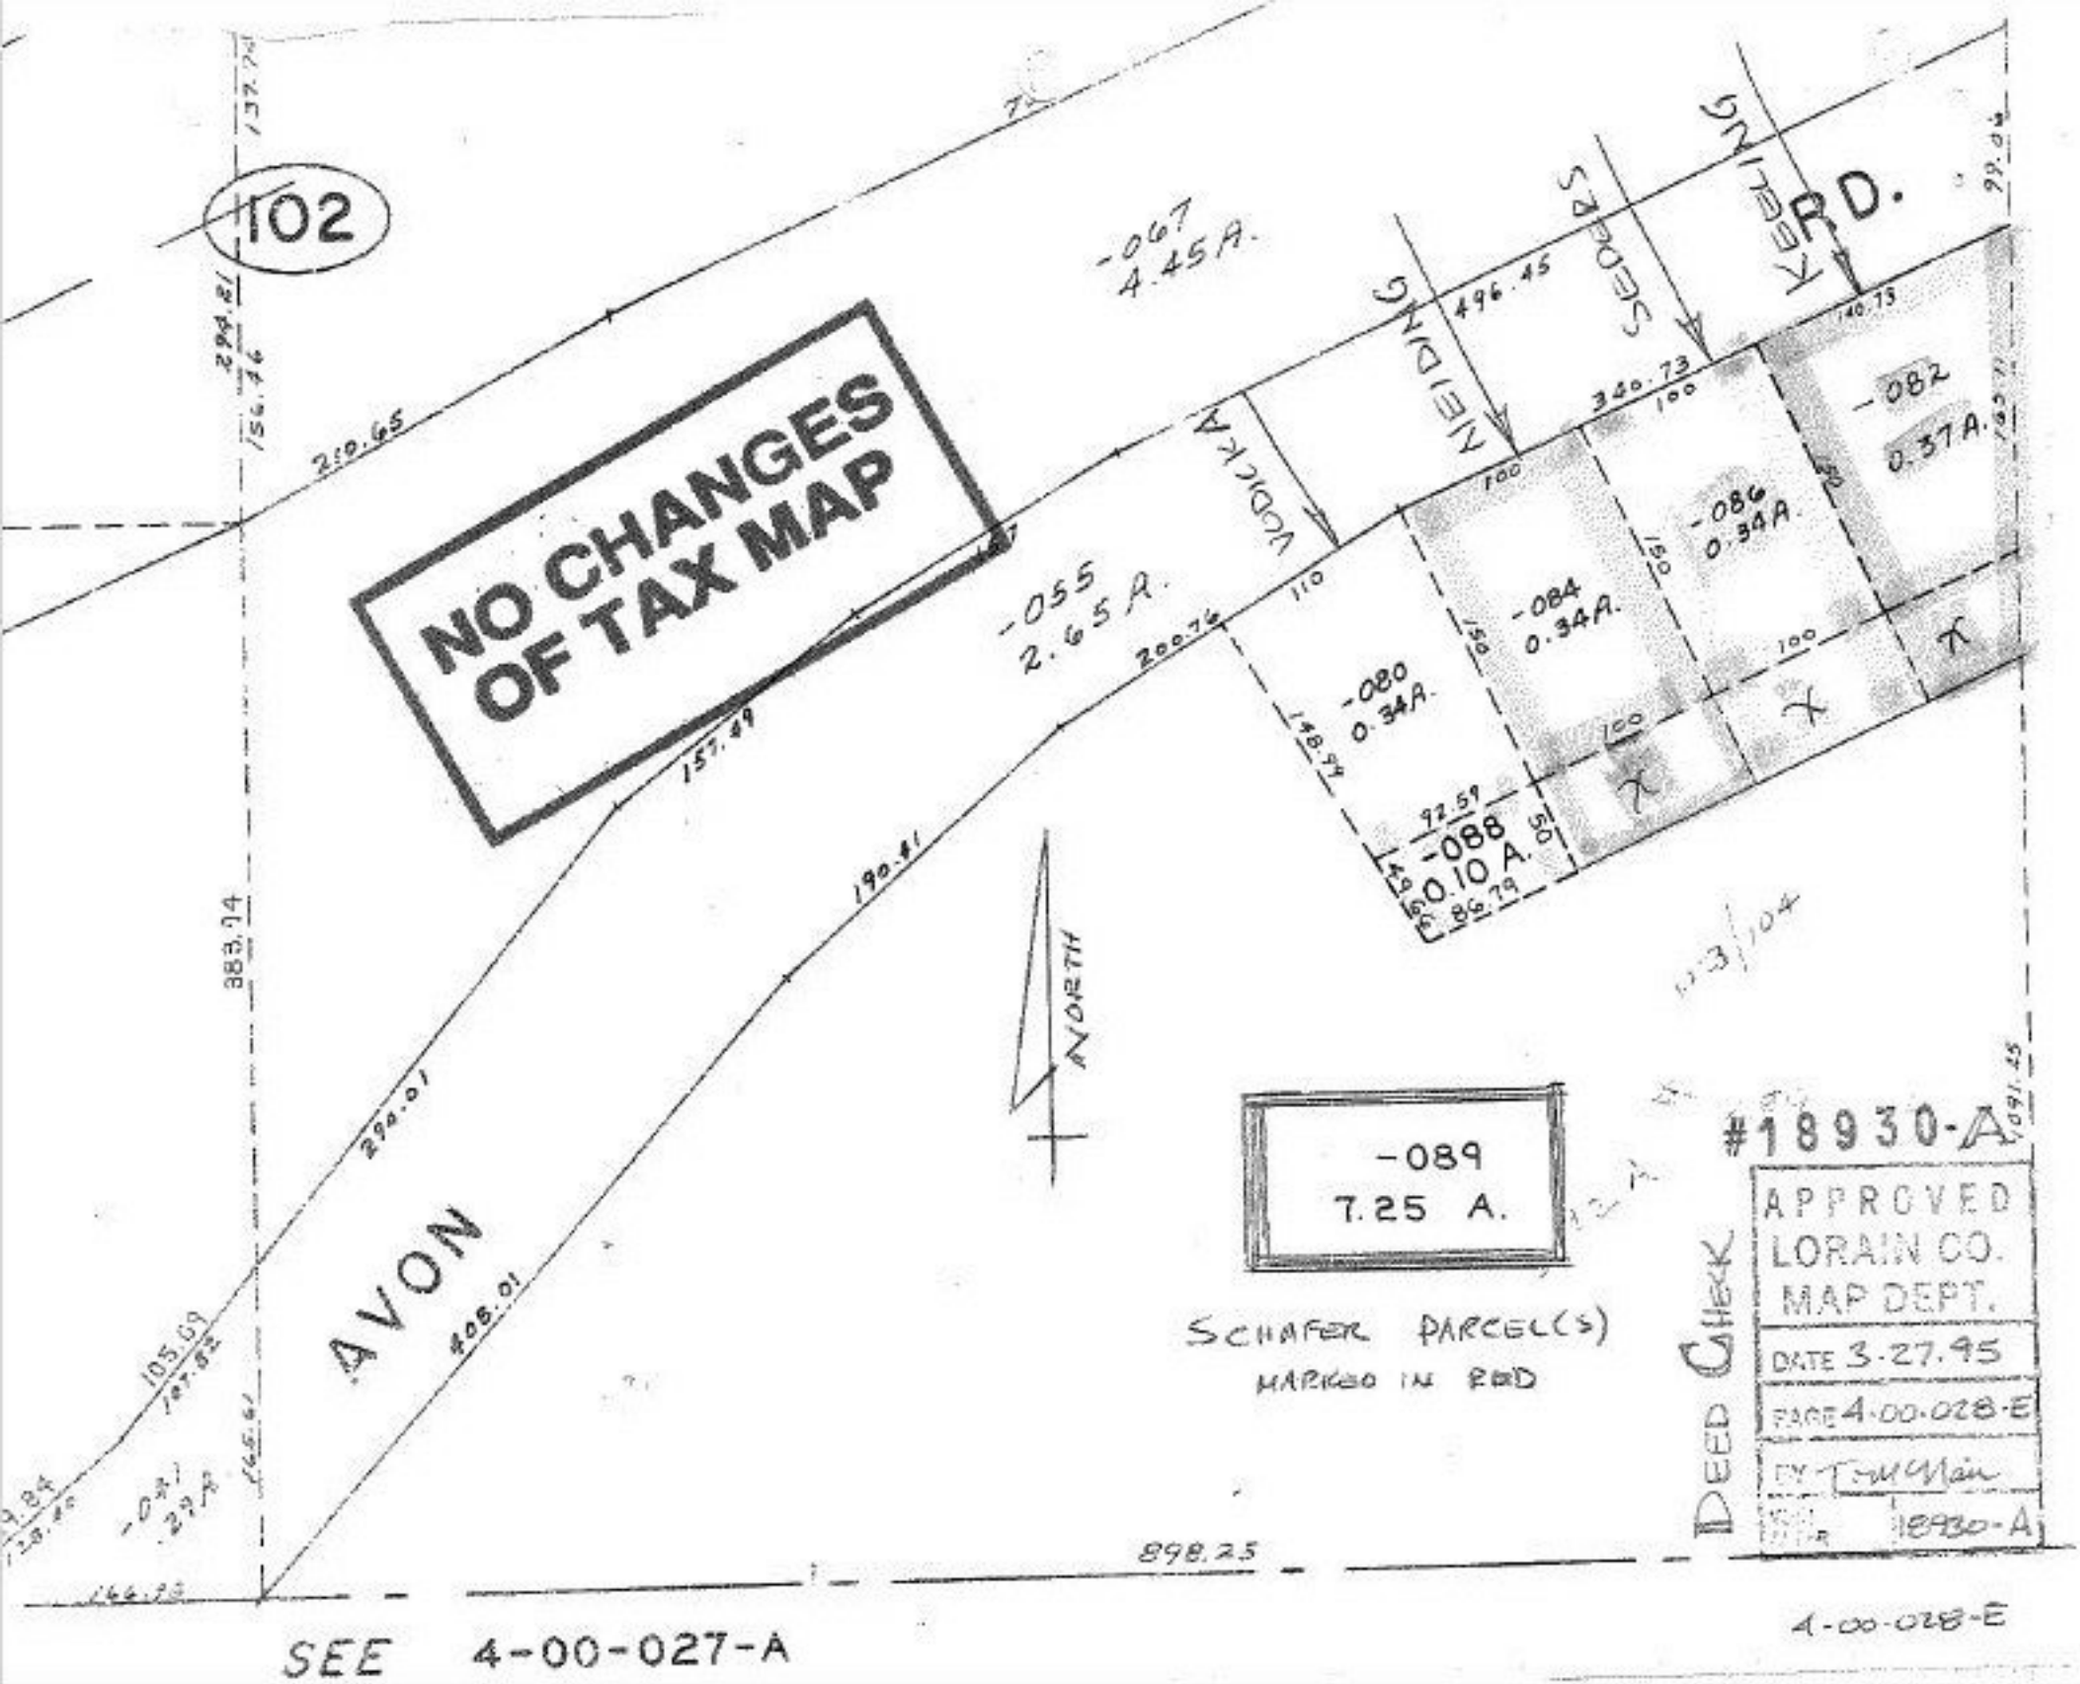
102
NO CHANGES OF TAX MAP
-067
4.45 A.
-055
2.65 A.
-080
0.34A.
-084
0.34A.
-086
0.34A.
-082
0.37A.
-088
0.10 A.
-089
7.25 A.
NORTH
AVON
SCHAFER PARCEL(S)
MARKED IN RED
DEED CHECK
#18930-A
APPROVED
LORAIN CO.
MAP DEPT.
DATE 3-27-95
PAGE 4-00-028-E
BY
18930-A
SEE 4-00-027-A
4-00-028-E