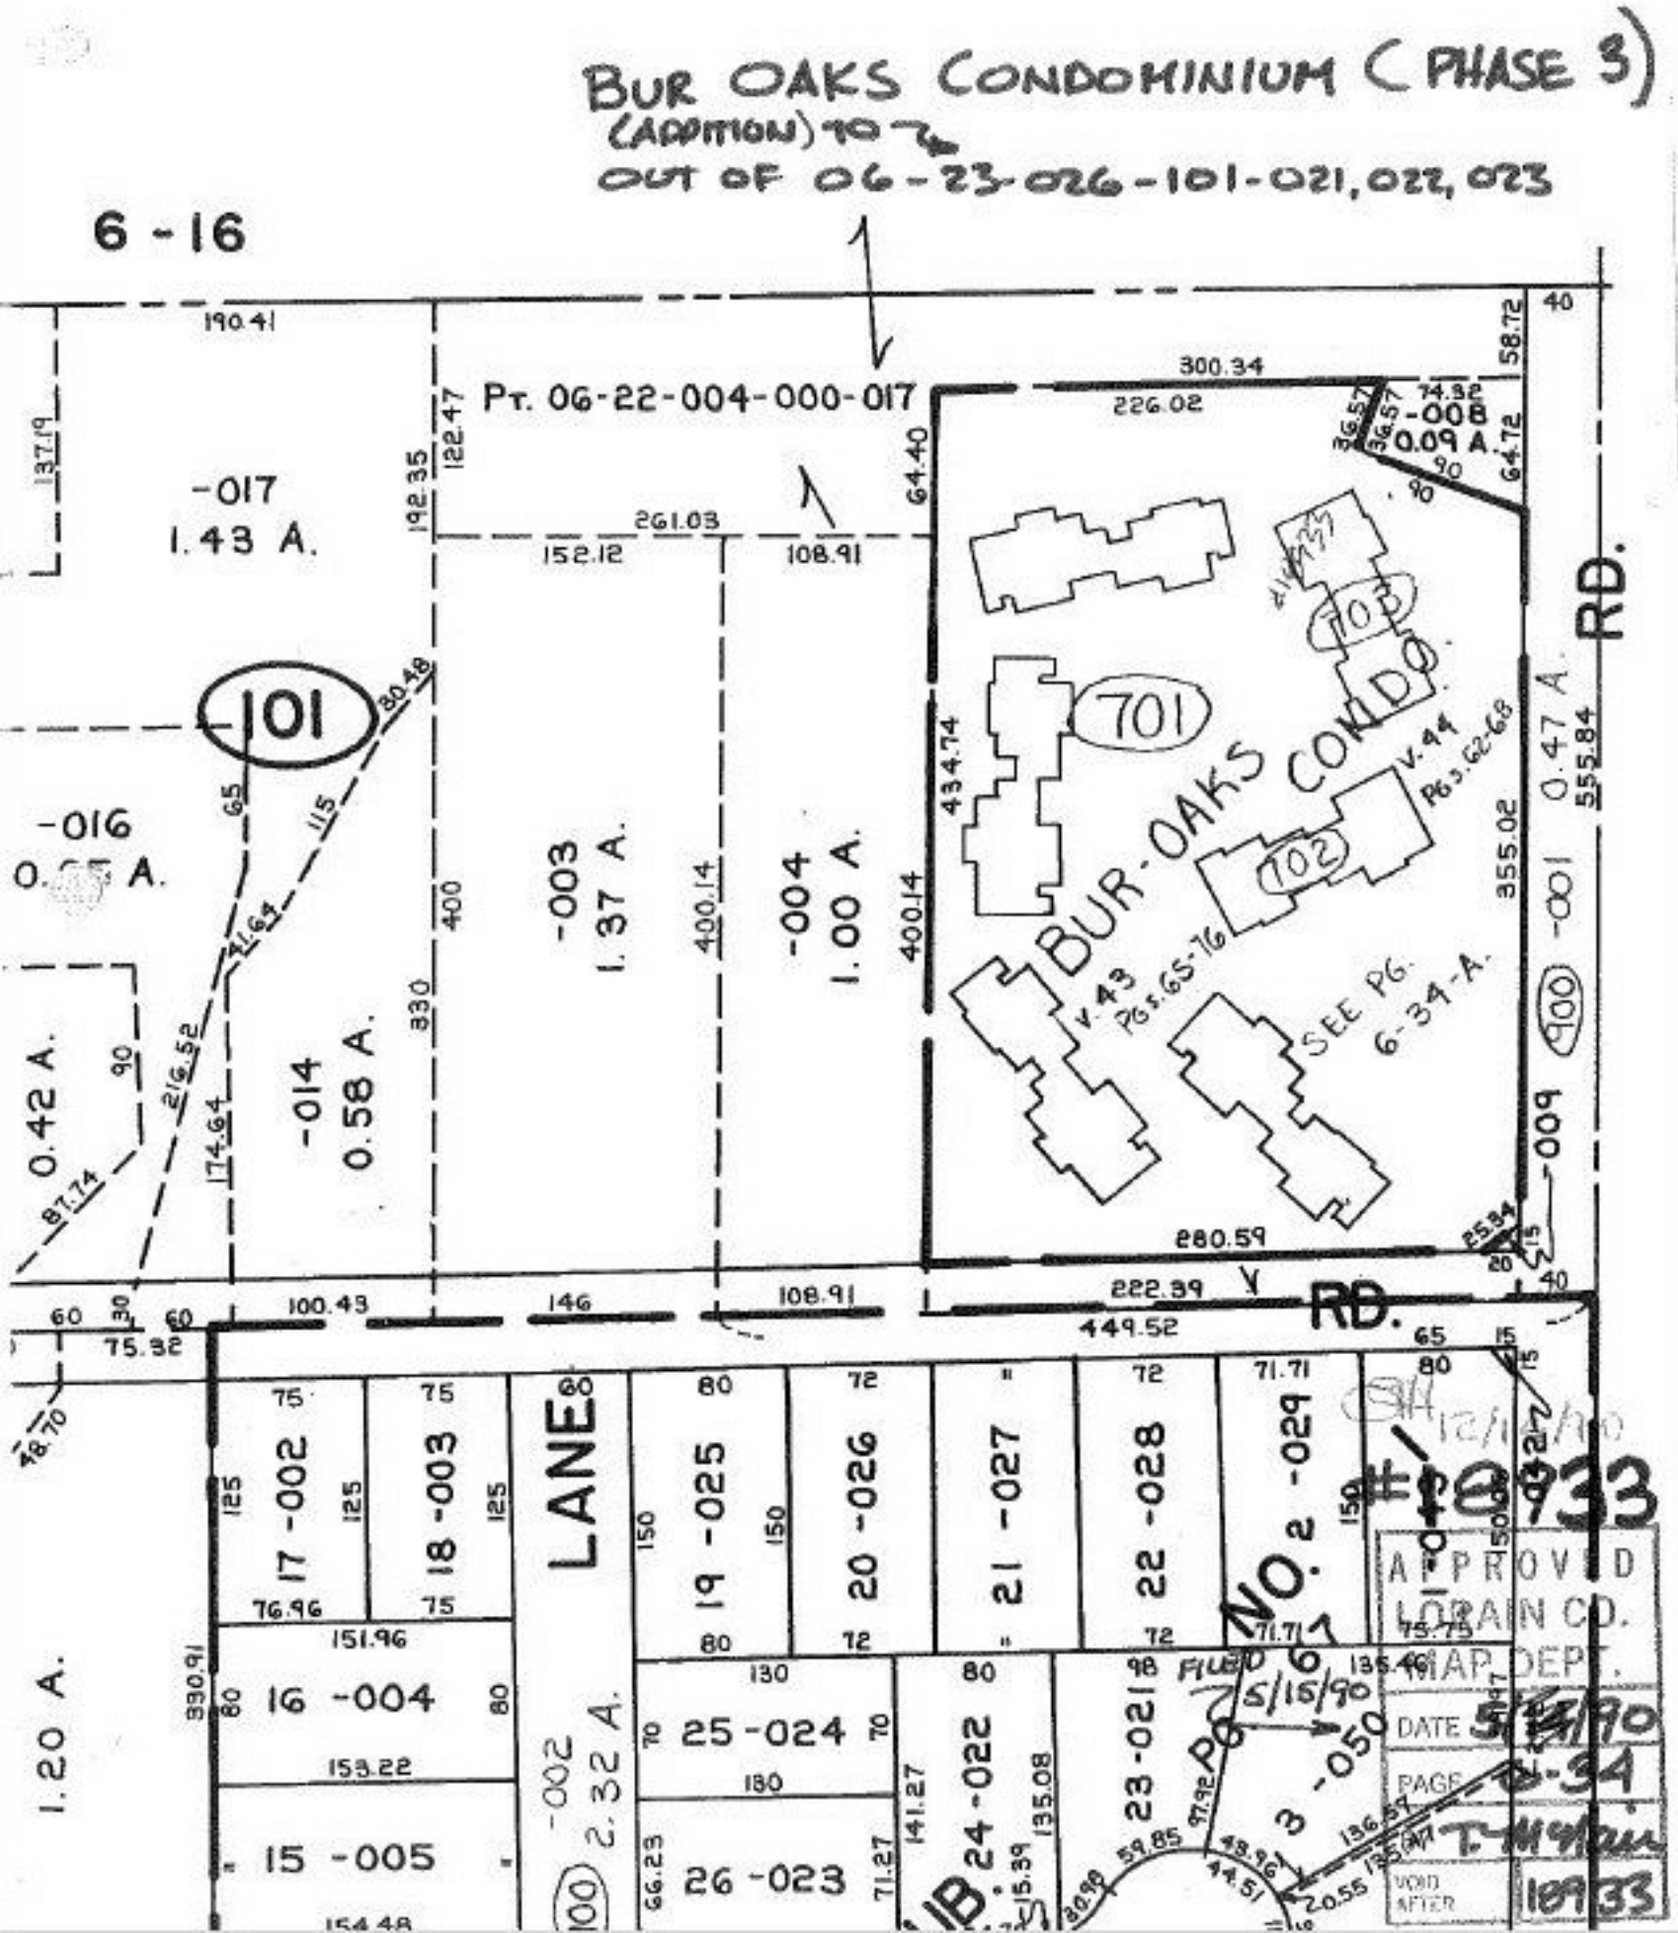
BUR OAKS CONDOMINIUM (PHASE 3)
(ADDITION) NO 2
OUT OF 06-23-026-101-021, 022, 023
6-16
Pt. 06-22-004-000-017
-017
1.43 A.
-016
0.42 A.
-014
0.58 A.
-003
1.37 A.
-004
1.00 A.
-001
0.47 A.
-008
0.09 A.
-009
101
701
702
703
BUR OAKS CONDO.
V. 44 PGS. 62-68
V. 43 PGS. 65-76
SEE PG. 6-34-A
RD.
LANE
17 -002
18 -003
19 -025
20 -026
21 -027
22 -028
23 -021
24 -022
25 -024
26 -023
16 -004
15 -005
2 -029
3 -050
1.20 A.
2.32 A.
#10933
APPROVED
LORAIN CO.
MAP DEPT.
DATE 5/15/90
PAGE 6-34
VOID AFTER