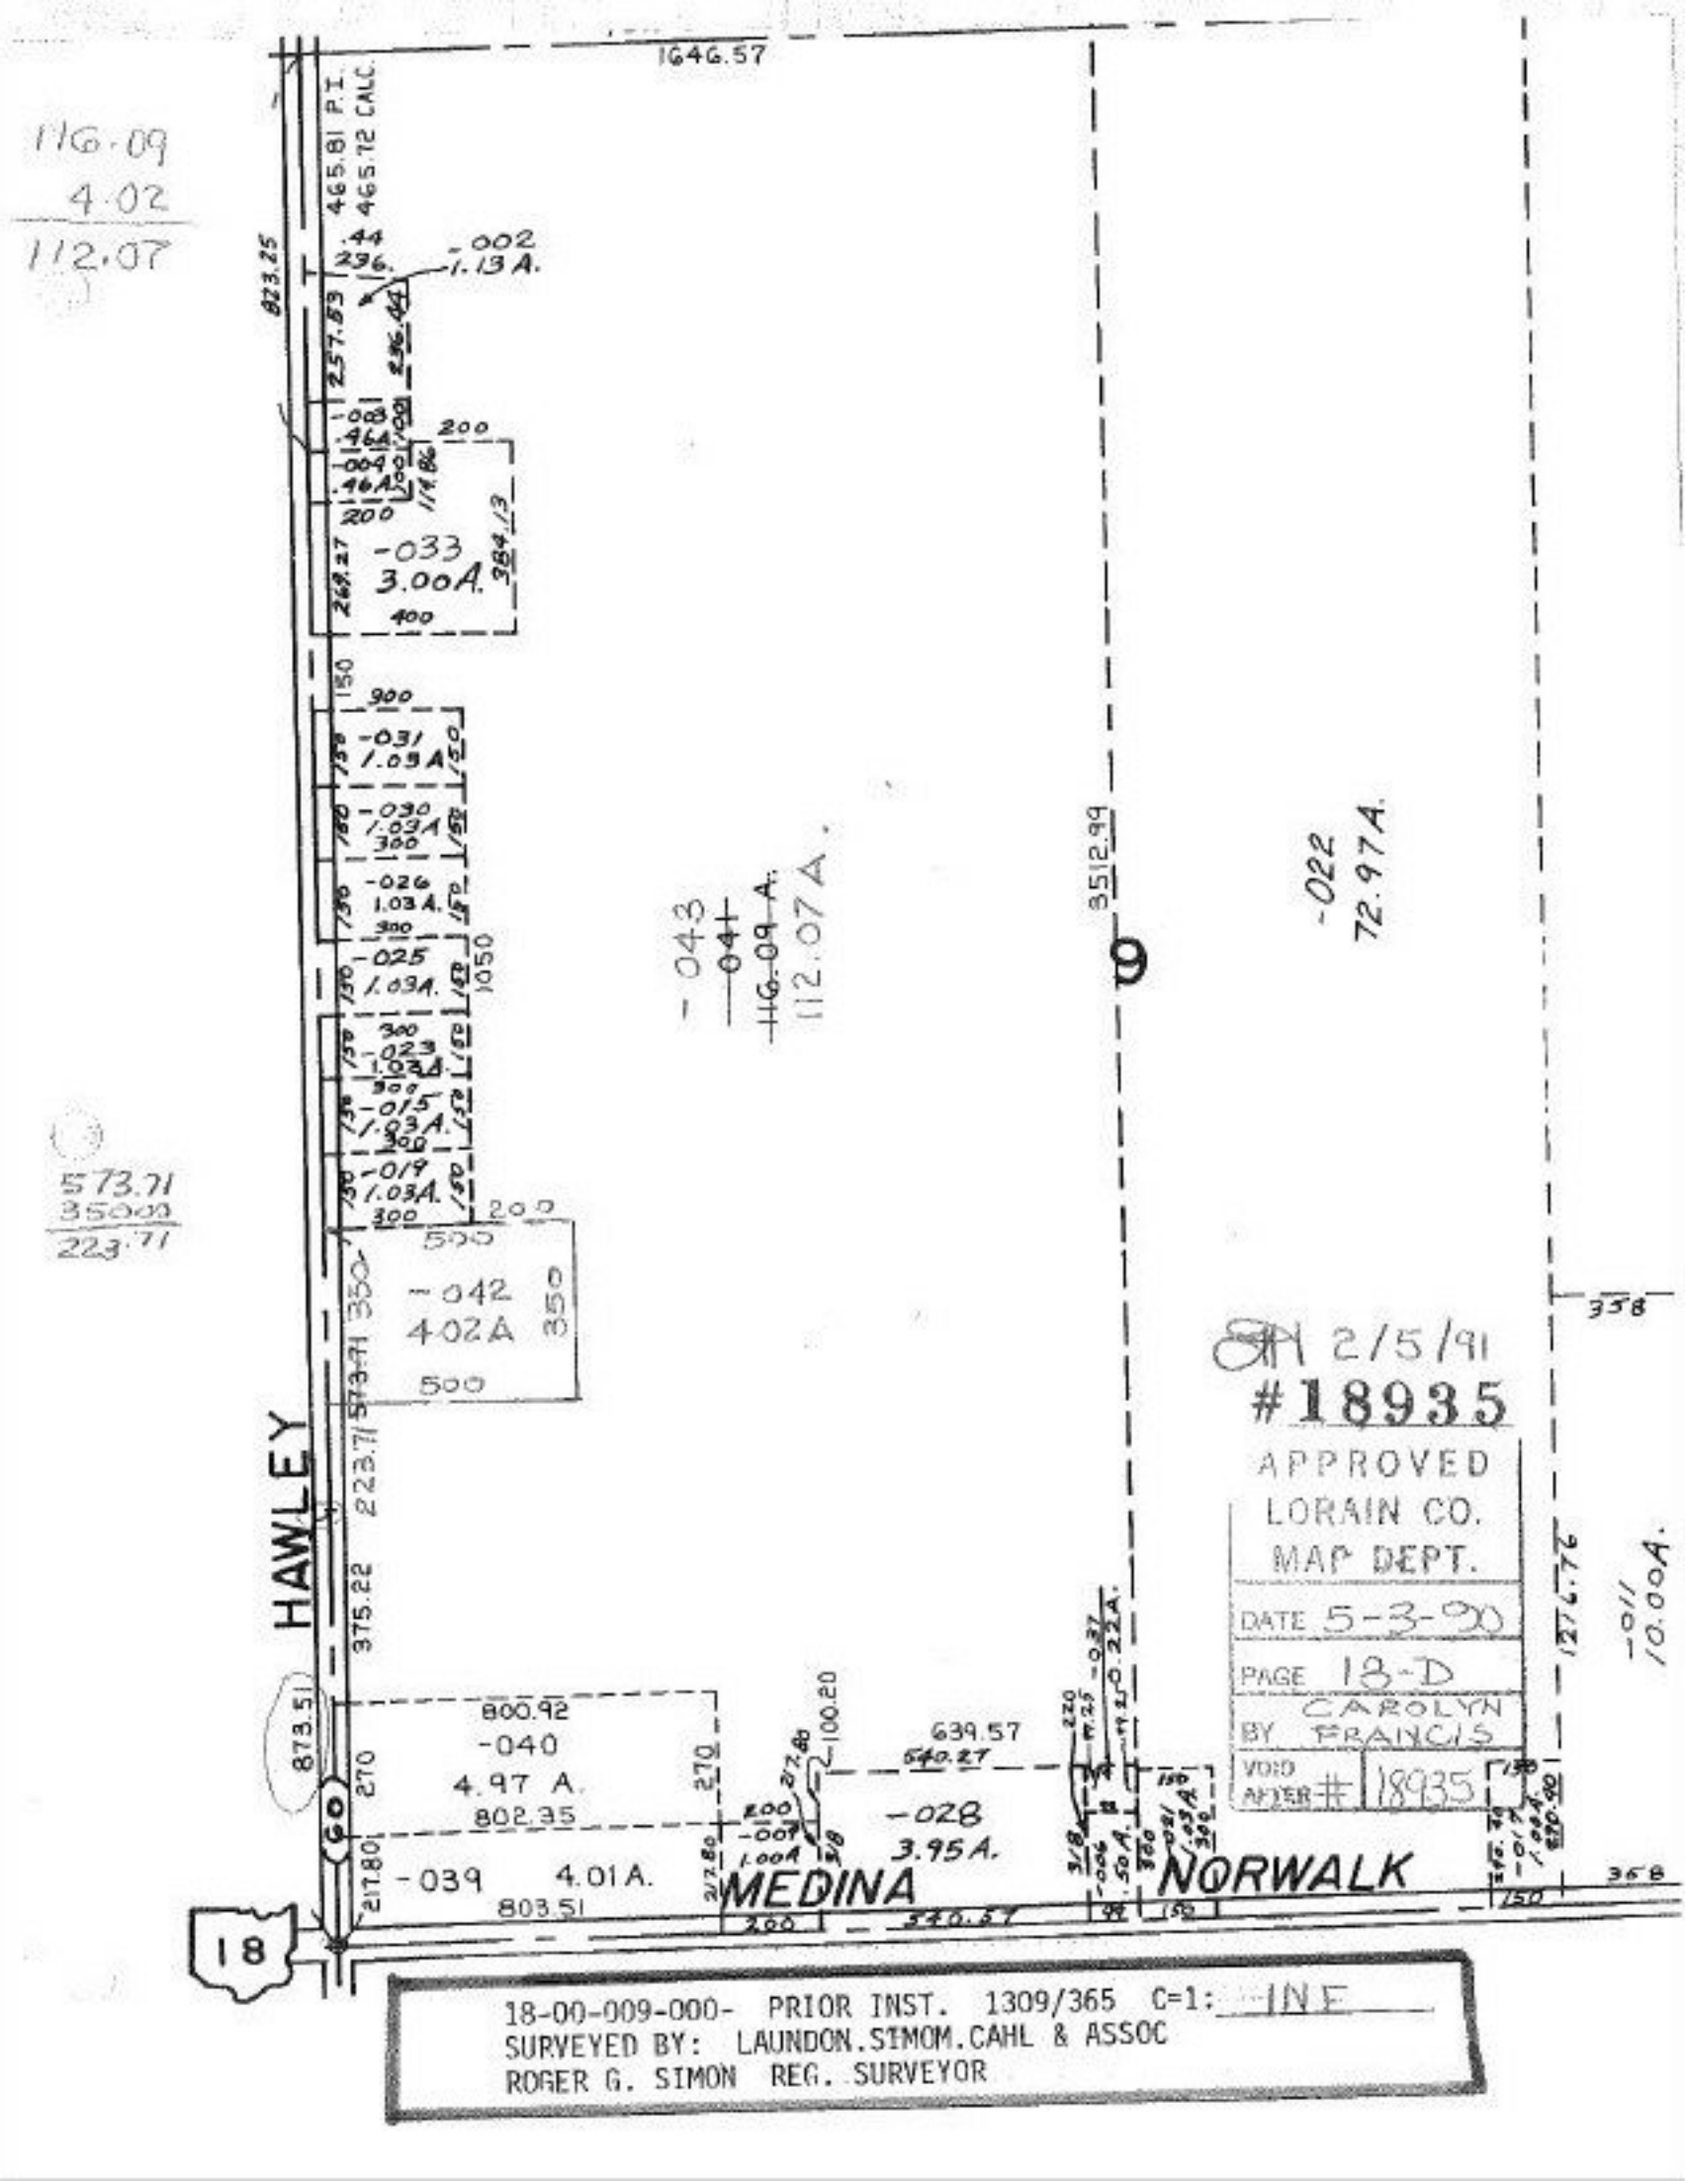

116.09
4.02
112.07

573.71
350.00
223.71

18-00-009-000- PRIOR INST. 1309/365 C=1: INF
SURVEYED BY: LAUNDON.SIMOM.CAHL & ASSOC
ROGER G. SIMON REG. SURVEYOR