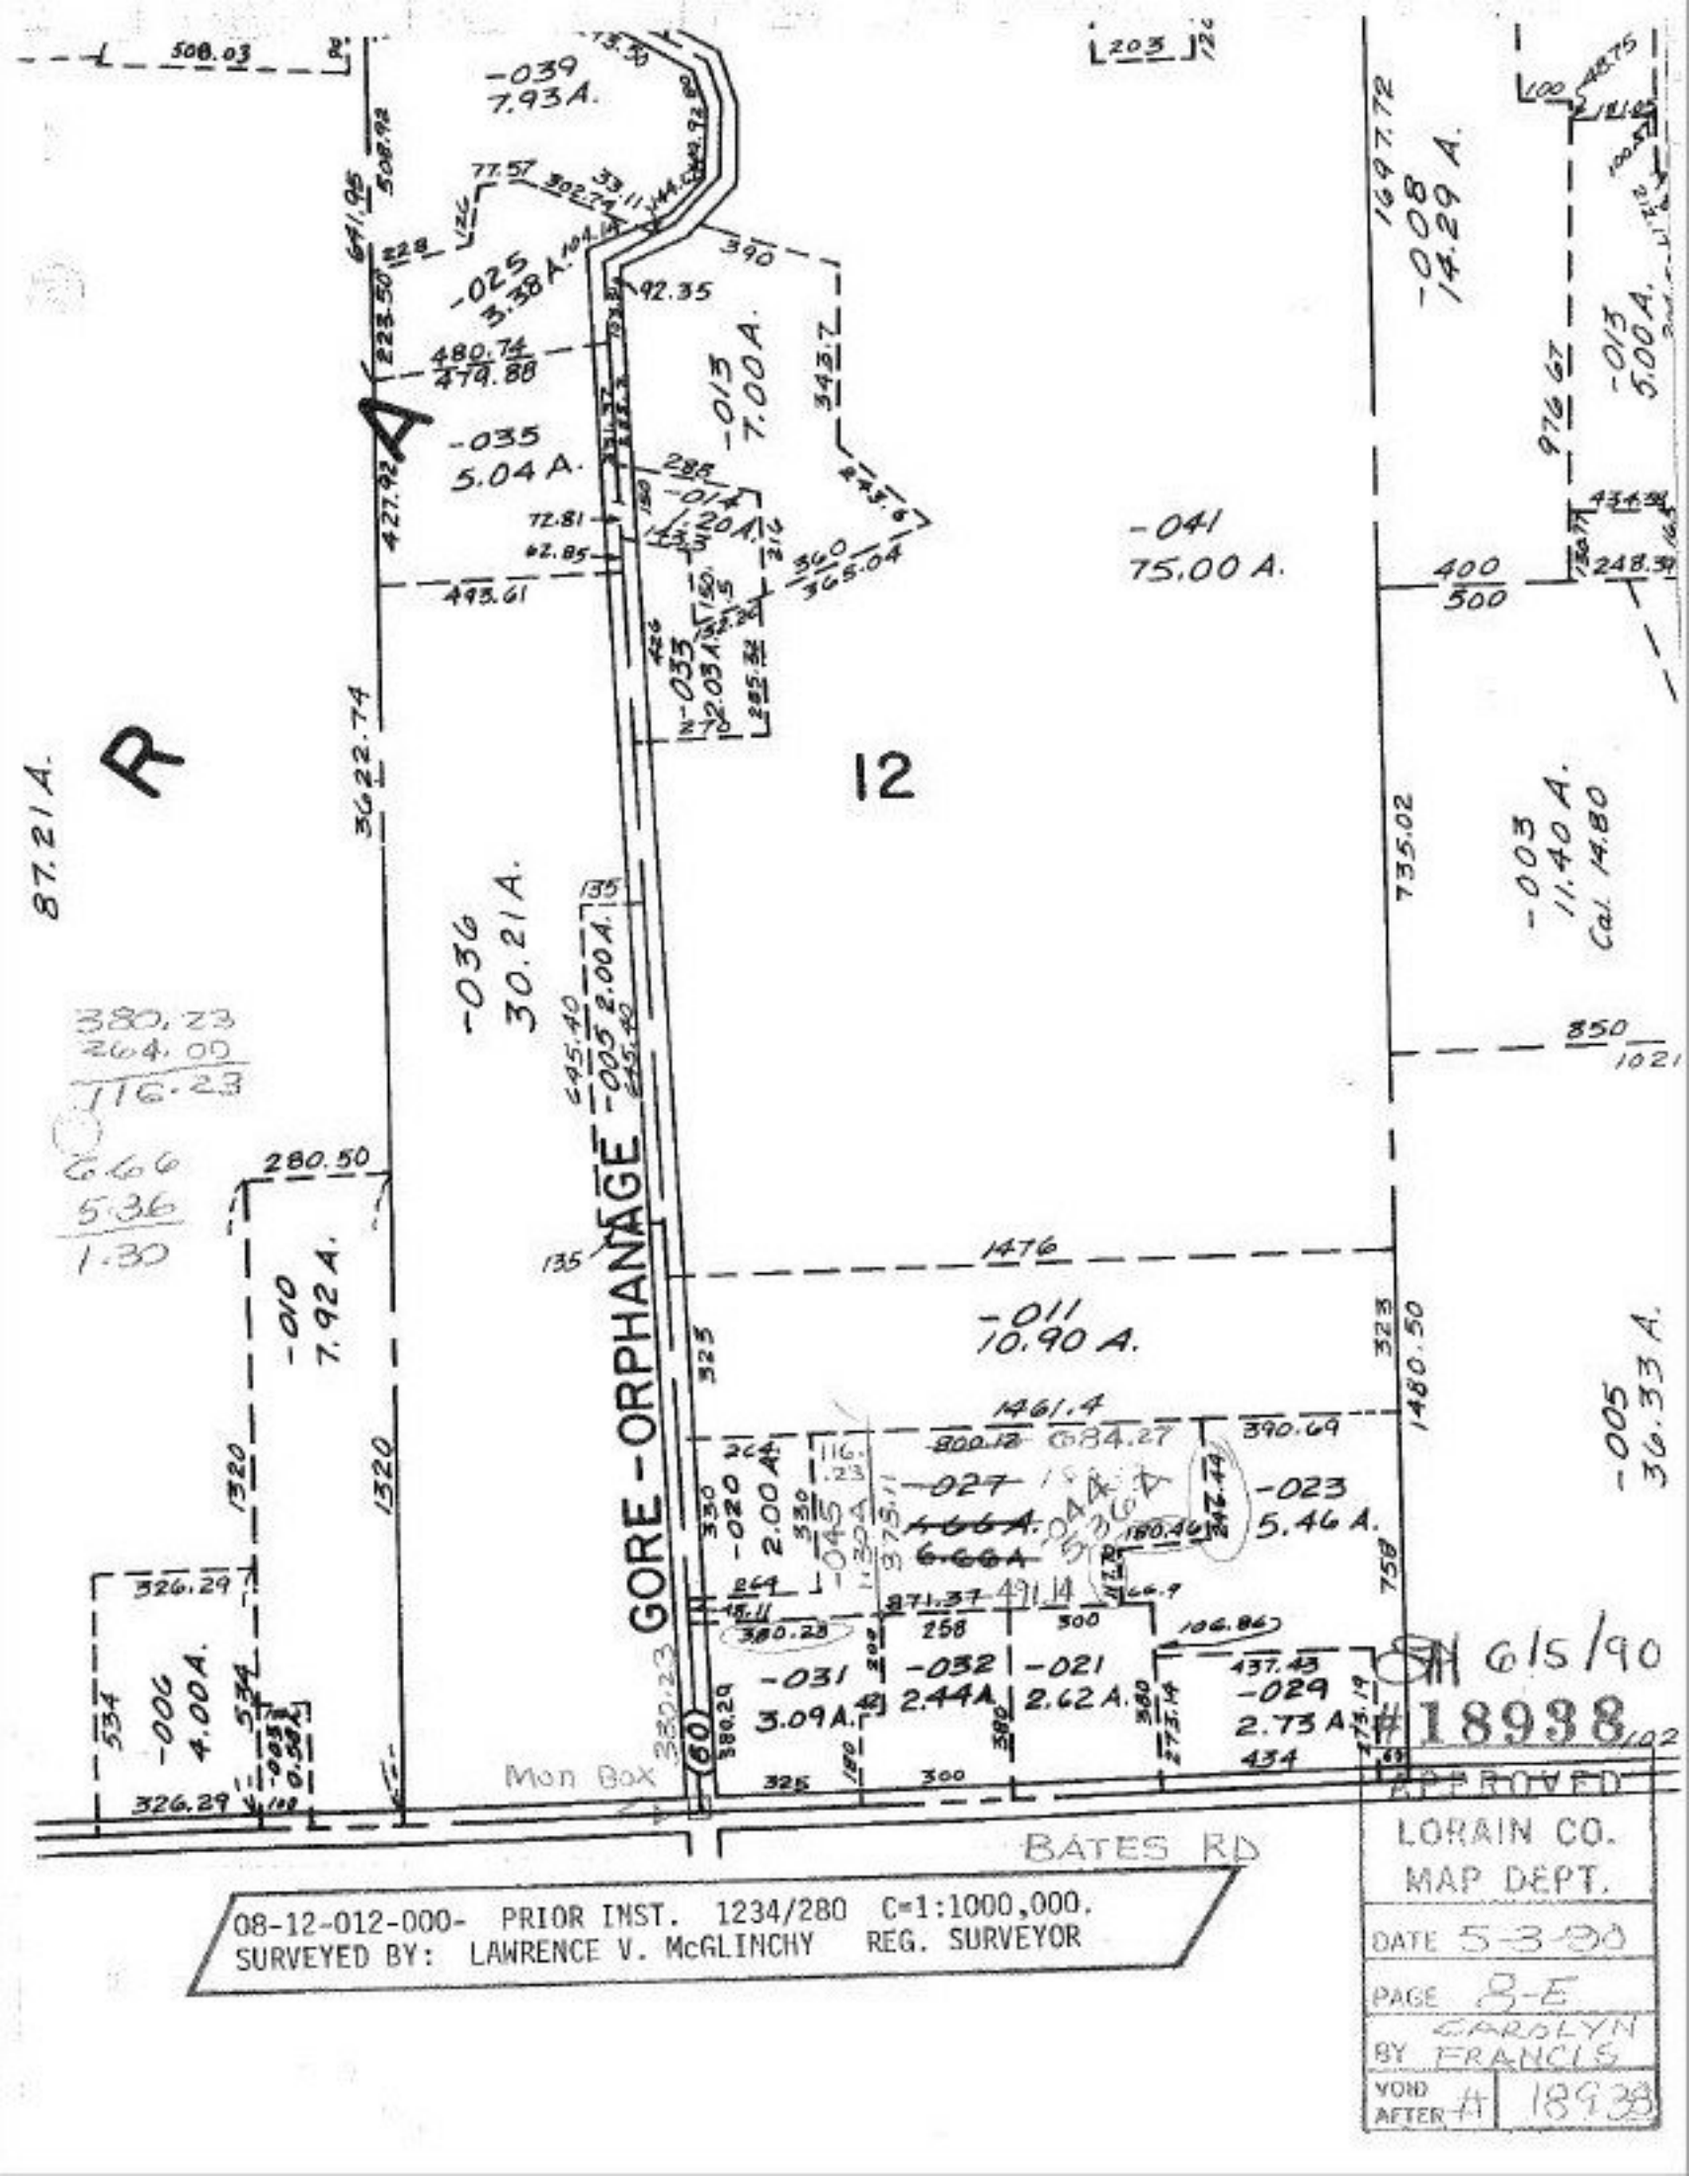

08-12-012-000- PRIOR INST. 1234/280 C=1:1000,000.
SURVEYED BY: LAWRENCE V. McGLINCHY REG. SURVEYOR