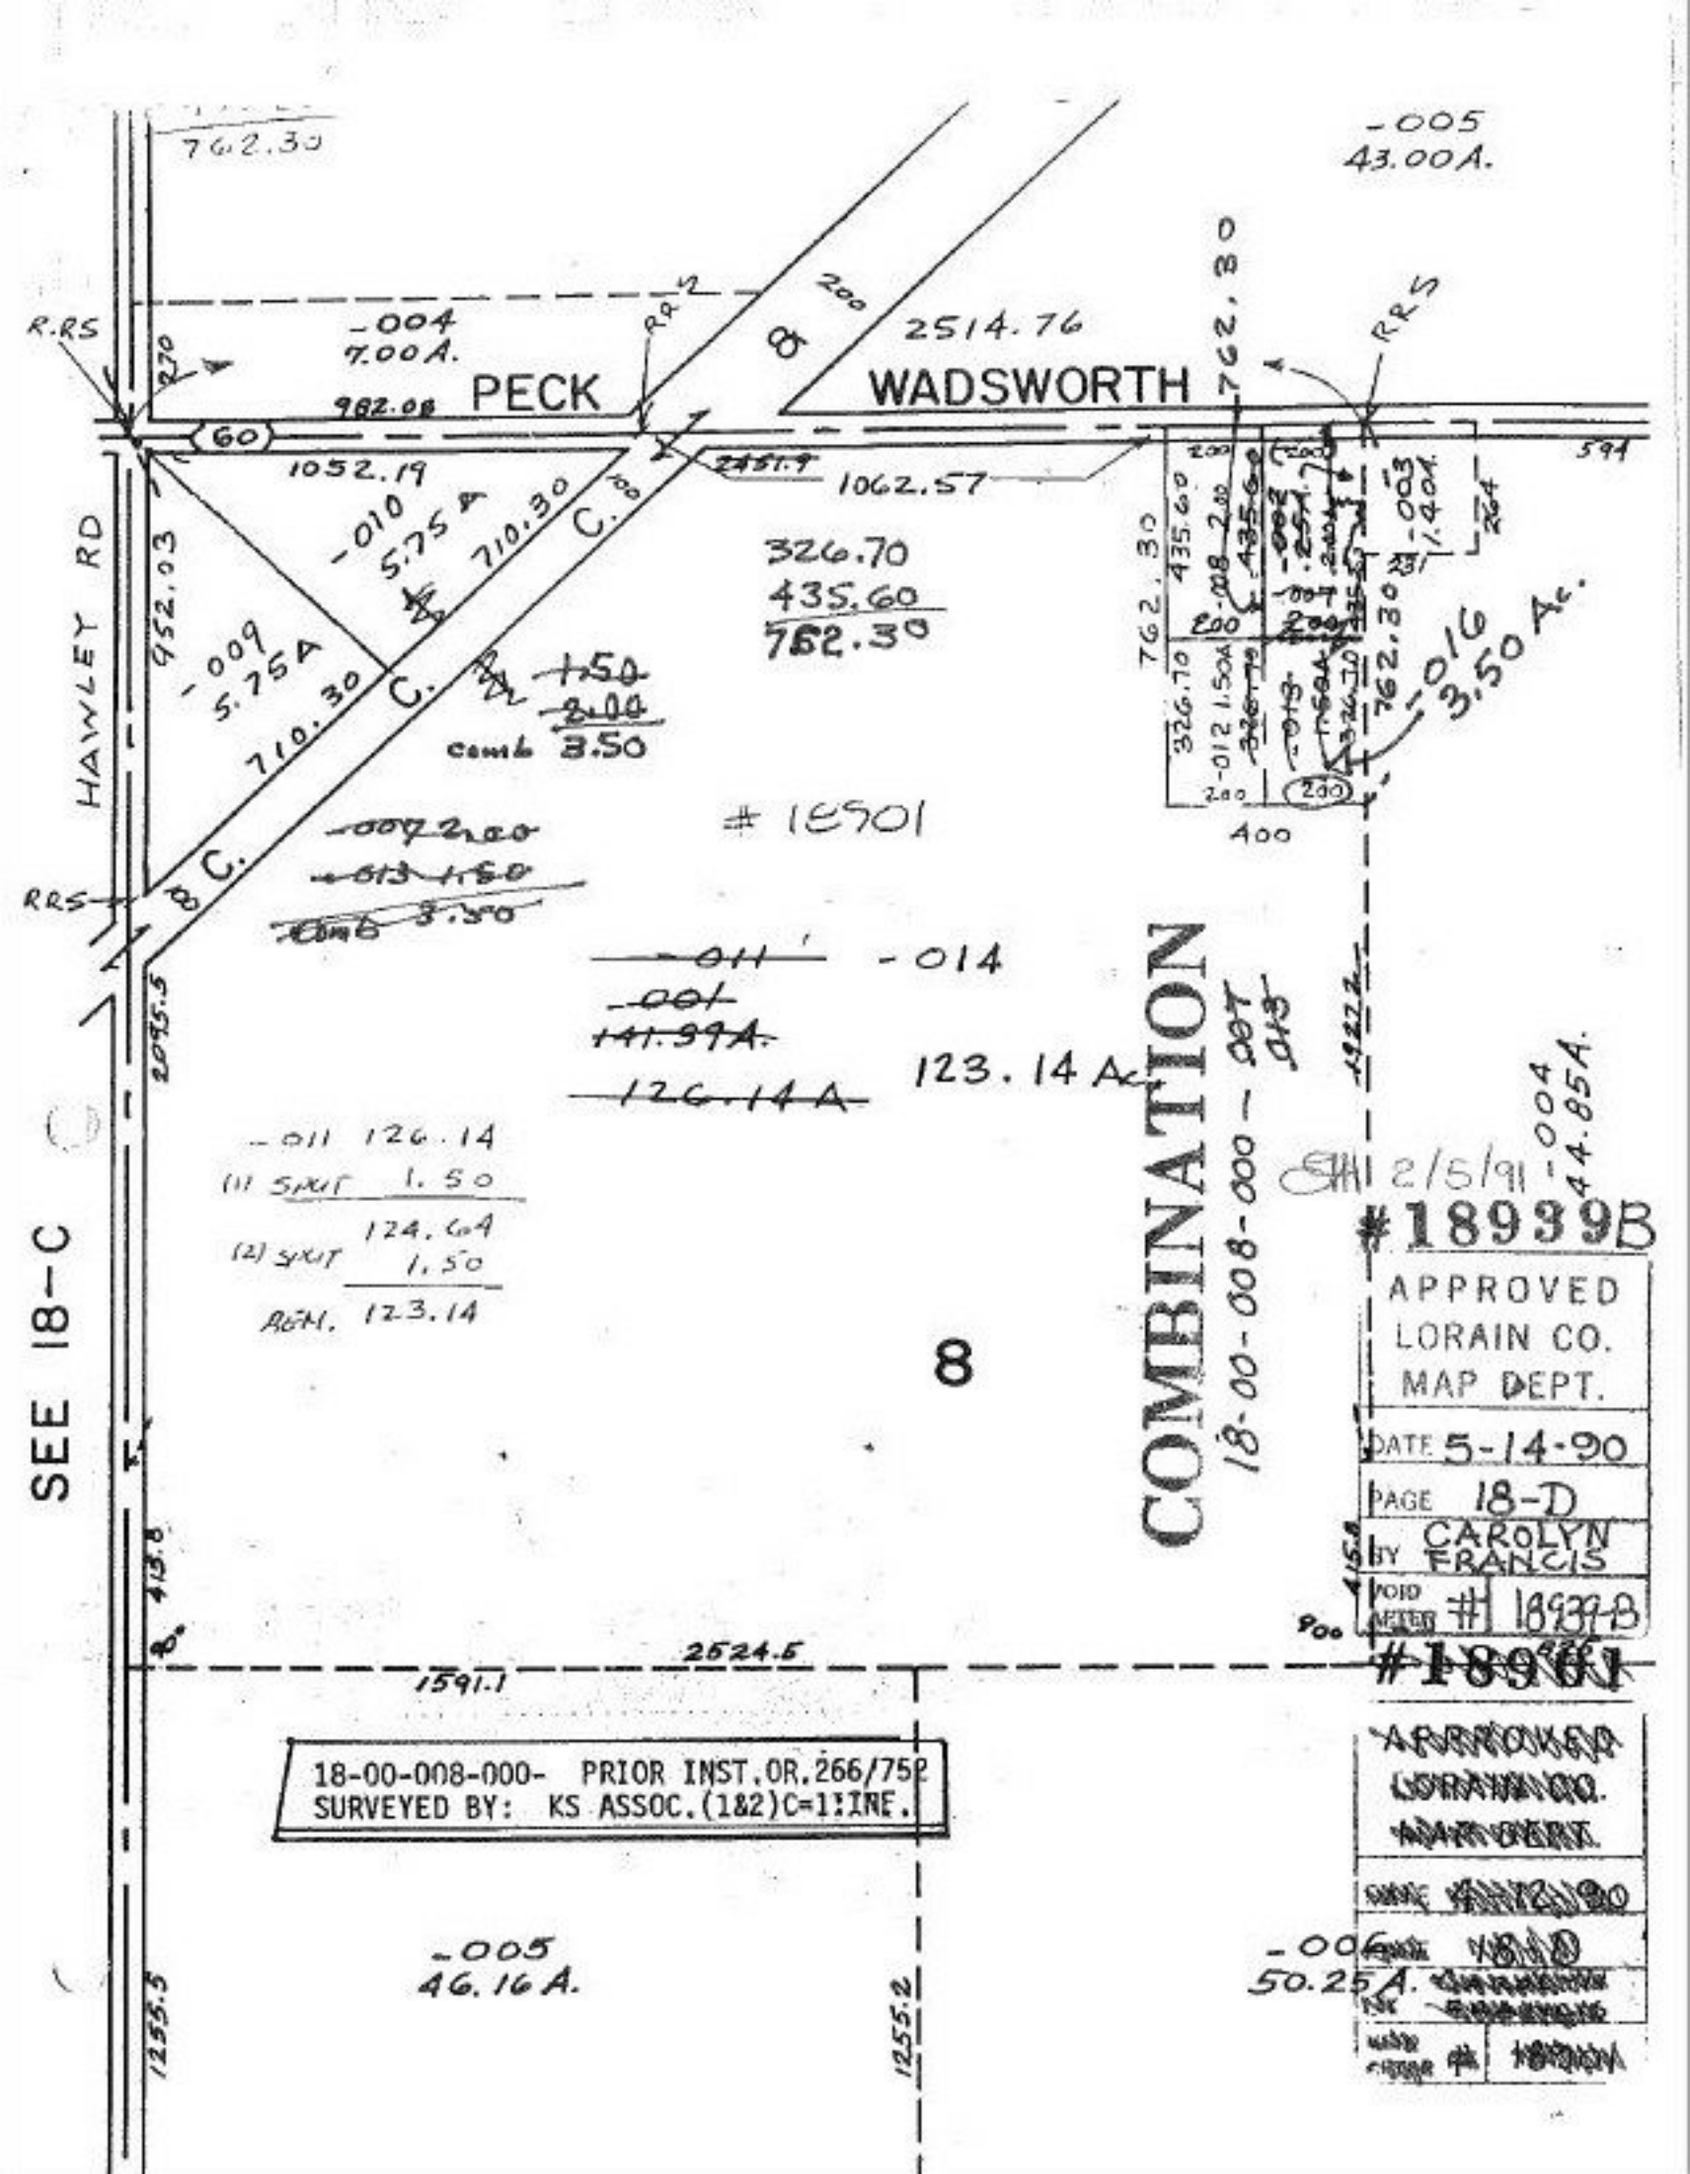
762.30
-005
43.00A.
R.RS
-004
7.00A.
PECK
WADSWORTH
982.08
60
2514.76
762.30
1052.19
-010
5.75A
710.30
952.03
HAWLEY RD
-009
5.75A
710.30
1062.57
326.70
435.60
762.30
combo 3.50
16901
-007 2.00
-013 1.50
combo 3.50
-011
-001
141.99A.
126.14A
-014
123.14 Ac
-011 126.14
(1) SPLIT 1.50
124.64
(2) SPLIT 1.50
AGM. 123.14
SEE 18-C
8
COMBINATION
18-00-008-000 - PRT
2/5/91
-004
44.85A.
#18939B
APPROVED
LORAIN CO.
MAP DEPT.
DATE 5-14-90
PAGE 18-D
BY CAROLYN FRANCIS
VOID AFTER #18939B
#18961
2524.5
1591.1
18-00-008-000- PRIOR INST. OR. 266/752
SURVEYED BY: KS ASSOC. (1&2) C=1' INE.
-005
46.16A.
-006
50.25A.
1255.5
1255.2