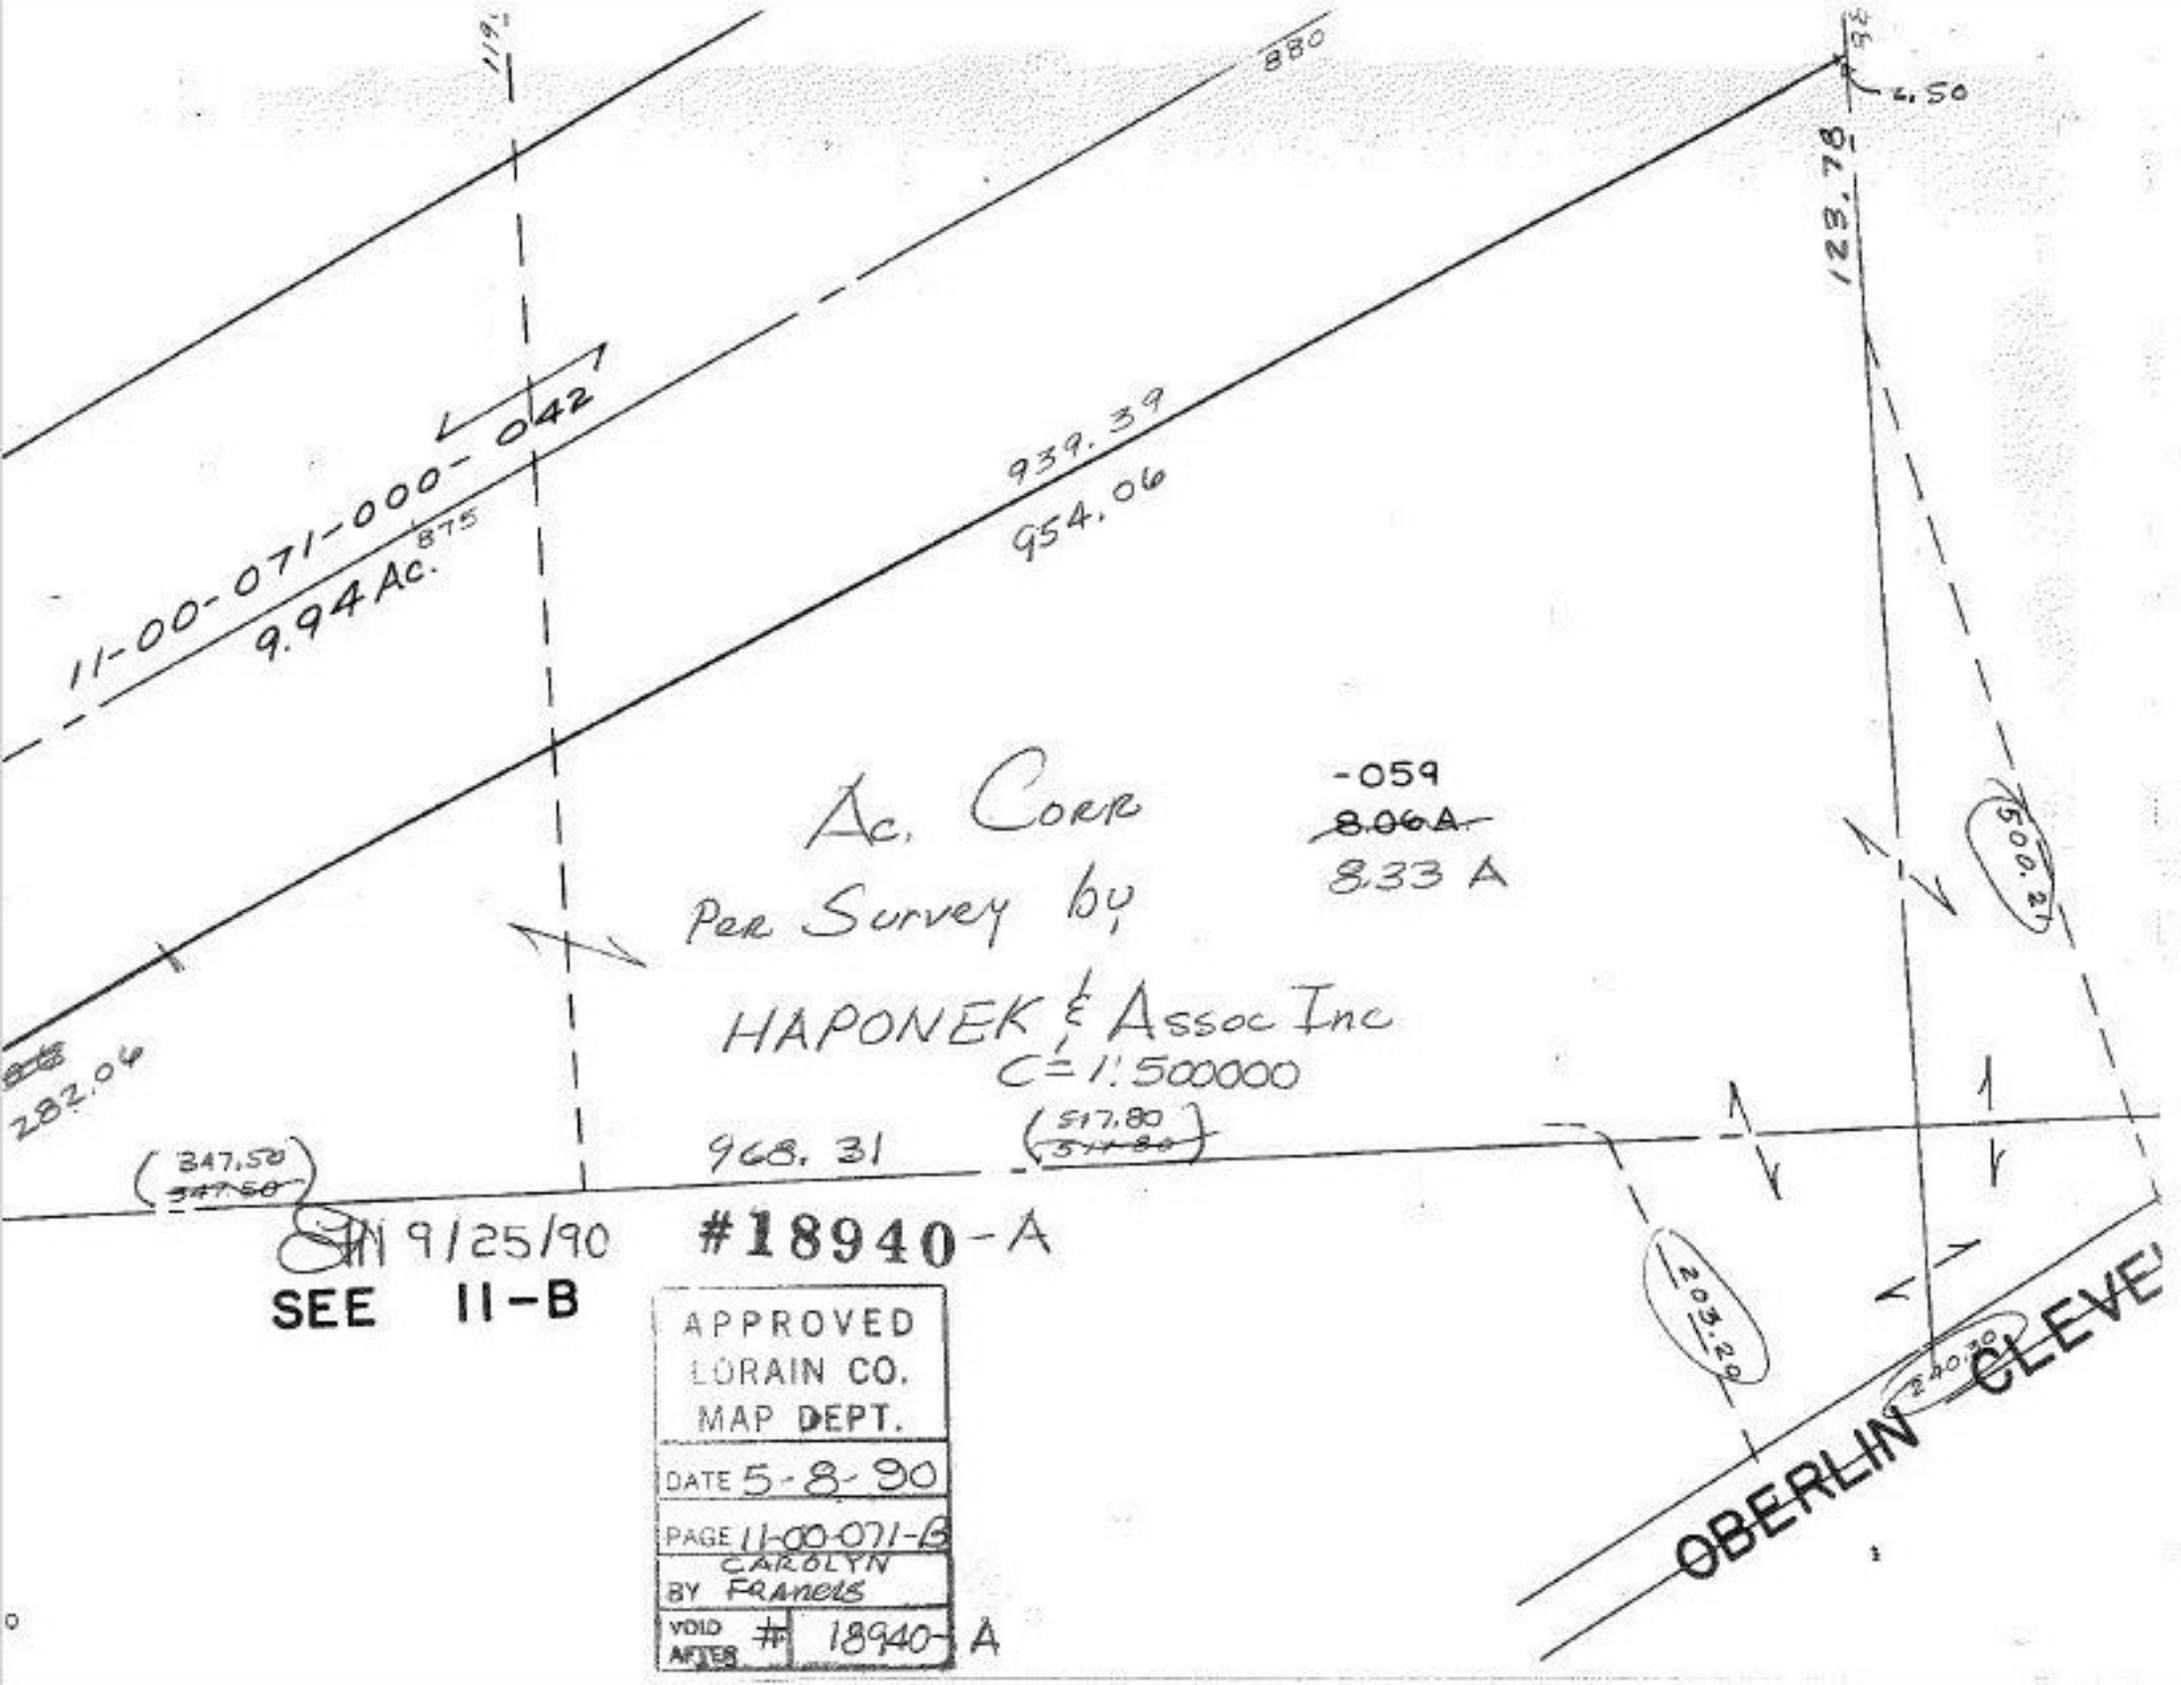

JN 9/25/90

#18940-A

SEE 11-B

APPROVED
LORAIN CO.
MAP DEPT.
DATE 5-8-90
PAGE 11-00-071-G
BY CAROLYN FRANCIS
VOID AFTER # 18940-A