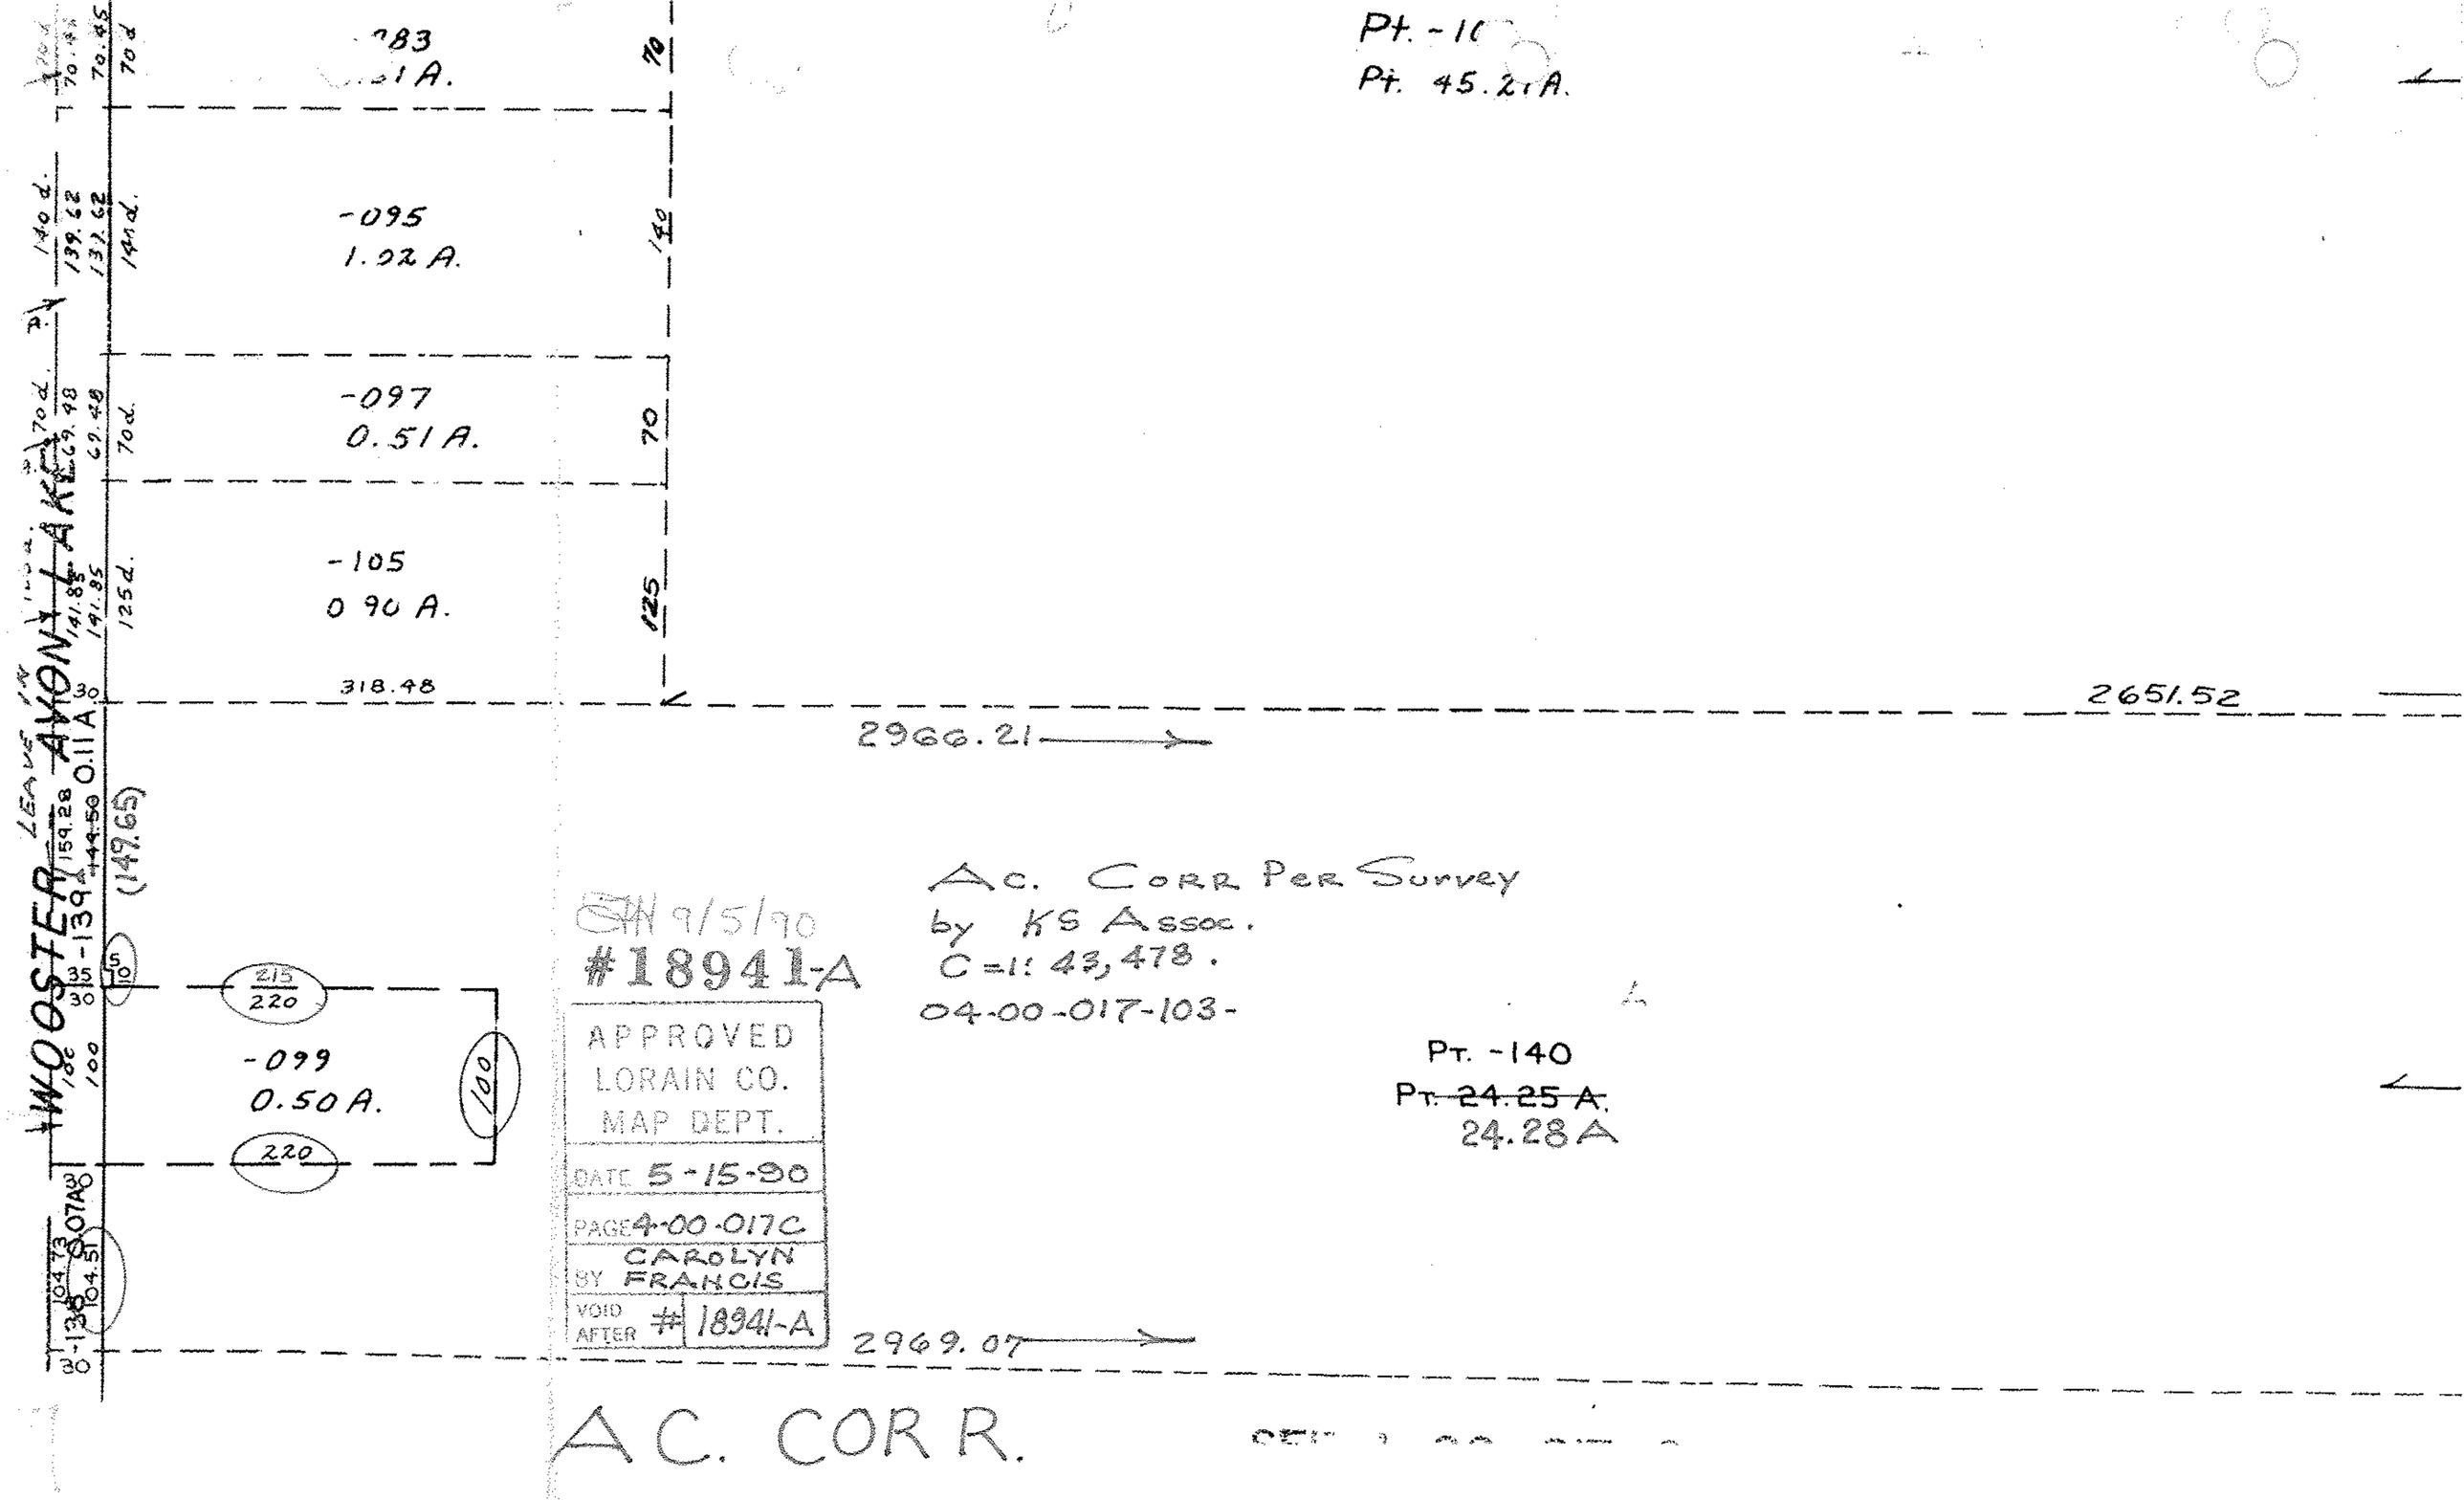

Pt. -10
Pt. 45.21 A.
-083
-095
1.02 A.
-097
0.51 A.
-105
0 90 A.
318.48
2651.52
2966.21
WOOSTER AVON LAKE
LEAVE IN
0.11 A
(149.65)
-139
-099
0.50 A.
215
220
100
2969.07
Ac. Corr Per Survey
by KS Assoc.
C=1: 43,478.
04-00-017-103-
Pt. -140
Pt. ~~24.25 A.~~
24.28 A
9/5/90
#18941-A
APPROVED
LORAIN CO.
MAP DEPT.
DATE 5-15-90
PAGE 4-00-017C
BY CAROLYN FRANCIS
VOID AFTER # 18941-A
AC. CORR.