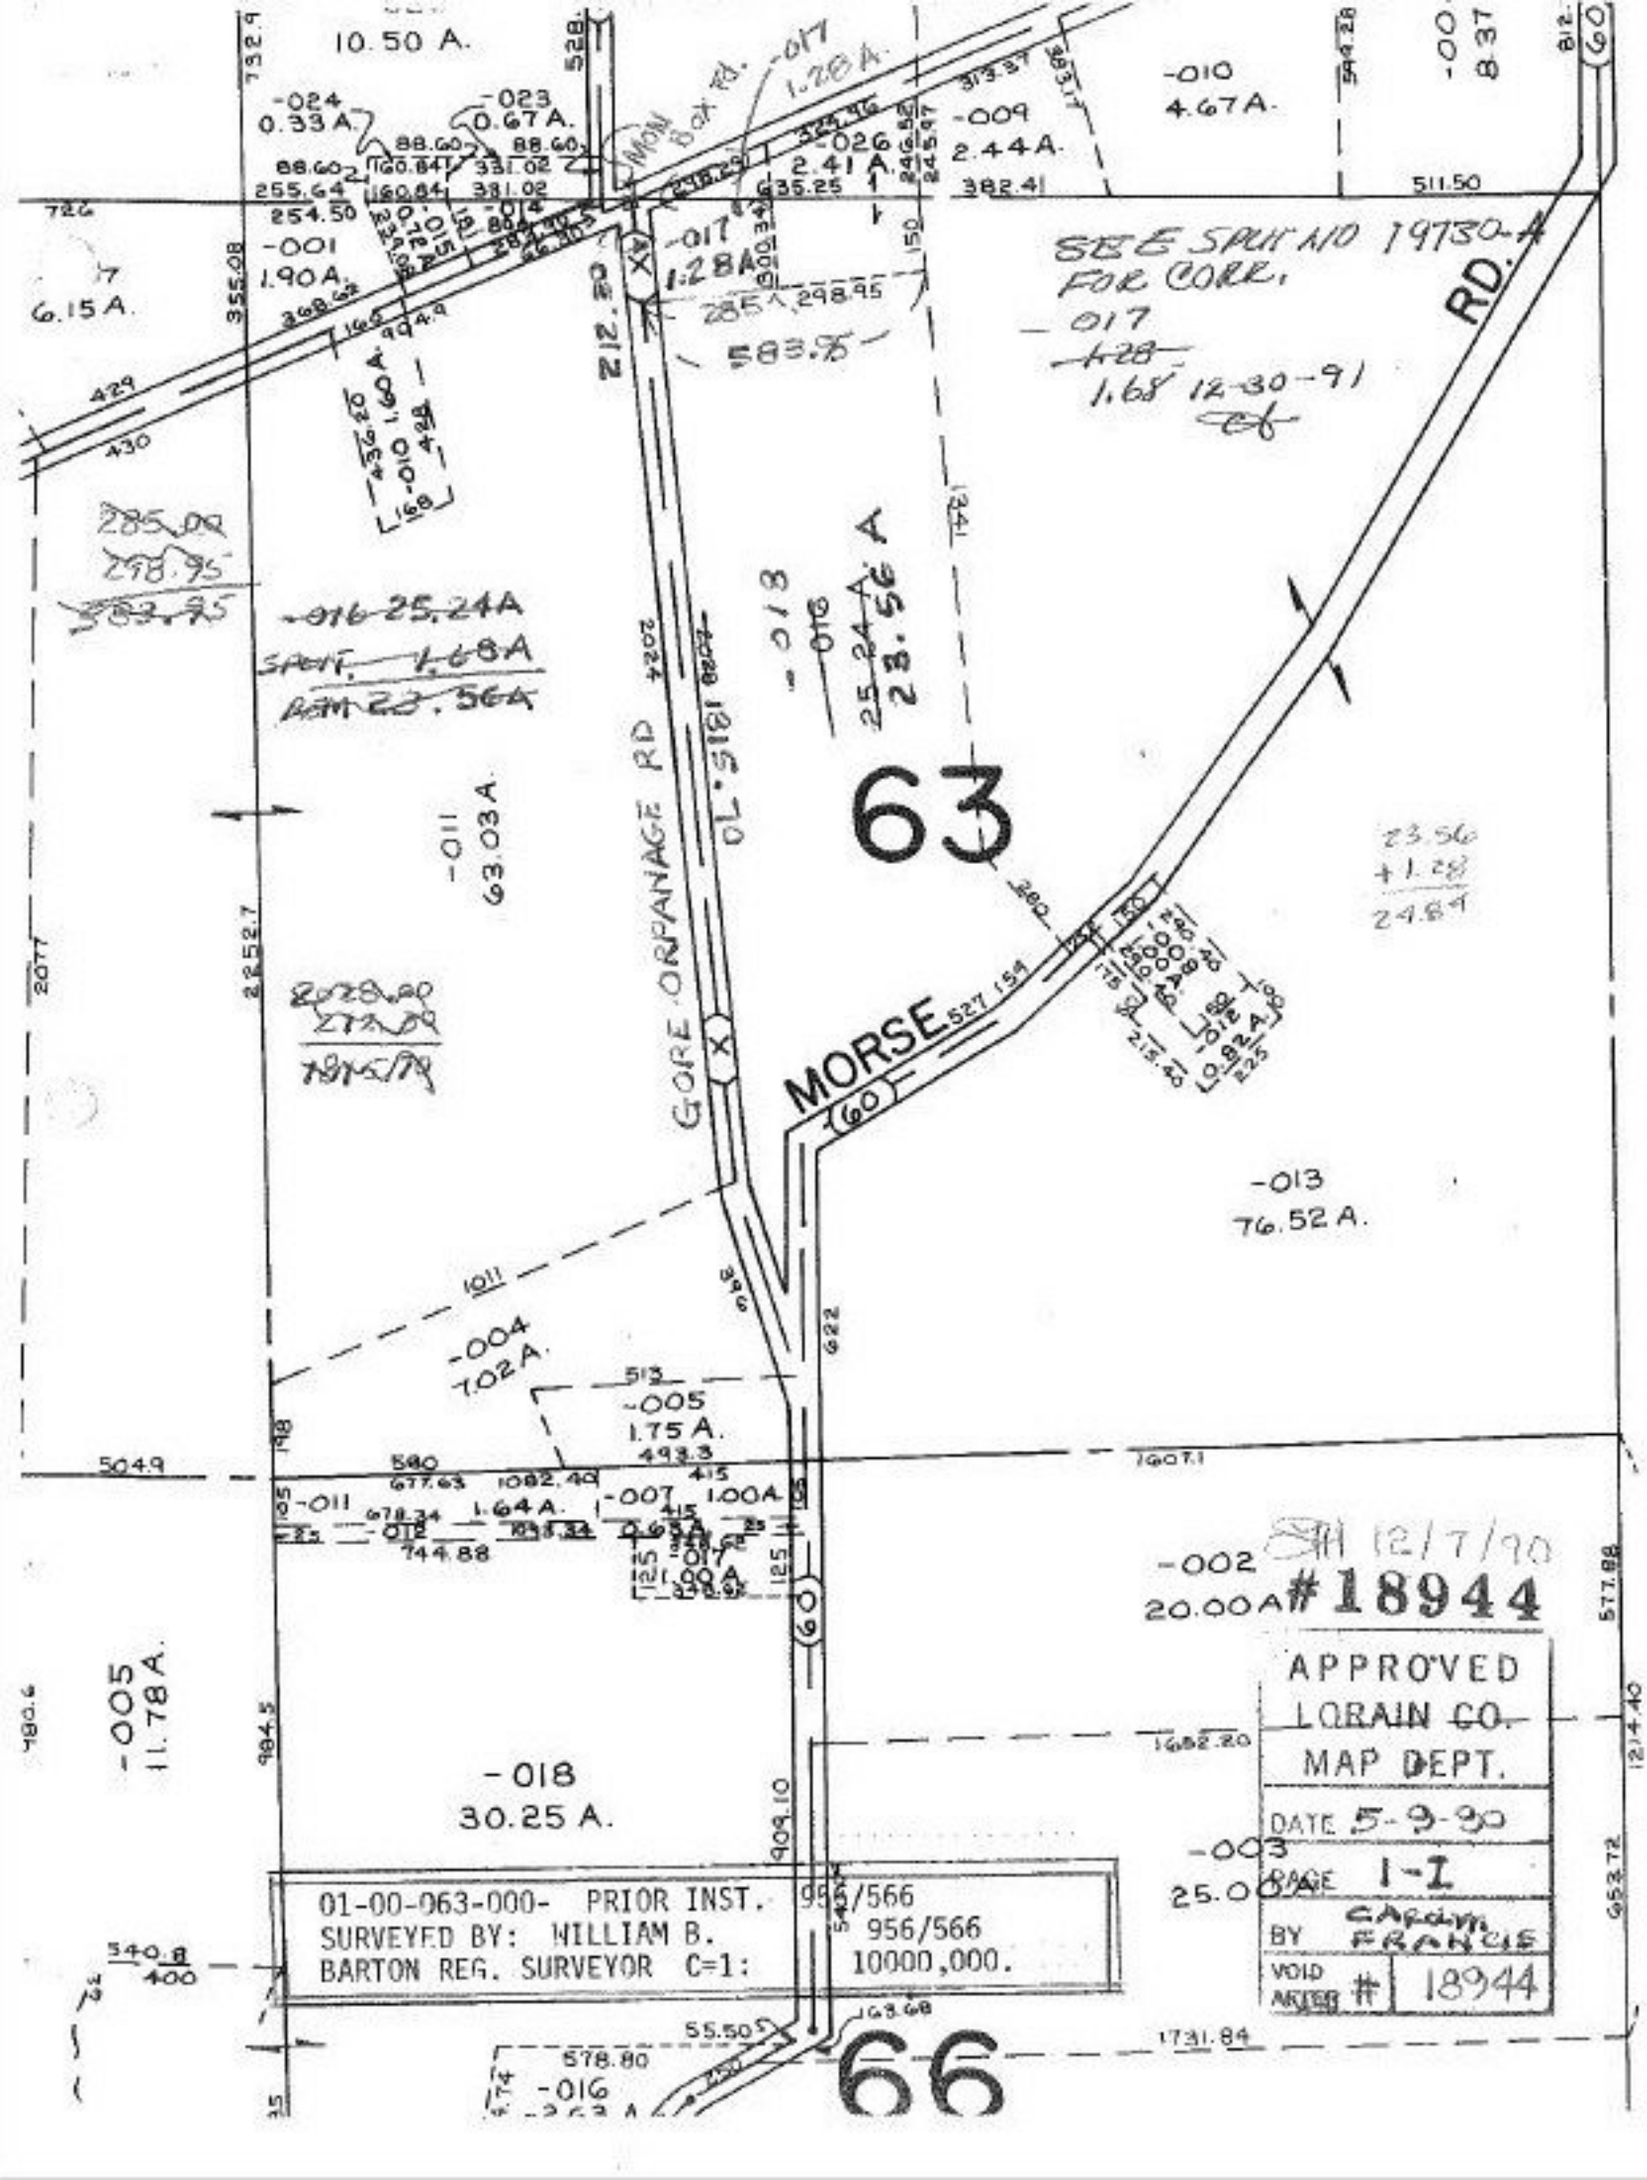
10.50 A.
-024
0.33 A.
-023
0.67 A.
-017
1.28 A.
-010
4.67 A.
-009
2.44 A.
-026
2.41 A.
-001
1.90 A.
6.15 A.
-017
1.28 A.
SEE SPLIT NO 19730-A
FOR CORR.
-017
1.28
1.68 12-30-91
-016 25.24 A
SPLIT 1.68 A
REM 23.56 A
-018
25.24 A
23.56 A
-011
63.03 A.
63
23.56
+1.28
24.84
GORE ORPHANAGE RD
OL 5181
MORSE
60
-013
76.52 A.
-004
7.02 A.
-005
1.75 A.
-007
1.00 A.
-002
20.00 A
-005
11.78 A.
-018
30.25 A.
-003
25.00 A
66
-016
01-00-063-000- PRIOR INST. 995/566
SURVEYED BY: WILLIAM B. 956/566
BARTON REG. SURVEYOR C=1: 10000,000.
SEE 12/7/90
#18944
APPROVED
LORAIN CO.
MAP DEPT.
DATE 5-9-90
PAGE 1-I
BY CAROL FRANCIS
VOID AFTER # 18944