


6/28/93 SEE 7-B
7-00-034-A

#18946

APPROVED
LORAIN CO.
MAP DEPT.
DATE 6-25-93
PAGE 7-00-034-A
BY *[Signature]*
VOID AFTER 18946A

DEED CHECK
NO CHANGES ON TAP
MAP -005
5.51 A. DUP.
3.00 A. PL.

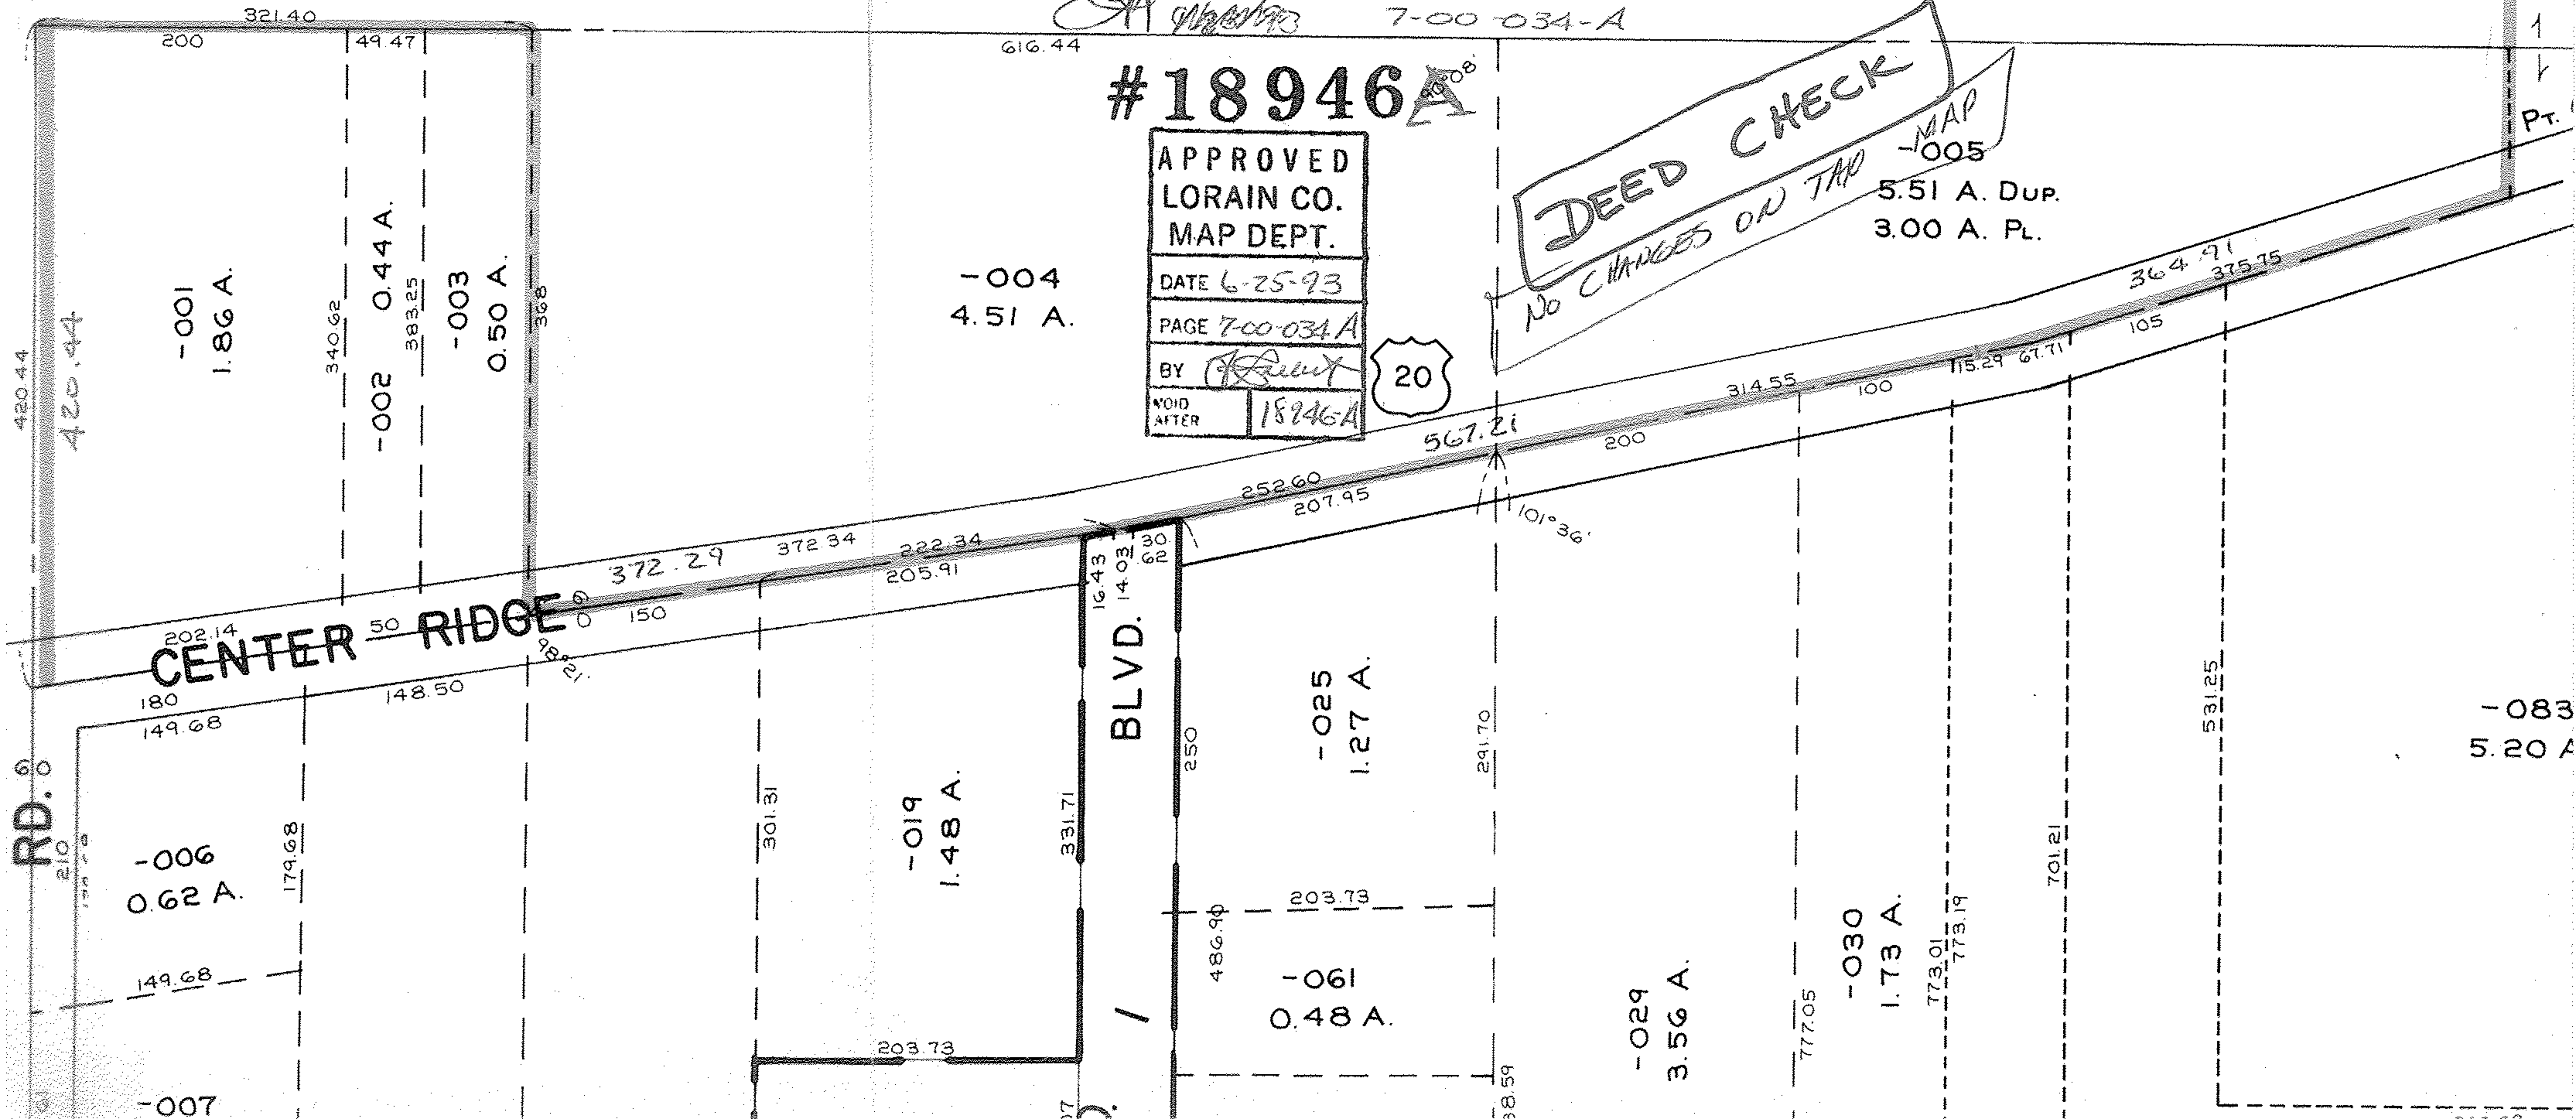

-001
1.86 A.
-002
0.44 A.
-003
0.50 A.

-004
4.51 A.

CENTER RIDGE

BLVD.

-019
1.48 A.

-025
1.27 A.

-061
0.48 A.

-029
3.56 A.

-030
1.73 A.

-083
5.20 A.

976.8