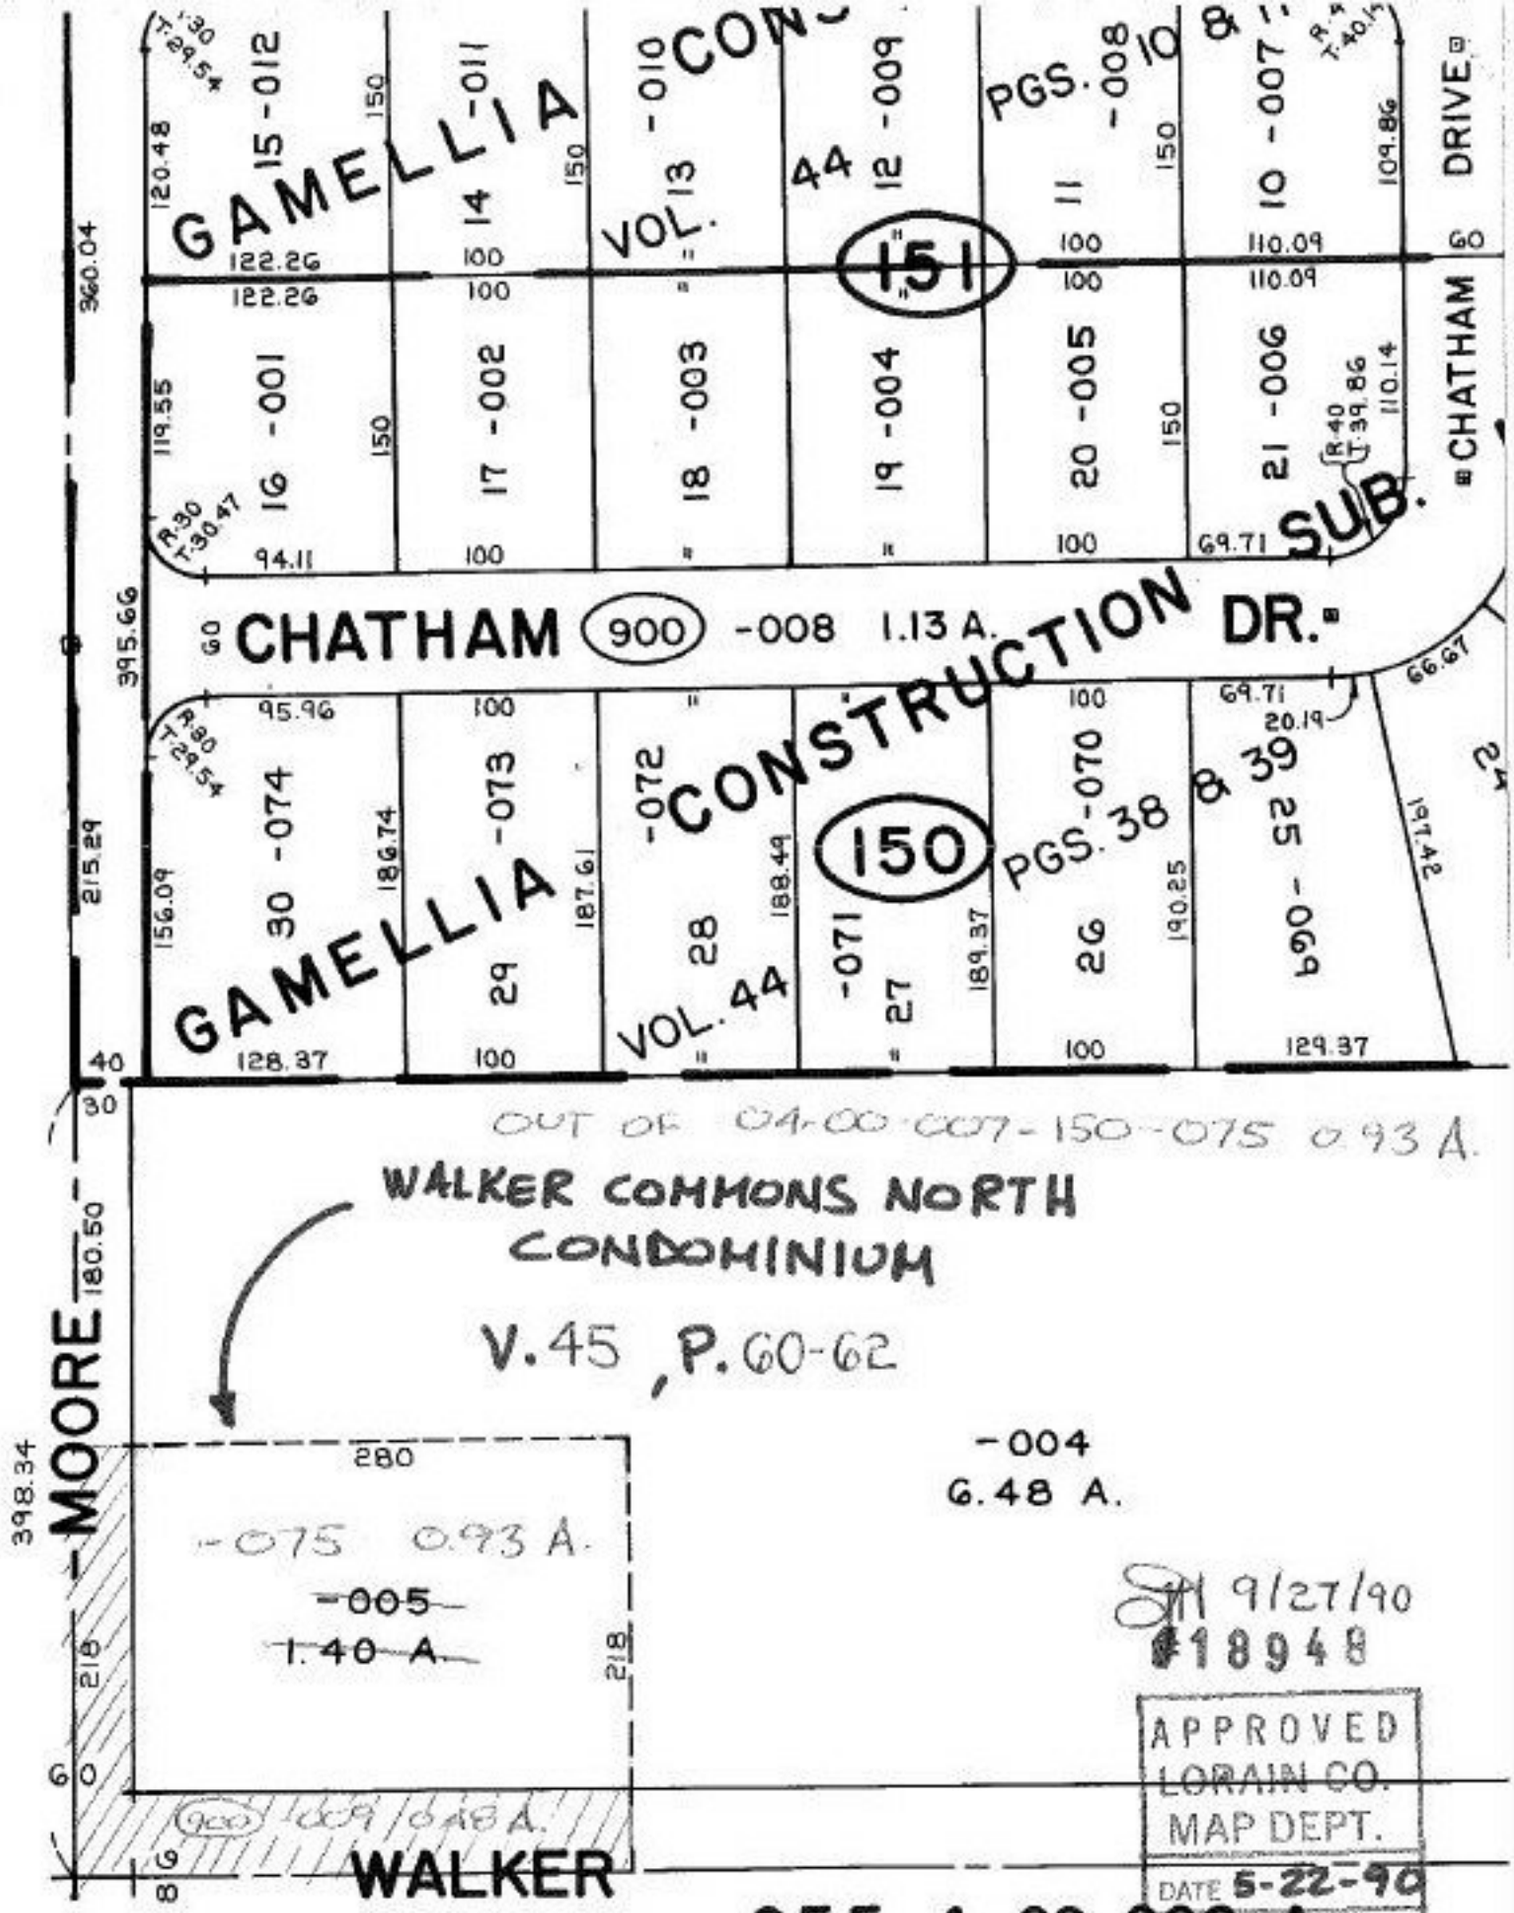

W 1/2 SW 1/4 SEC. 7