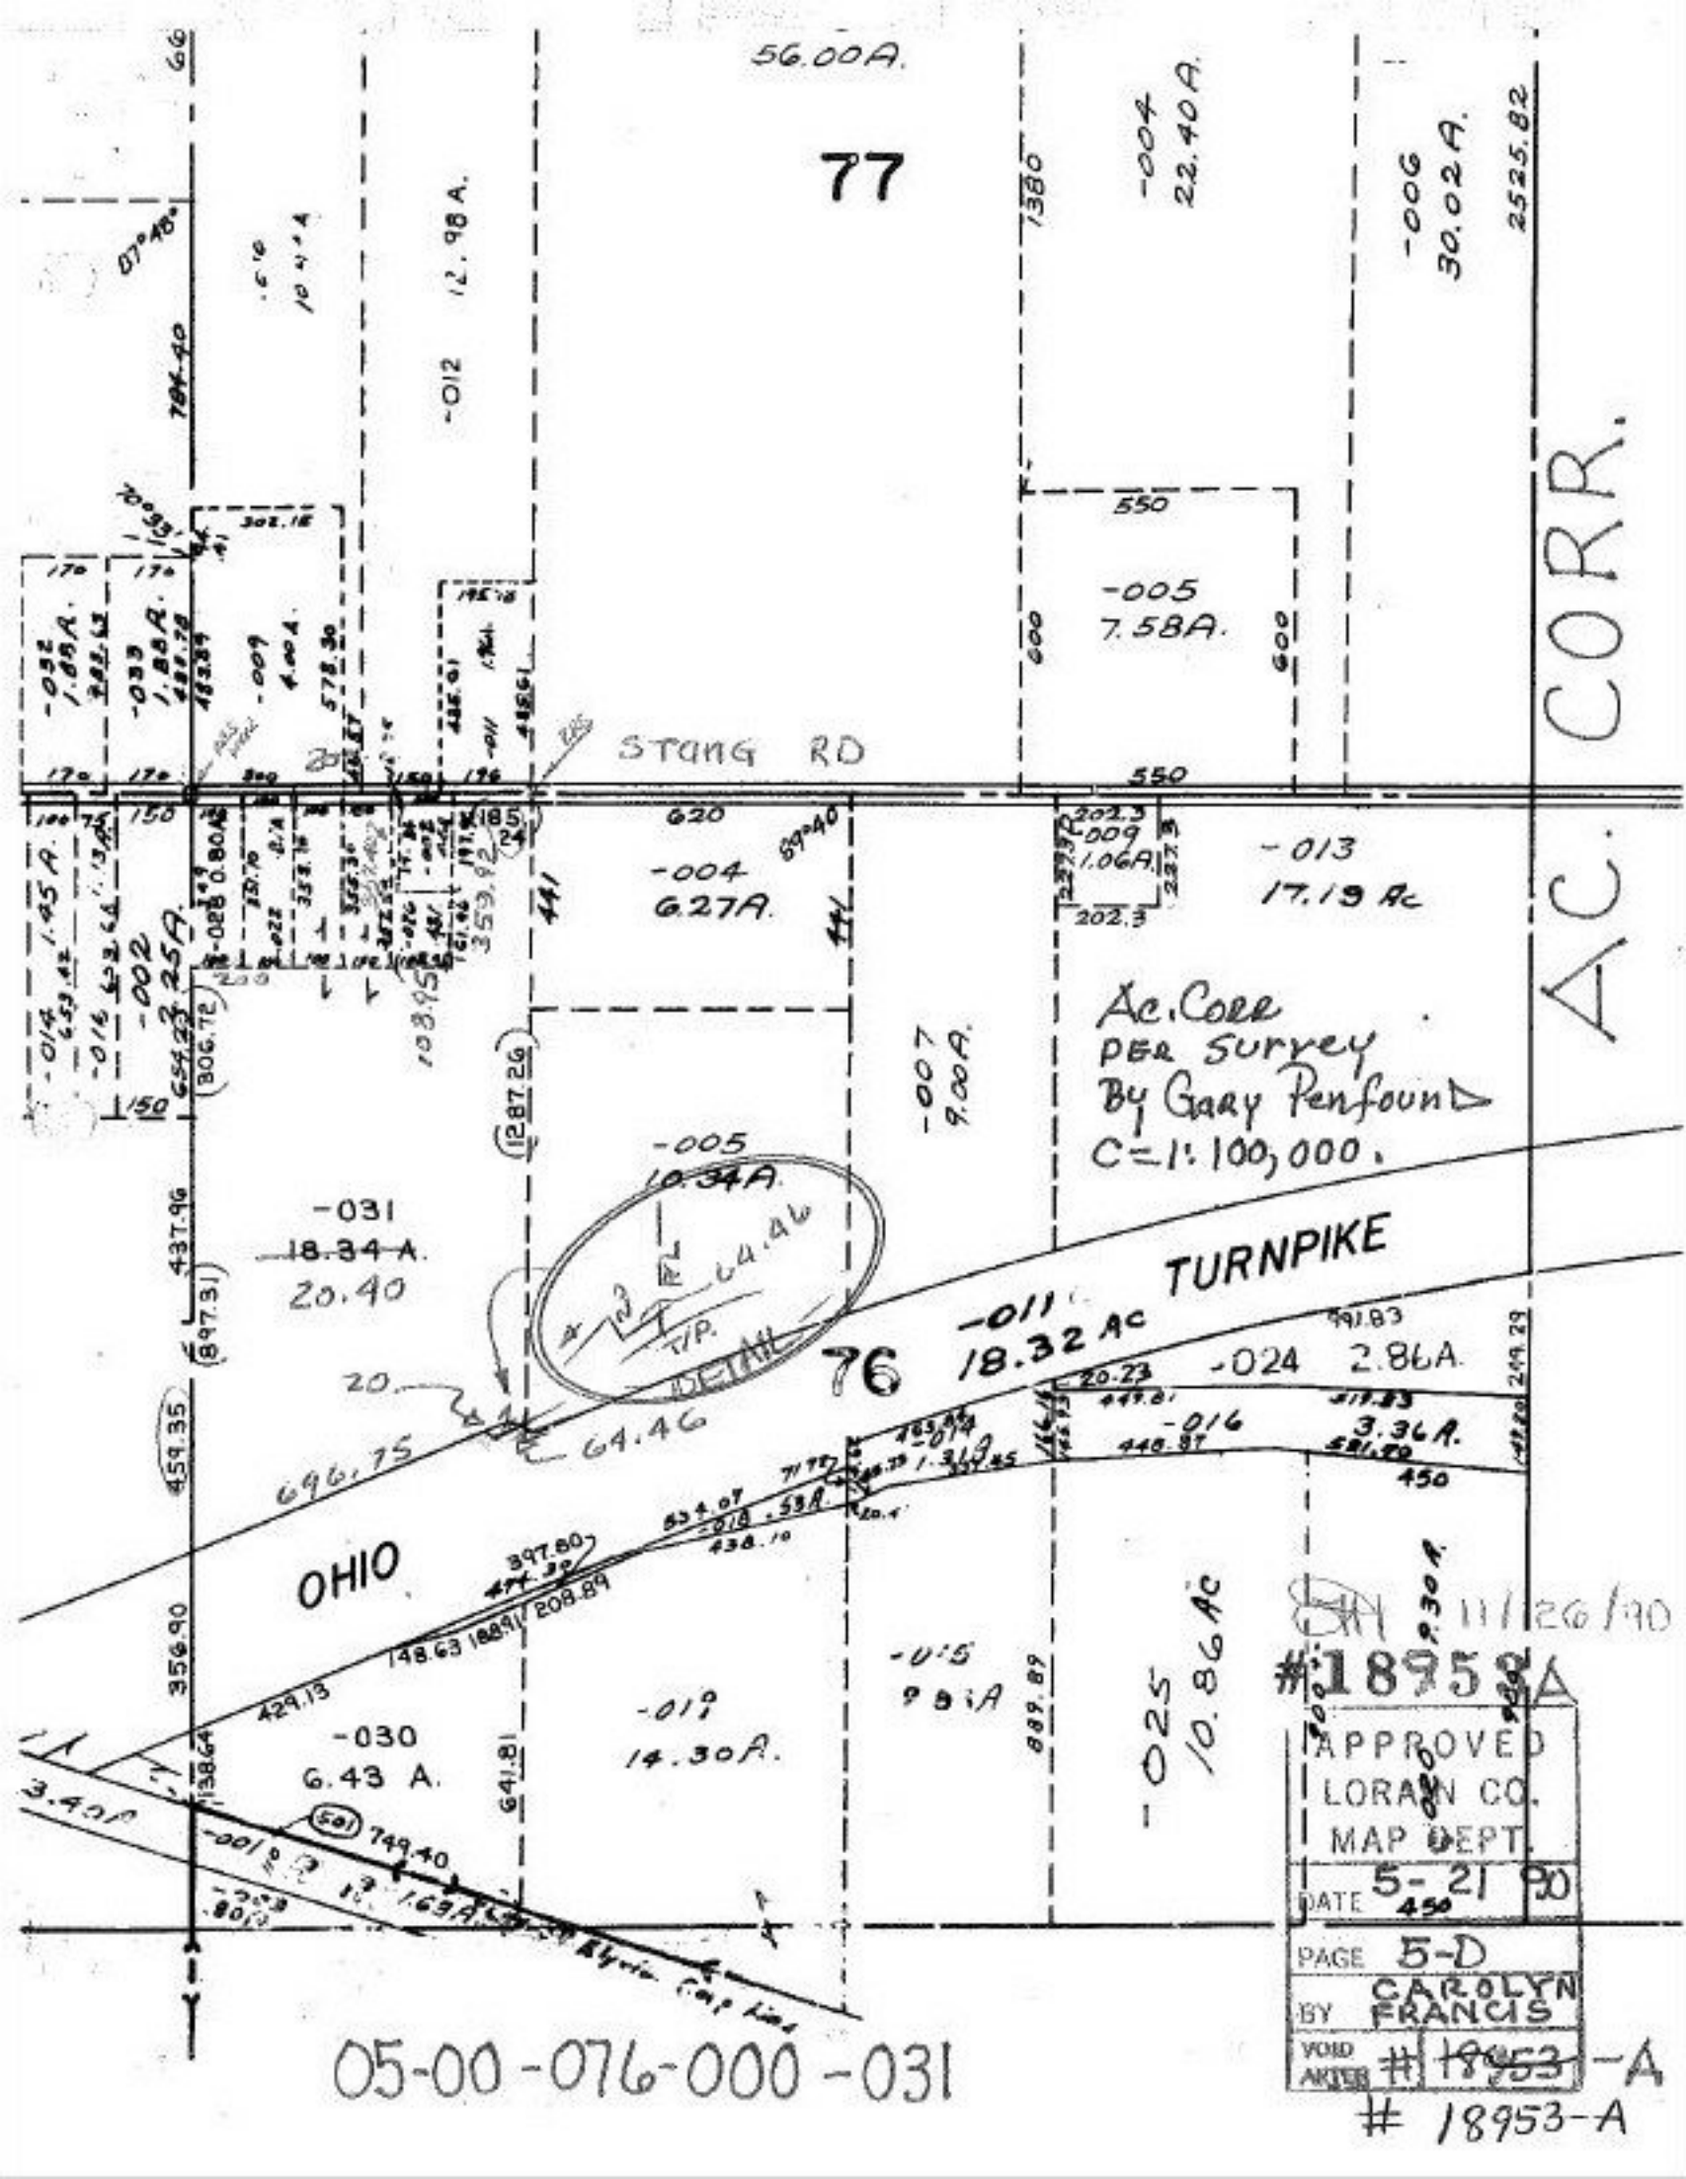
56.00A.
77
-004
22.40A.
-006
30.02A.
2525.82
1380
-012
12.98A.
-005
7.58A.
550
600
STANG RD
-032
1.88A.
-033
1.88A.
-009
4.00A.
-002
3.25A.
-028
0.80A.
620
-004
6.27A.
-013
17.19 Ac
202.3
-009
1.06A.
-007
9.00A.
Ac. Corr
per survey
By Gary Penfound
C=1:100,000.
A.C. CORR.
-031
18.34A.
20.40
-005
10.34A.
DETAIL
64.46
696.75
TURNPIKE
-011
18.32 Ac
76
-024
2.86A.
-016
3.36A.
-018
.59A.
OHIO
-015
9.5A
-019
14.30A.
-025
10.86Ac
-030
6.43 A.
-001
1.69A.
749.40
Blymic Corp Line
11/26/90
#18953-A
APPROVED
LORAIN CO.
MAP DEPT.
DATE 5-21 90
PAGE 5-D
BY CAROLYN FRANCIS
VOID AFTER # 18953-A
05-00-076-000-031
18953-A