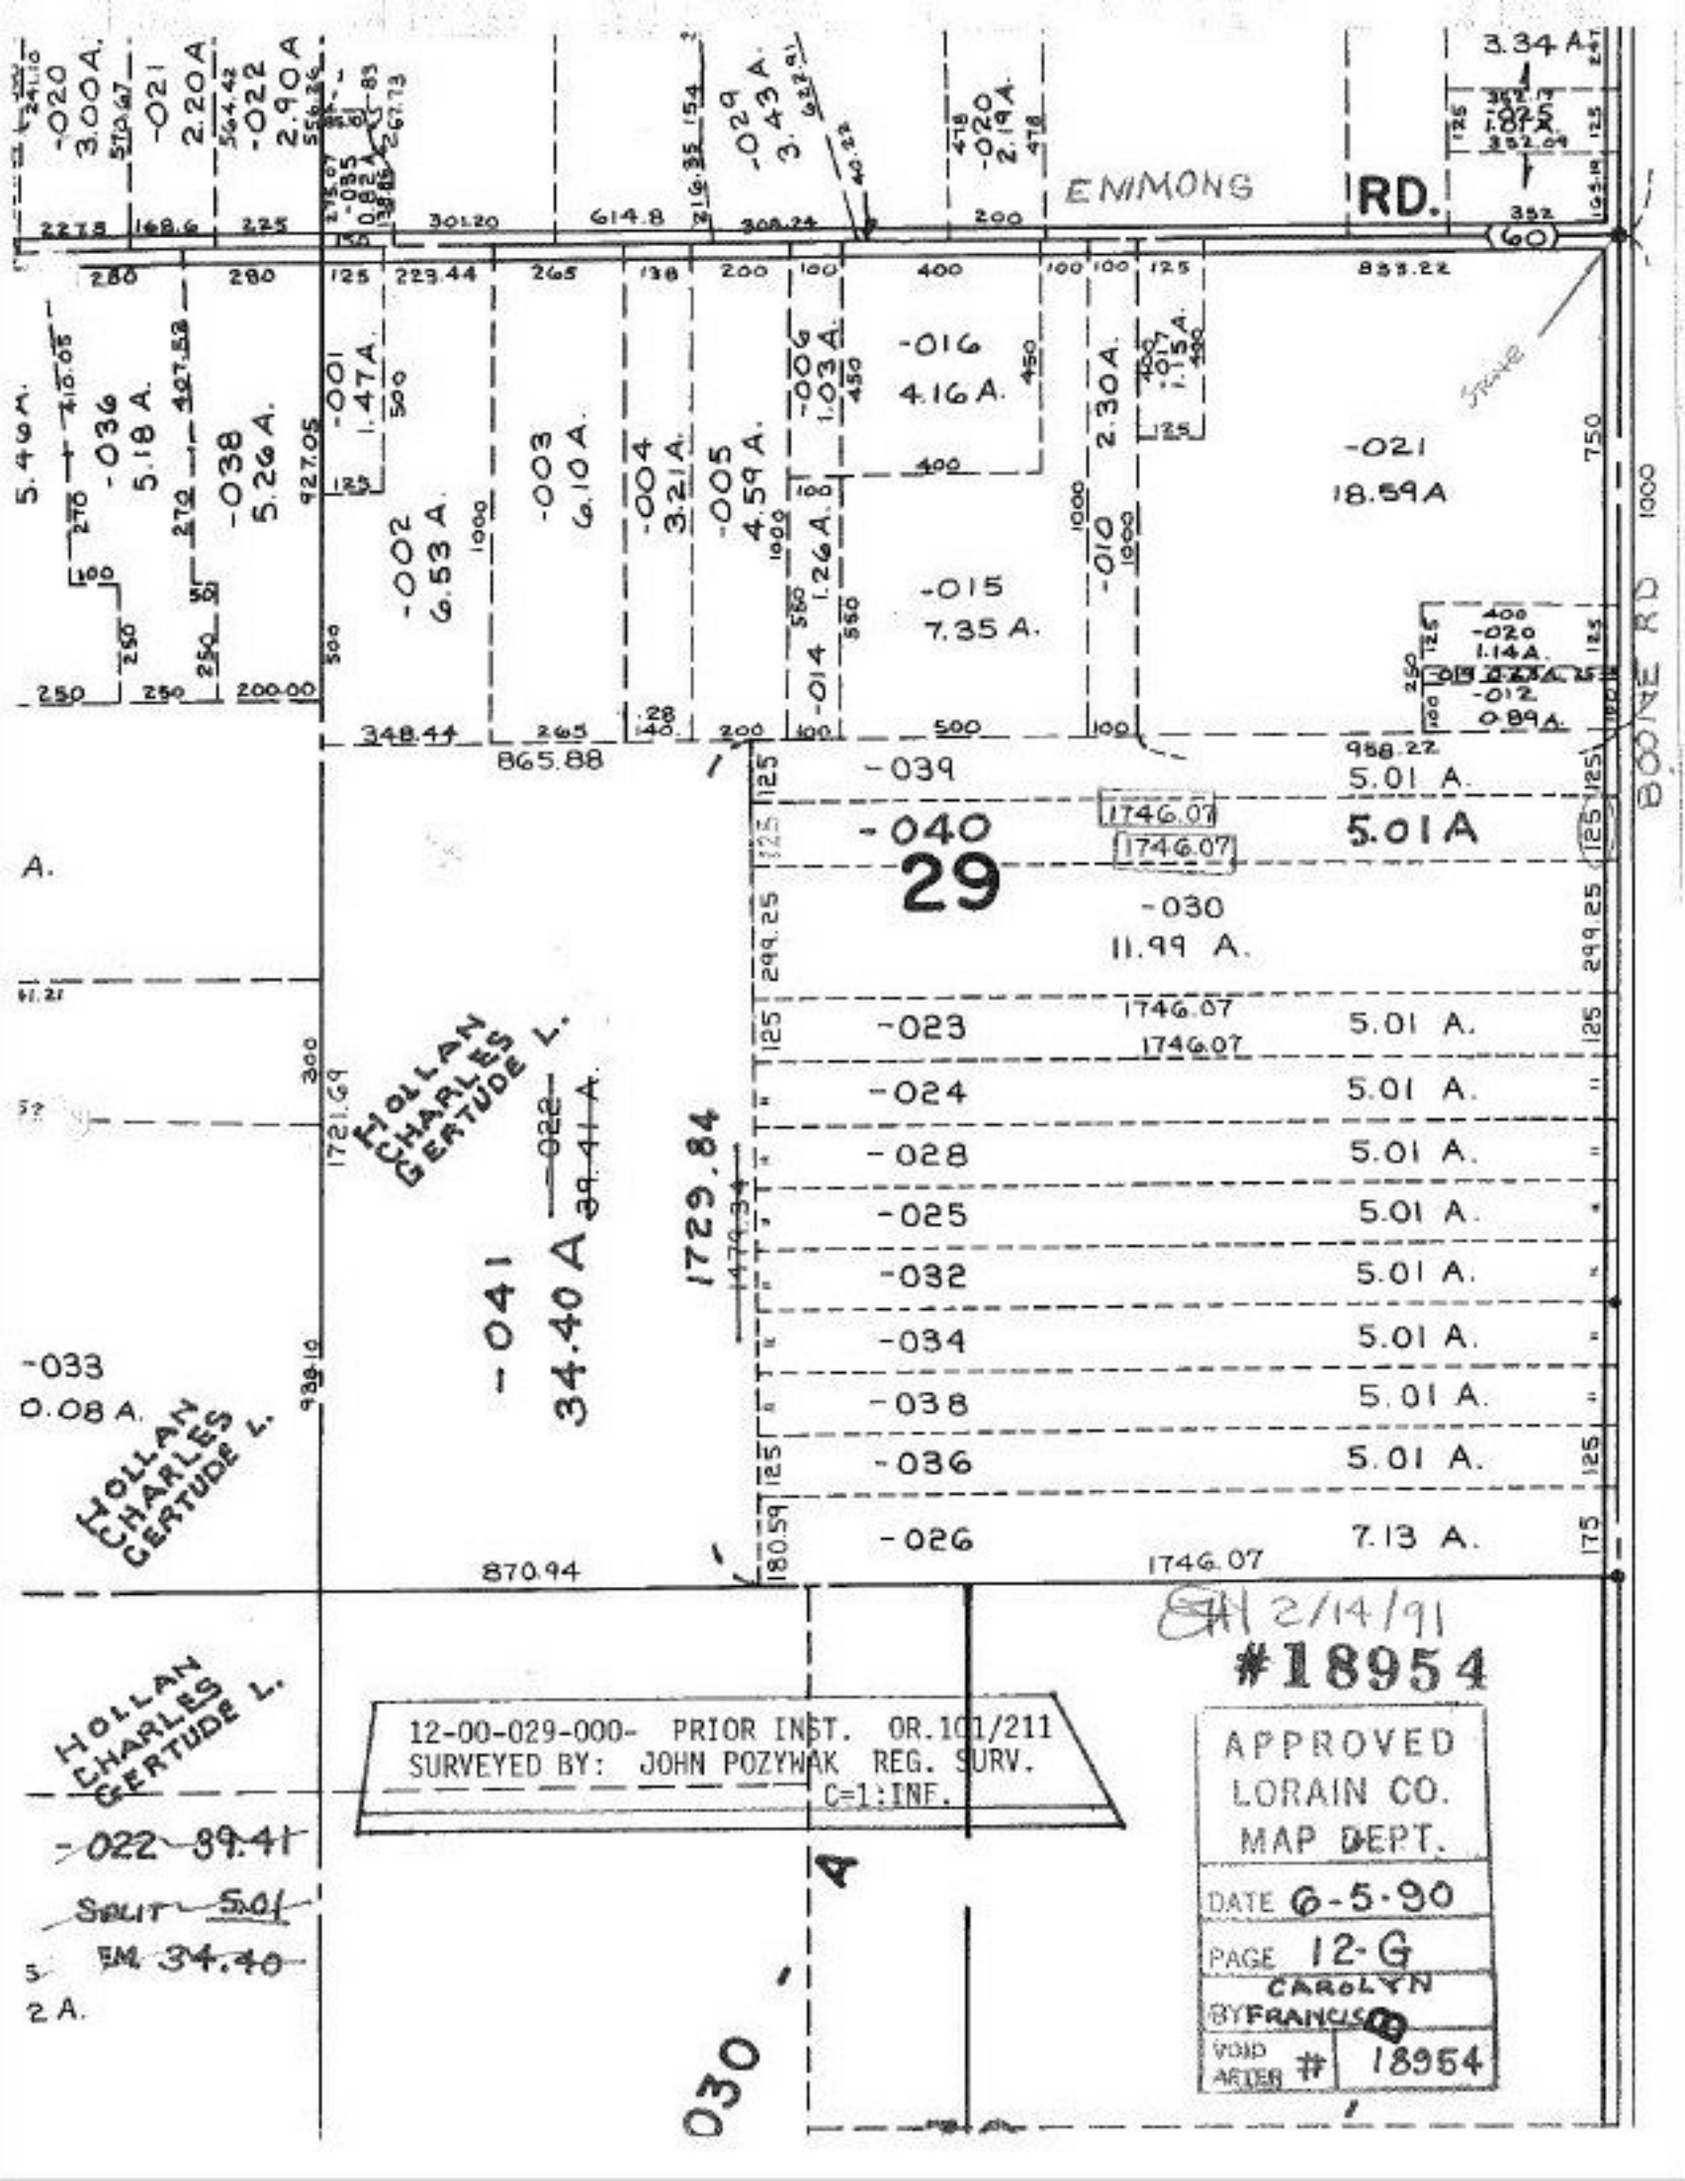
EMMONS RD.
BOOKE RD
-020 3.00A.
-021 2.20A
-022 2.90A
-029 3.43A.
-020 2.19A.
3.34 A.
-001 1.47A.
-036 5.18 A.
-038 5.26A.
-002 6.53 A.
-003 6.10A.
-004 3.21A.
-005 4.59 A.
-006 1.03A.
-016 4.16 A.
2.30A.
-017 1.15A.
-021 18.59A
-015 7.35 A.
-014 1.26A.
-010
-020 1.14A.
-012 0.89A.
-039 5.01 A.
-040 5.01A
29
-030 11.99 A.
-023 5.01 A.
-024 5.01 A.
-028 5.01 A.
-025 5.01 A.
-032 5.01 A.
-034 5.01 A.
-038 5.01 A.
-036 5.01 A.
-026 7.13 A.
-041 34.40 A
-022 39.41 A
HOLLAN CHARLES GERTUDE L.
-033 0.08 A.
1729.84
1746.07
870.94
865.88
958.22
12-00-029-000- PRIOR INST. OR.101/211
SURVEYED BY: JOHN POZYWAK REG. SURV.
C=1:INF.
-022 39.41
SPLIT 5.01
EM 34.40
2 A.
030
2/14/91
#18954
APPROVED
LORAIN CO.
MAP DEPT.
DATE 6-5-90
PAGE 12-G
BY CAROLYN FRANCIS
VOID AFTER # 18954