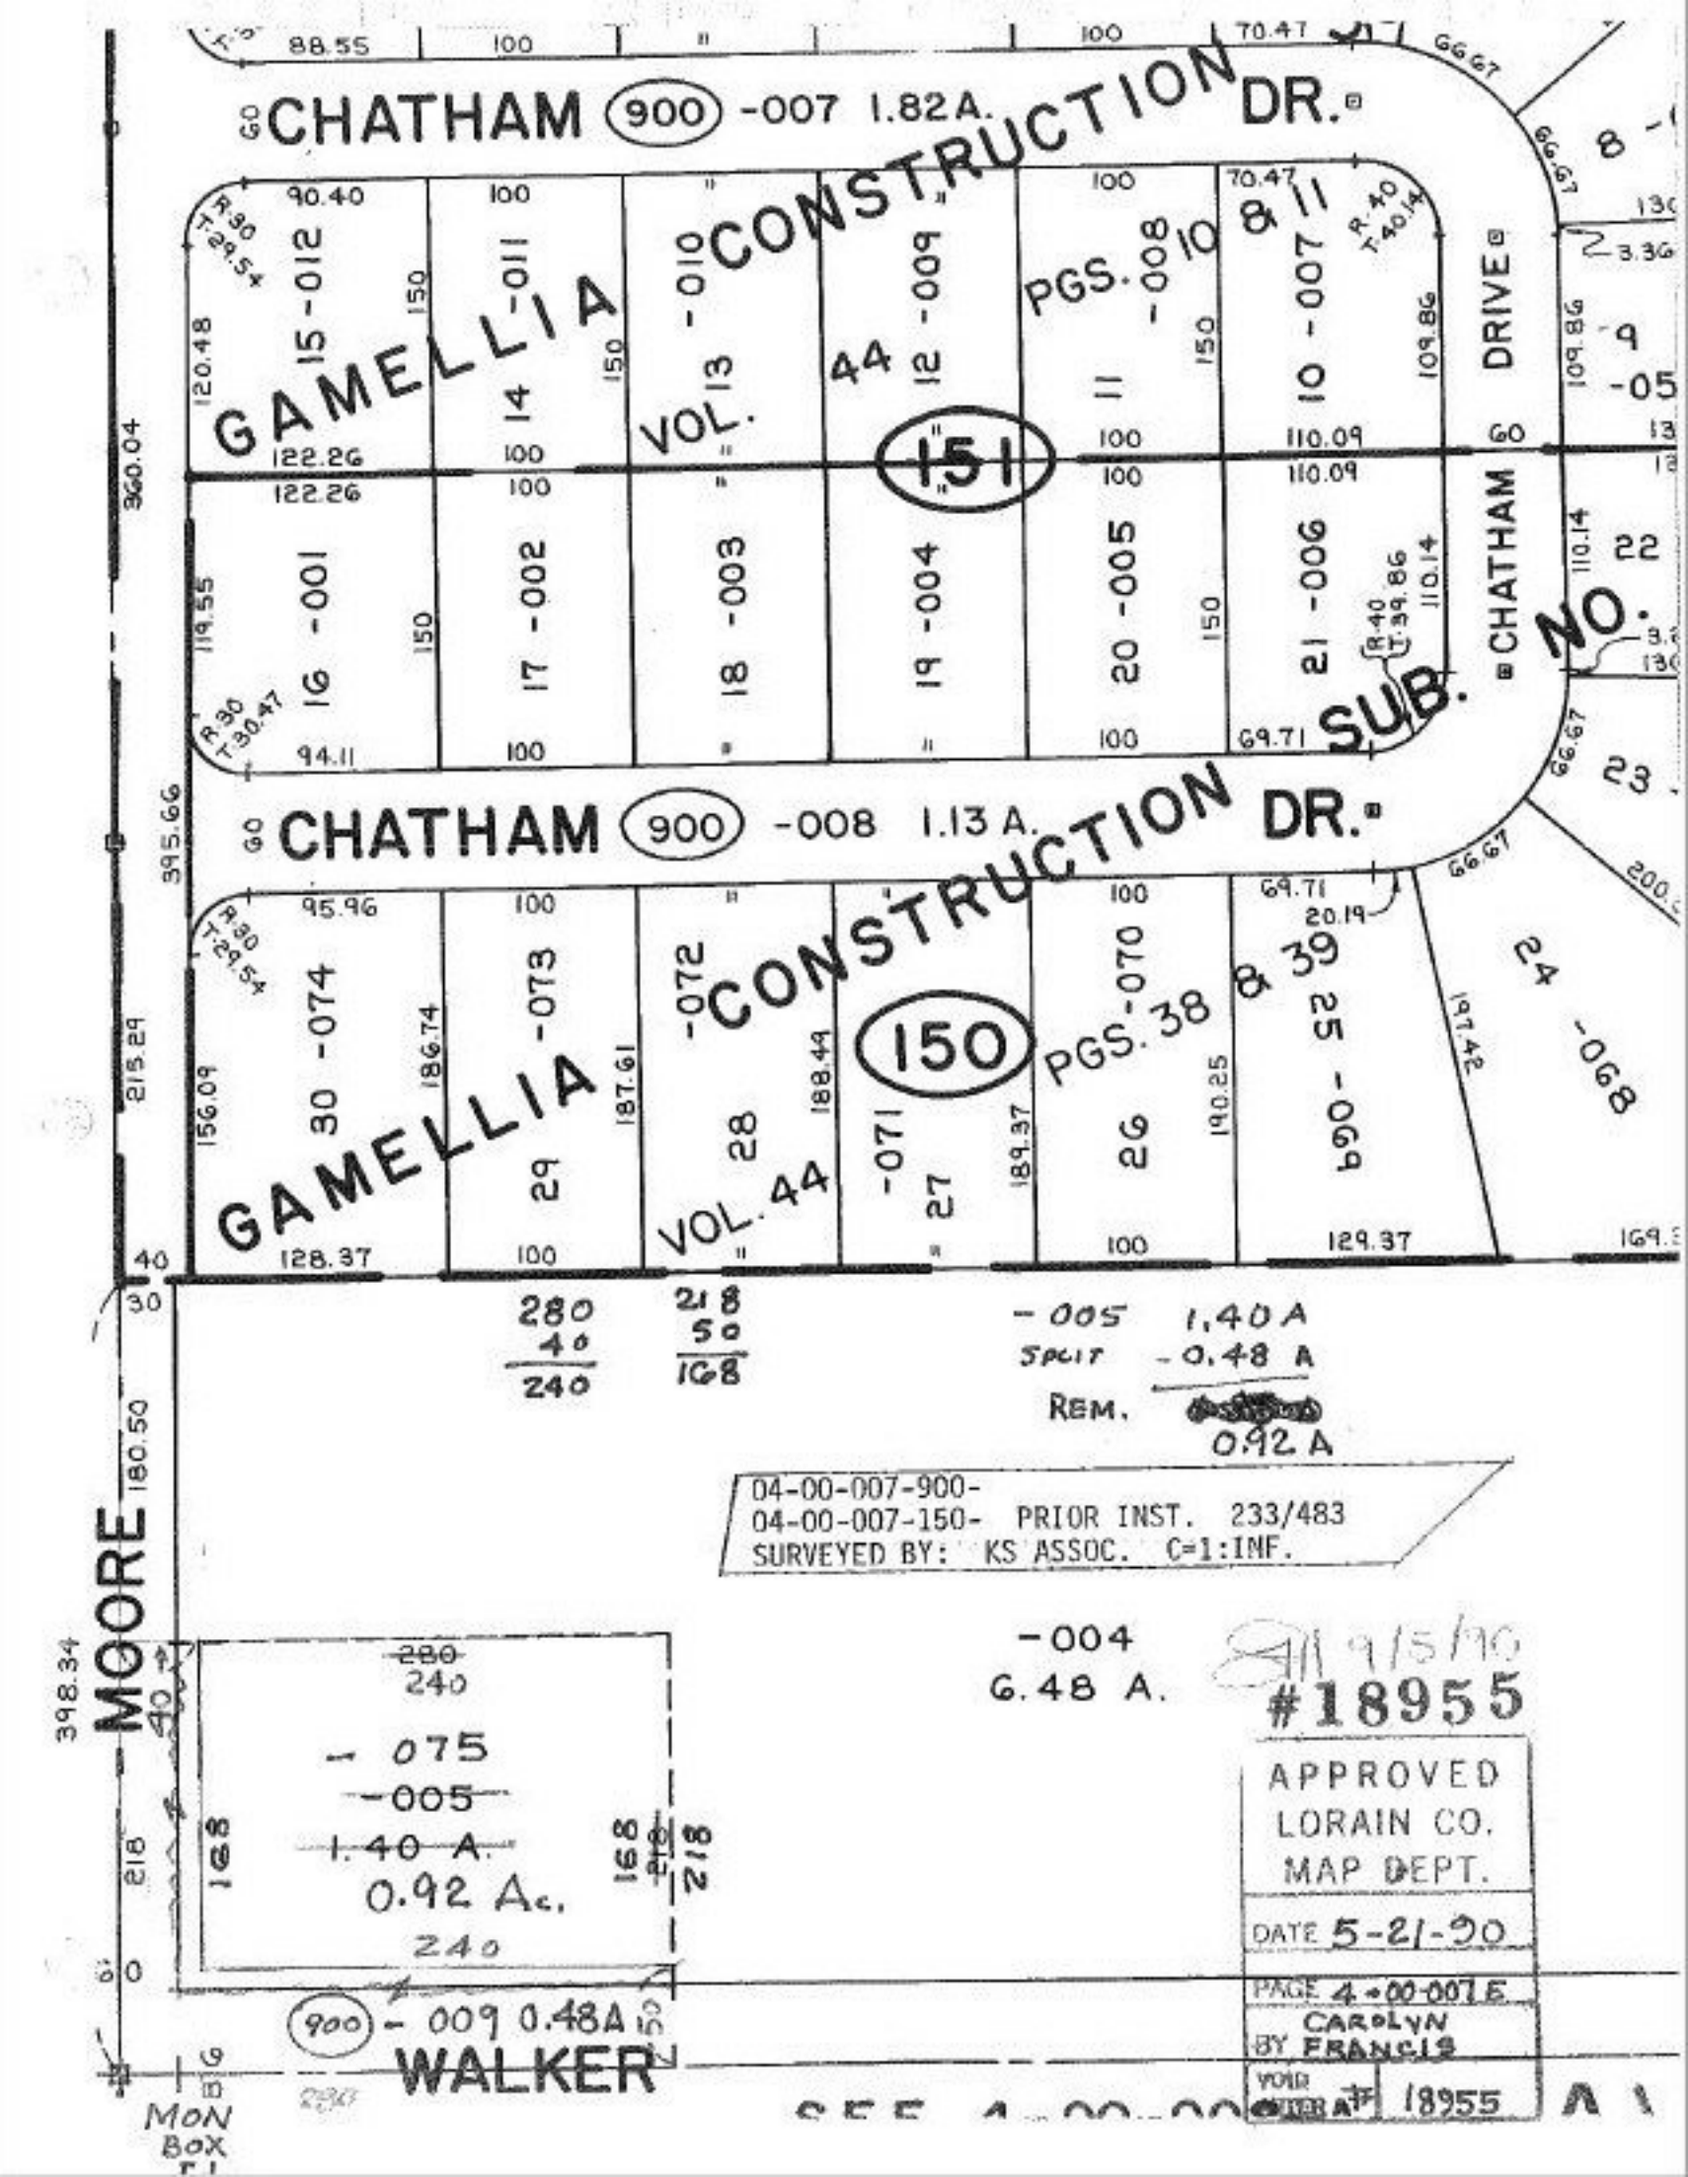
CHATHAM (900) -007 1.82A. DR.
CONSTRUCTION
GAMELLIA
VOL. 13
PGS. 10
44
151
CHATHAM DRIVE
SUB. NO.
CHATHAM (900) -008 1.13 A. DR.
CONSTRUCTION
GAMELLIA
VOL. 44
PGS. 38
150
MOORE
WALKER
-005 1.40 A
SPLIT -0.48 A
REM. 0.92 A
04-00-007-900-
04-00-007-150- PRIOR INST. 233/483
SURVEYED BY: KS ASSOC. C=1:INF.
-004
6.48 A.
-075
-005
1.40 A.
0.92 Ac.
(900) -009 0.48A
#18955
APPROVED
LORAIN CO.
MAP DEPT.
DATE 5-21-90
PAGE 4-00-007E
CAROLYN
BY FRANCIS
YOUR
OFFICE # 18955