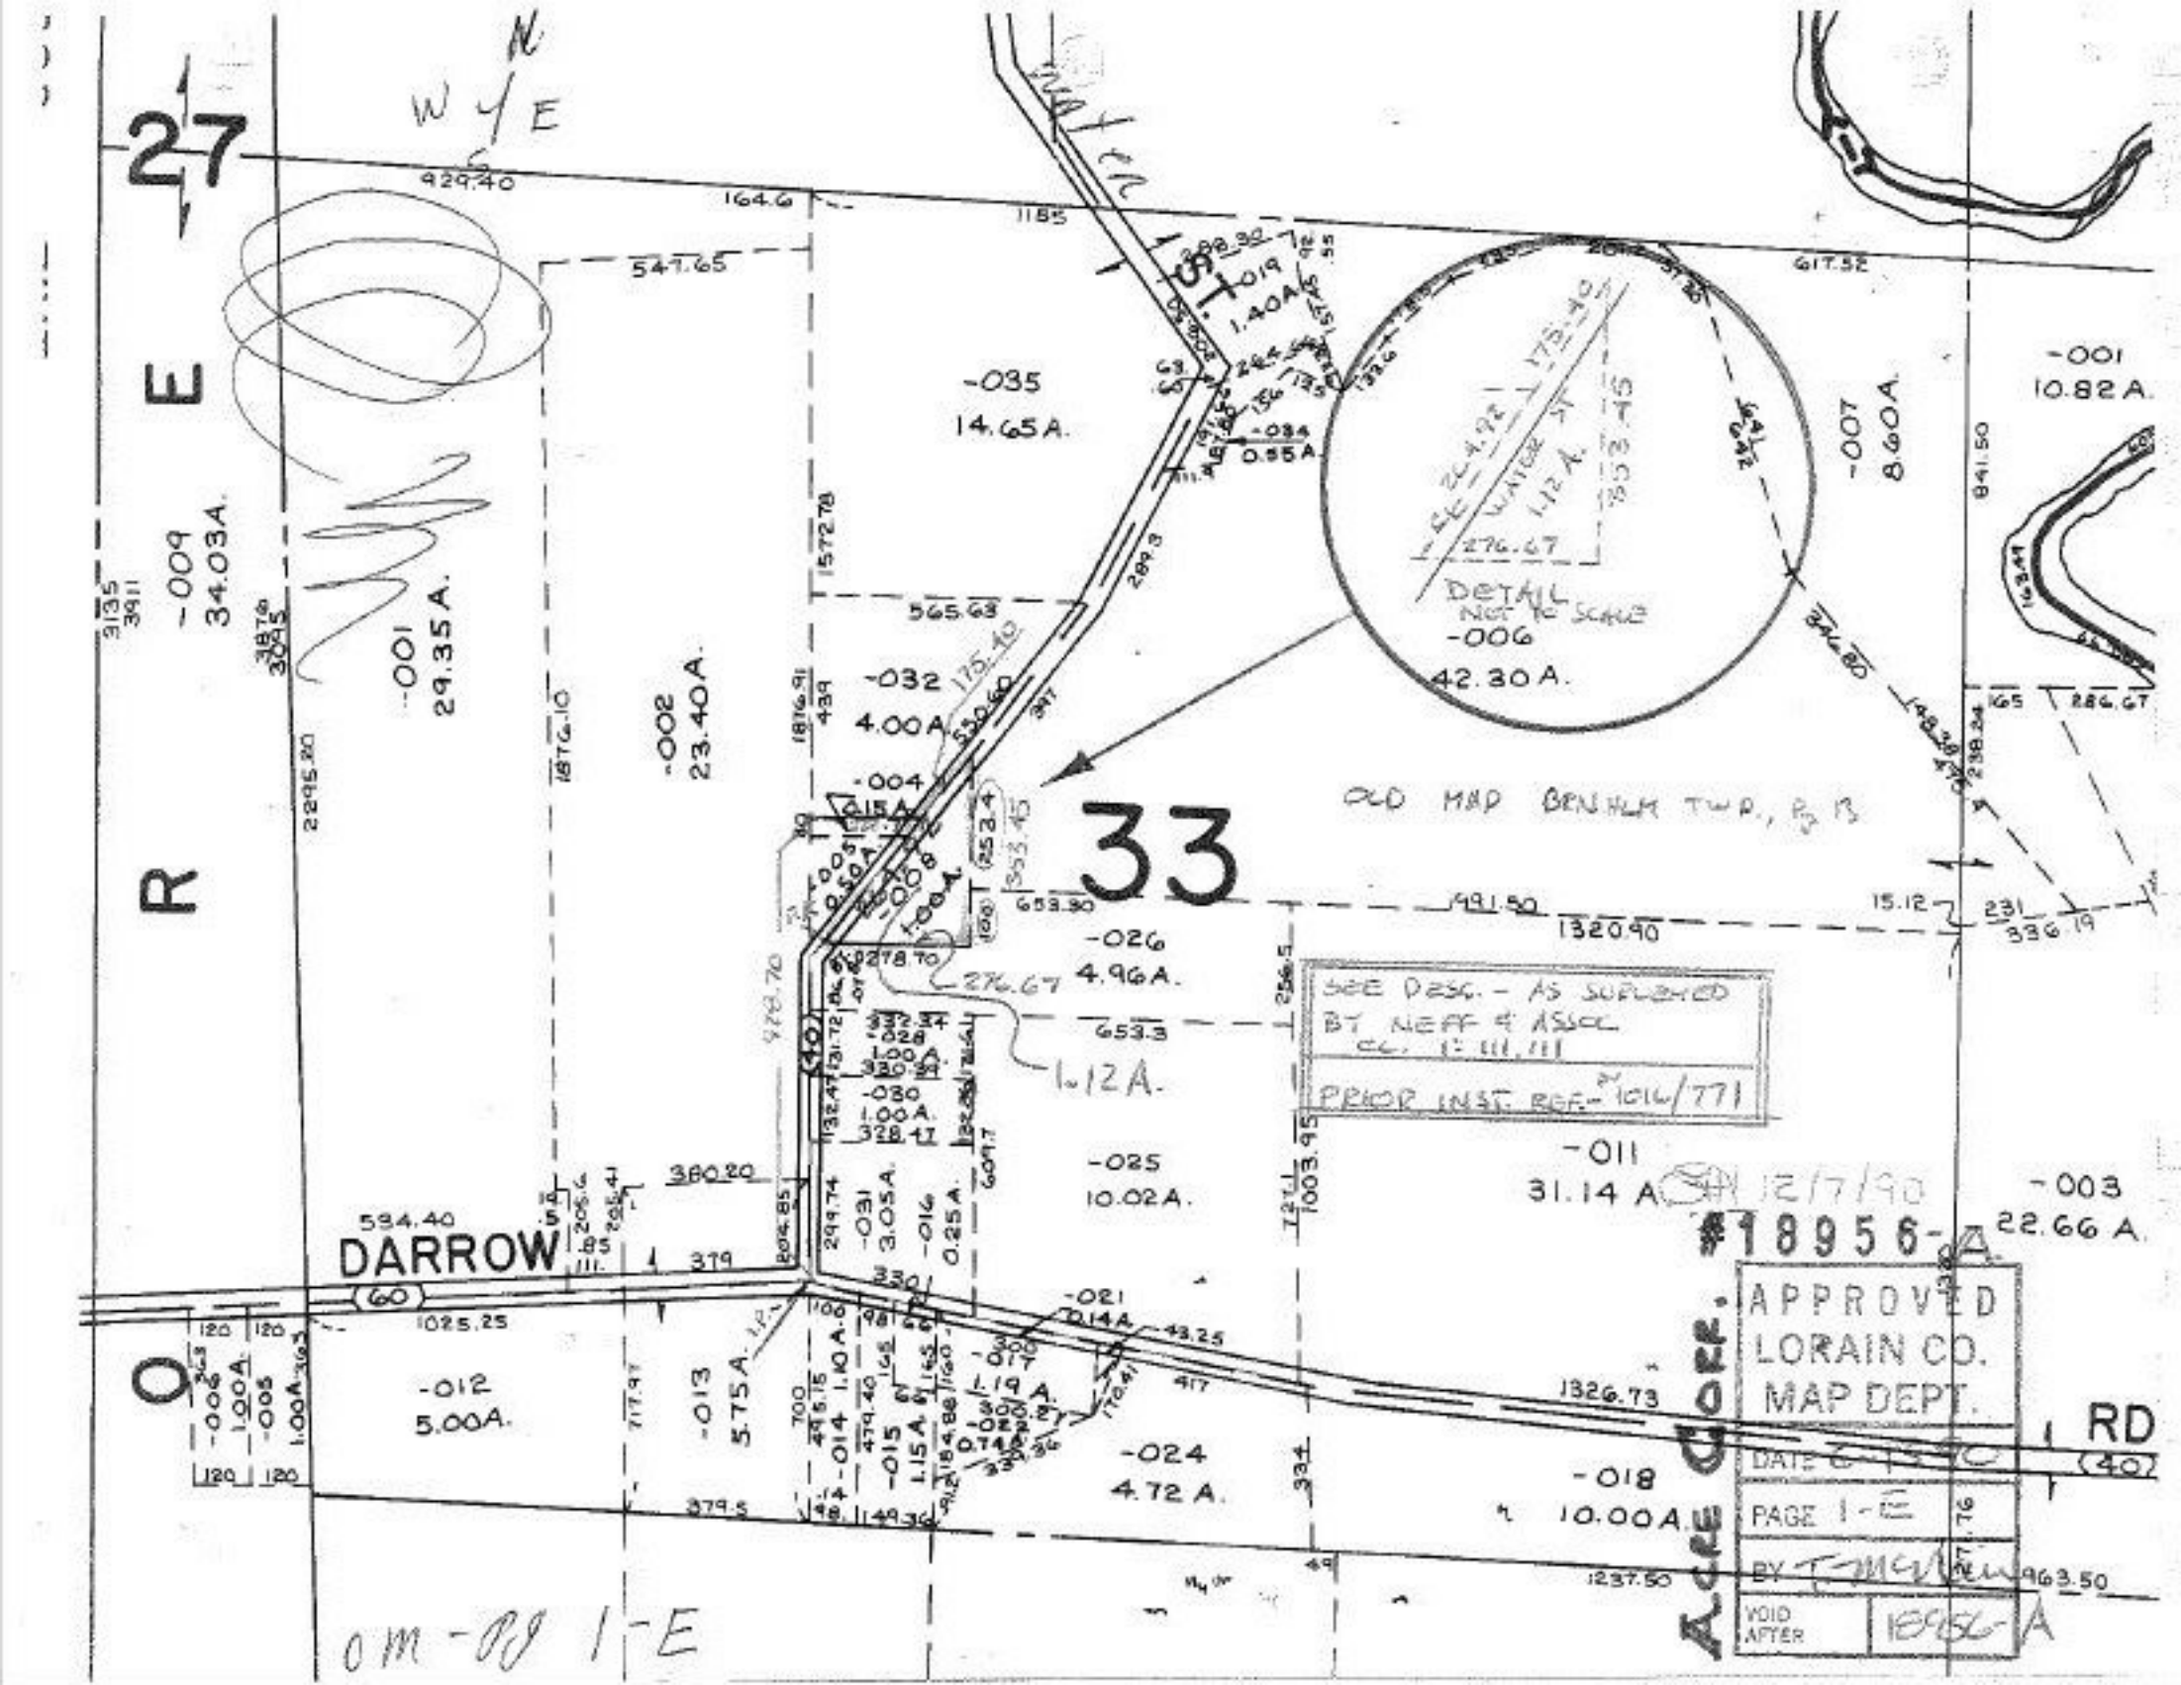

27
33
E
R
O
DARROW
RD
-035
14.65 A.
-032
4.00 A.
-004
-026
4.96 A.
-025
10.02 A.
-011
31.14 A.
-003
22.66 A.
-012
5.00 A.
-013
5.75 A.
-024
4.72 A.
-018
10.00 A.
-009
34.03 A.
-001
29.35 A.
-002
23.40 A.
-007
8.60 A.
-001
10.82 A.
-006
42.30 A.
DETAIL
NOT TO SCALE
OLD MAP BRN HLM TWP., Pg 13
SEE DESC. - AS SUPLEMED
BY NEFF & ASSOC
PRIOR INST. REF. 1016/771
12/7/90
#18956-A
APPROVED
LORAIN CO.
MAP DEPT.
DATE
PAGE 1-E
BY
VOID AFTER
18956-A
ACRE CORP.
OM-Pg 1-E