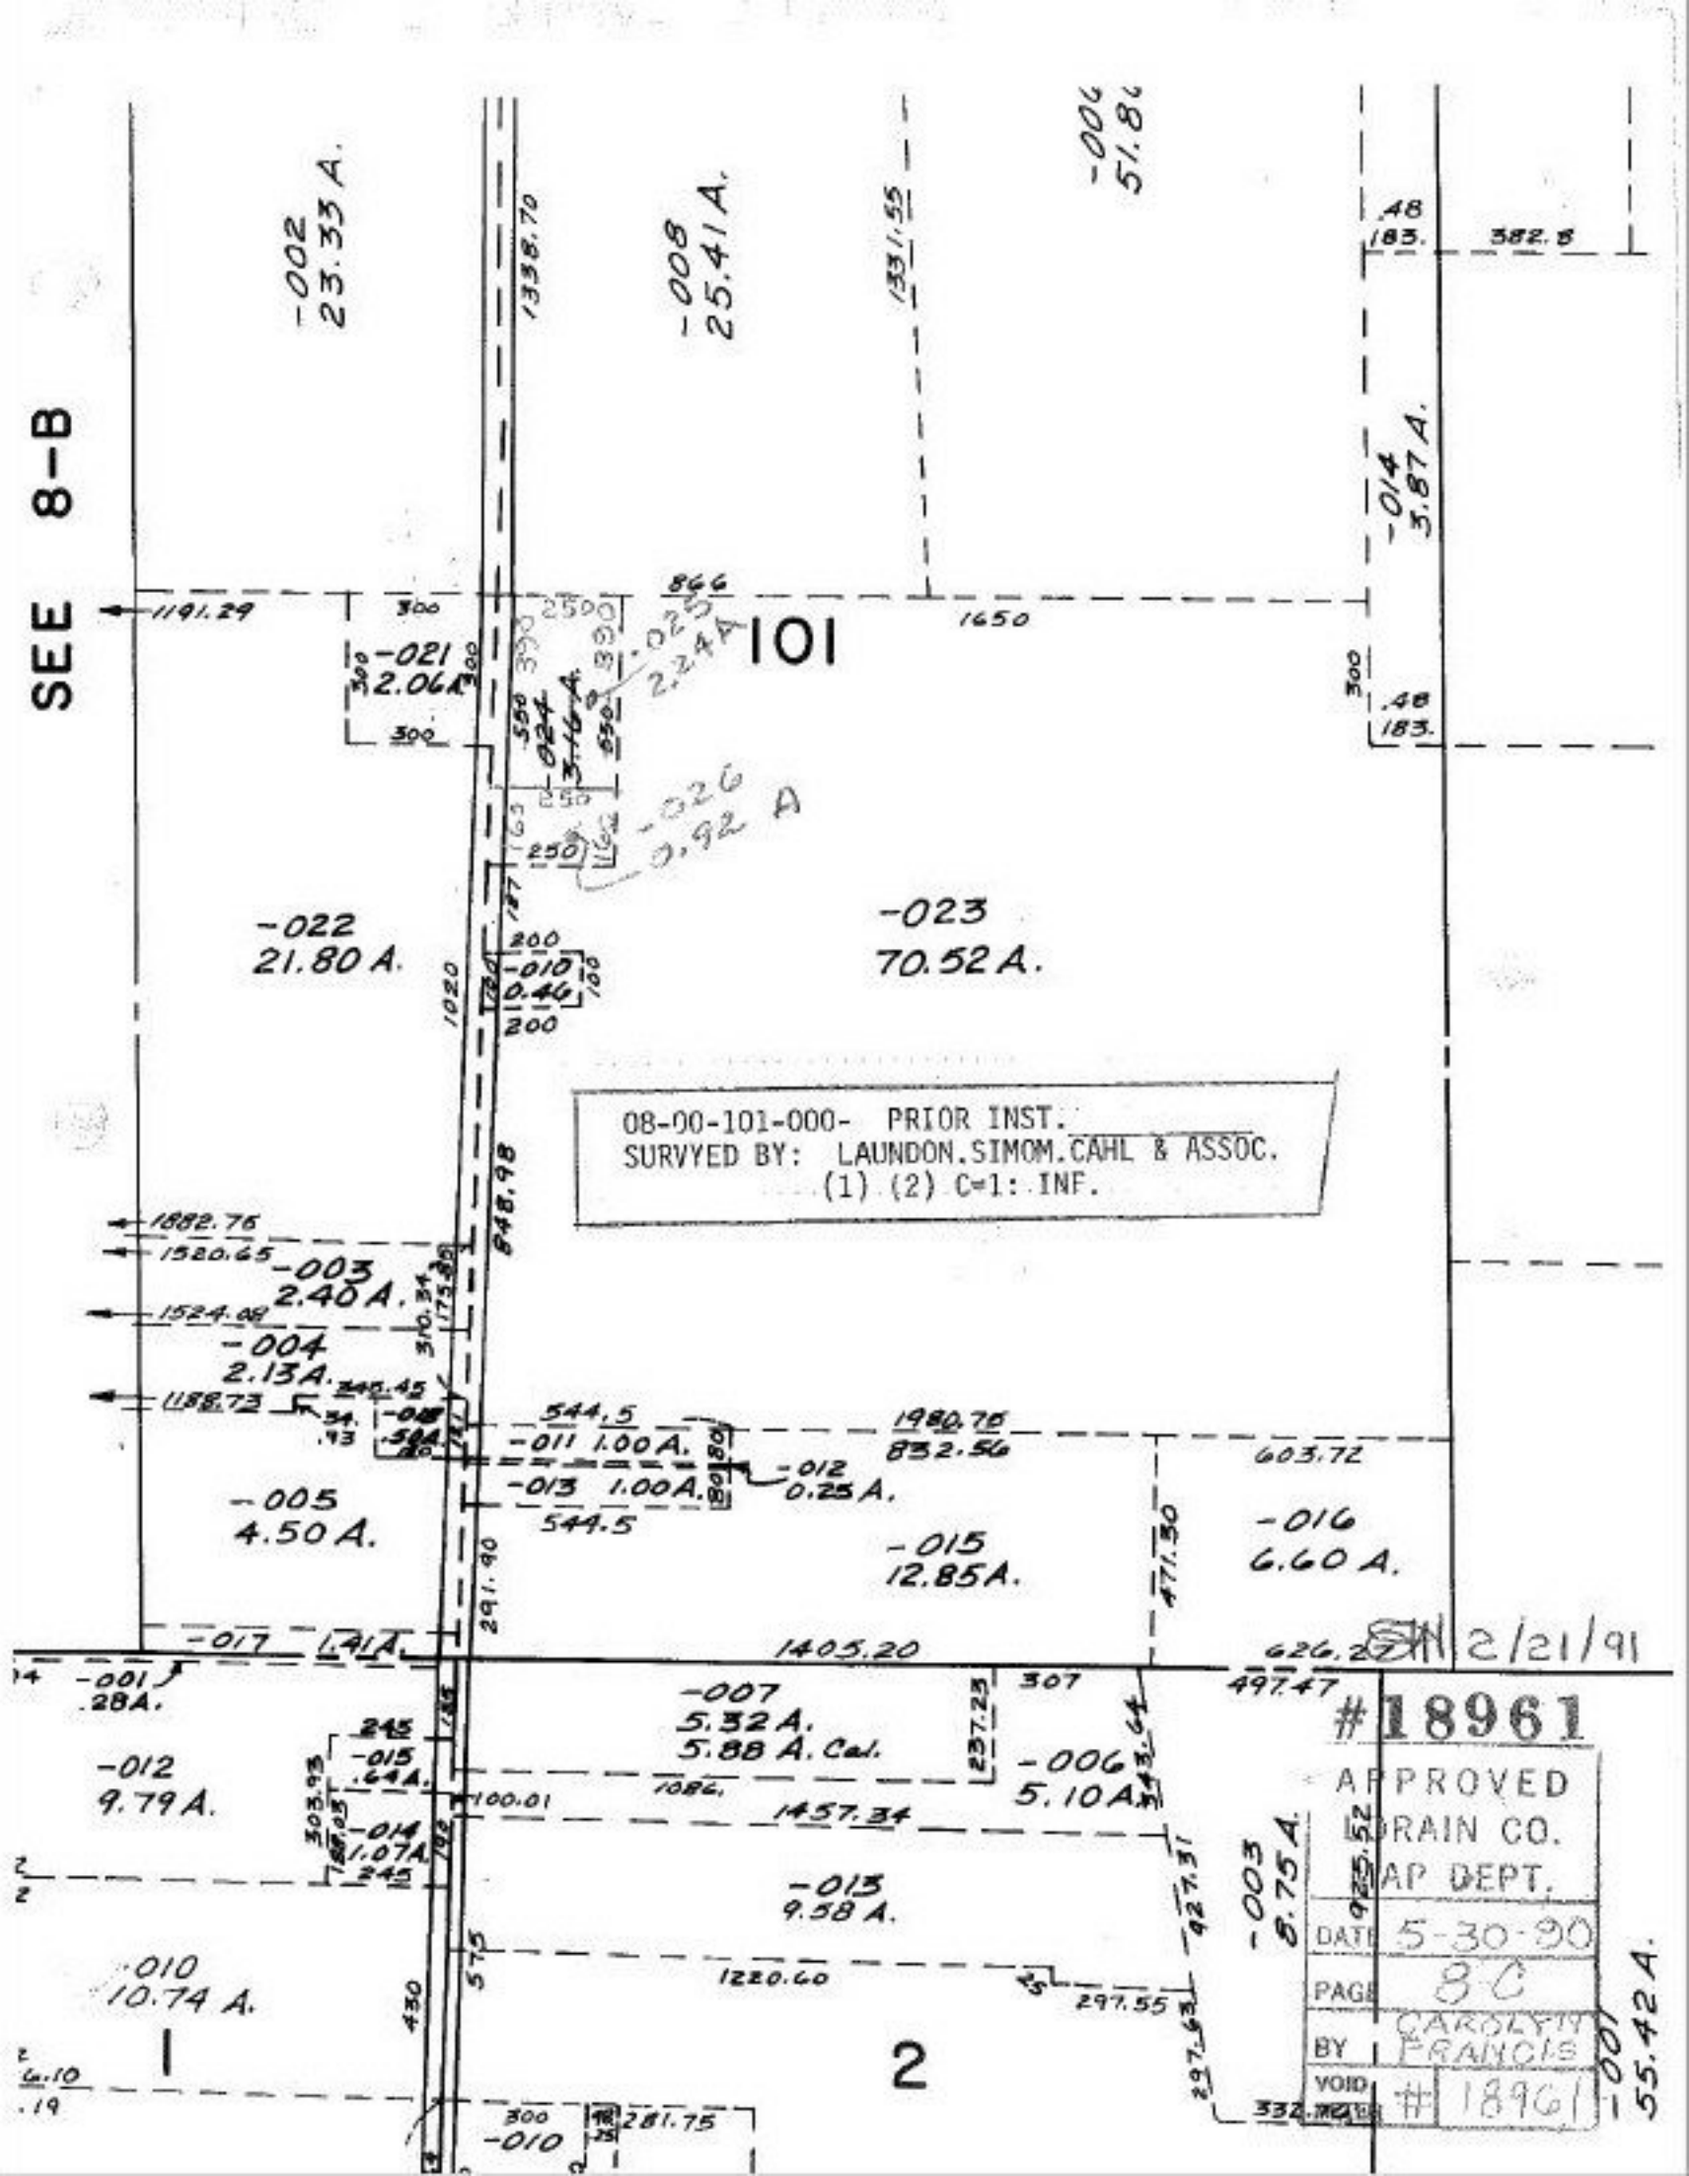
SEE 8-B
-002 23.33 A.
-008 25.41 A.
-006 51.8
-014 3.87 A.
-021 2.06 A.
-025 2.24 A.
-026 0.92 A
101
-022 21.80 A.
-023 70.52 A.
-010 0.46
08-00-101-000- PRIOR INST.
SURVYED BY: LAUNDON.SIMOM.CAHL & ASSOC.
(1) (2) C=1: INF.
-003 2.40 A.
-004 2.13A.
-008
-011 1.00 A.
-012 0.25 A.
-013 1.00 A.
-005 4.50 A.
-015 12.85A.
-016 6.60 A.
-017 1.41A
-001 .28A.
-007 5.32 A. 5.88 A. Cal.
-006 5.10A
-012 9.79 A.
-014 1.07A.
-015 .64A.
-013 9.58 A.
-003 8.75 A.
-010 10.74 A.
-001 55.42 A.
1
2
SW 2/21/91
#18961
APPROVED
DRAIN CO.
MAP DEPT.
DATE 5-30-90
PAGE 8C
BY CAROLYN FRANCIS
VOID # 18961