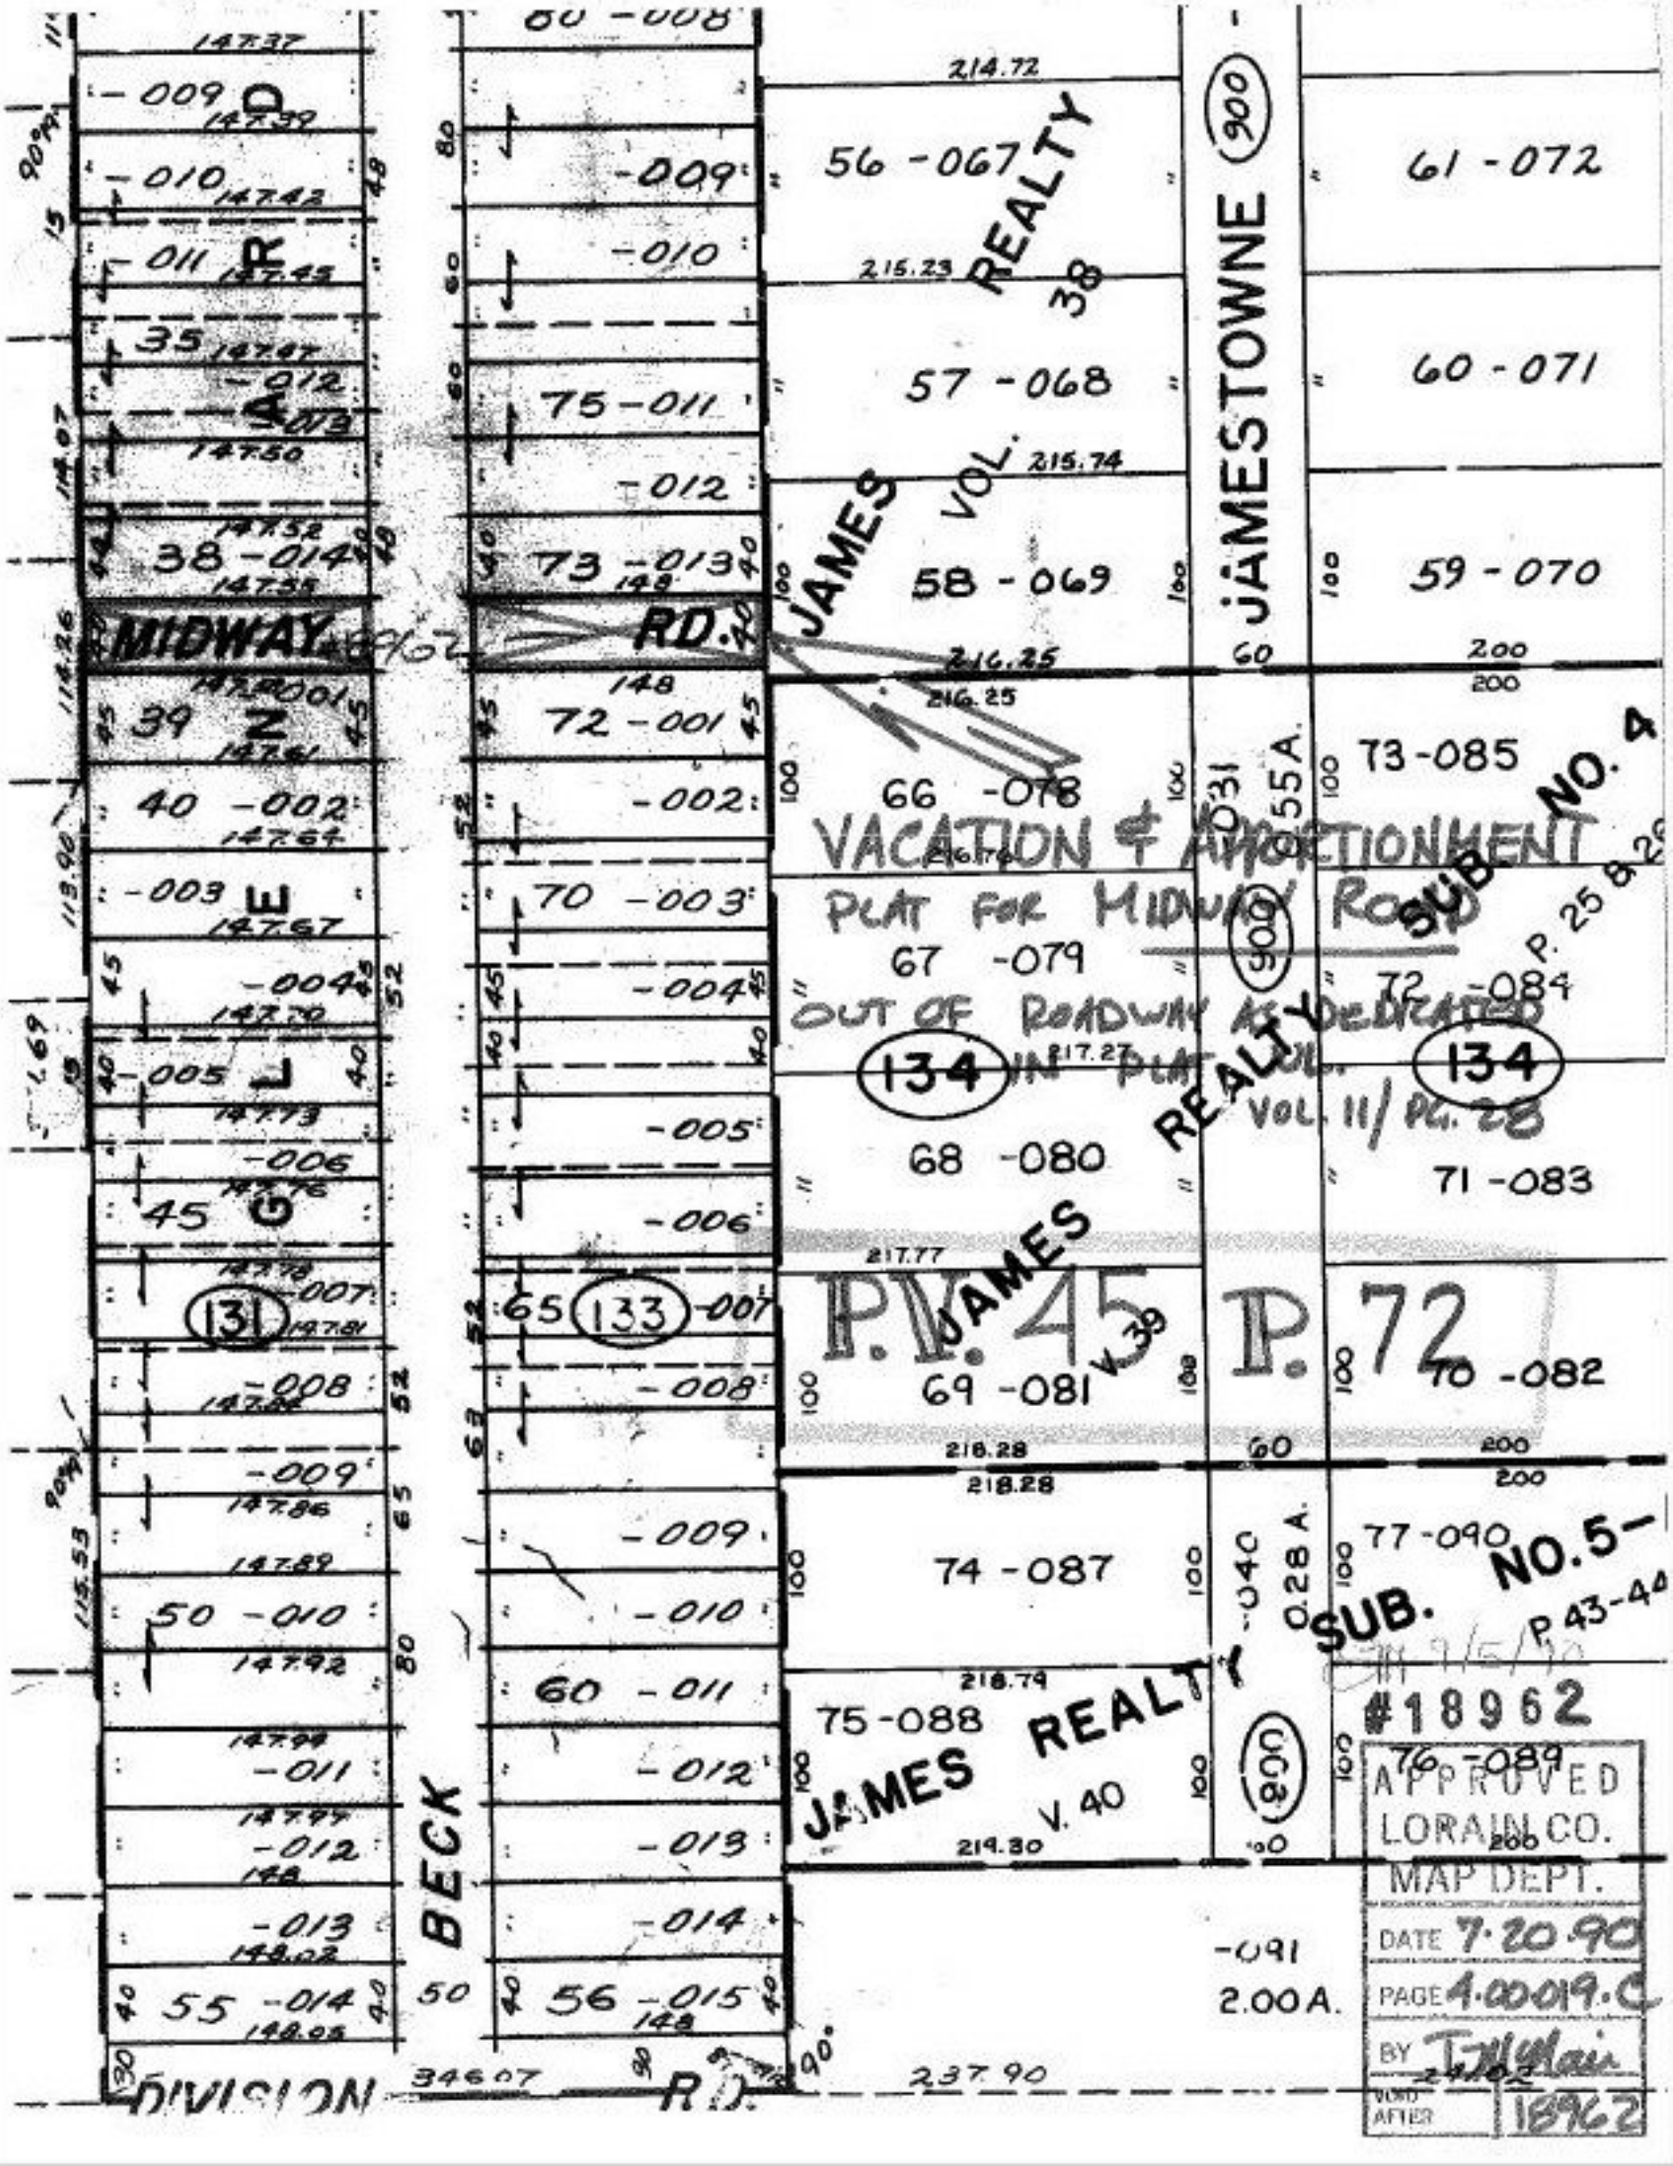

MIDWAY RD.
BECK
DIVISION RD.
JAMES REALTY
VOL. 38
JAMESTOWNE
JAMES REALTY
VOL. 11/ PG. 28
JAMES REALTY
V. 39
V. 40
SUB. NO. 4
P. 25 & 26
SUB. NO. 5-
P. 43-44
VACATION & APPORTIONMENT
PLAT FOR MIDWAY ROAD
OUT OF ROADWAY AS DEDICATED
IN PLAT VOL.
P.V. 45 P. 72
#18962
APPROVED
LORAIN CO.
MAP DEPT.
DATE 7·20·90
PAGE 4.00019.C
BY
VOID AFTER 18962