-116
9.78 A.

VAC. EDWARD CT 88-56
Transfer To SECOND BAPTIST CHURCH
Assign P.P. No.

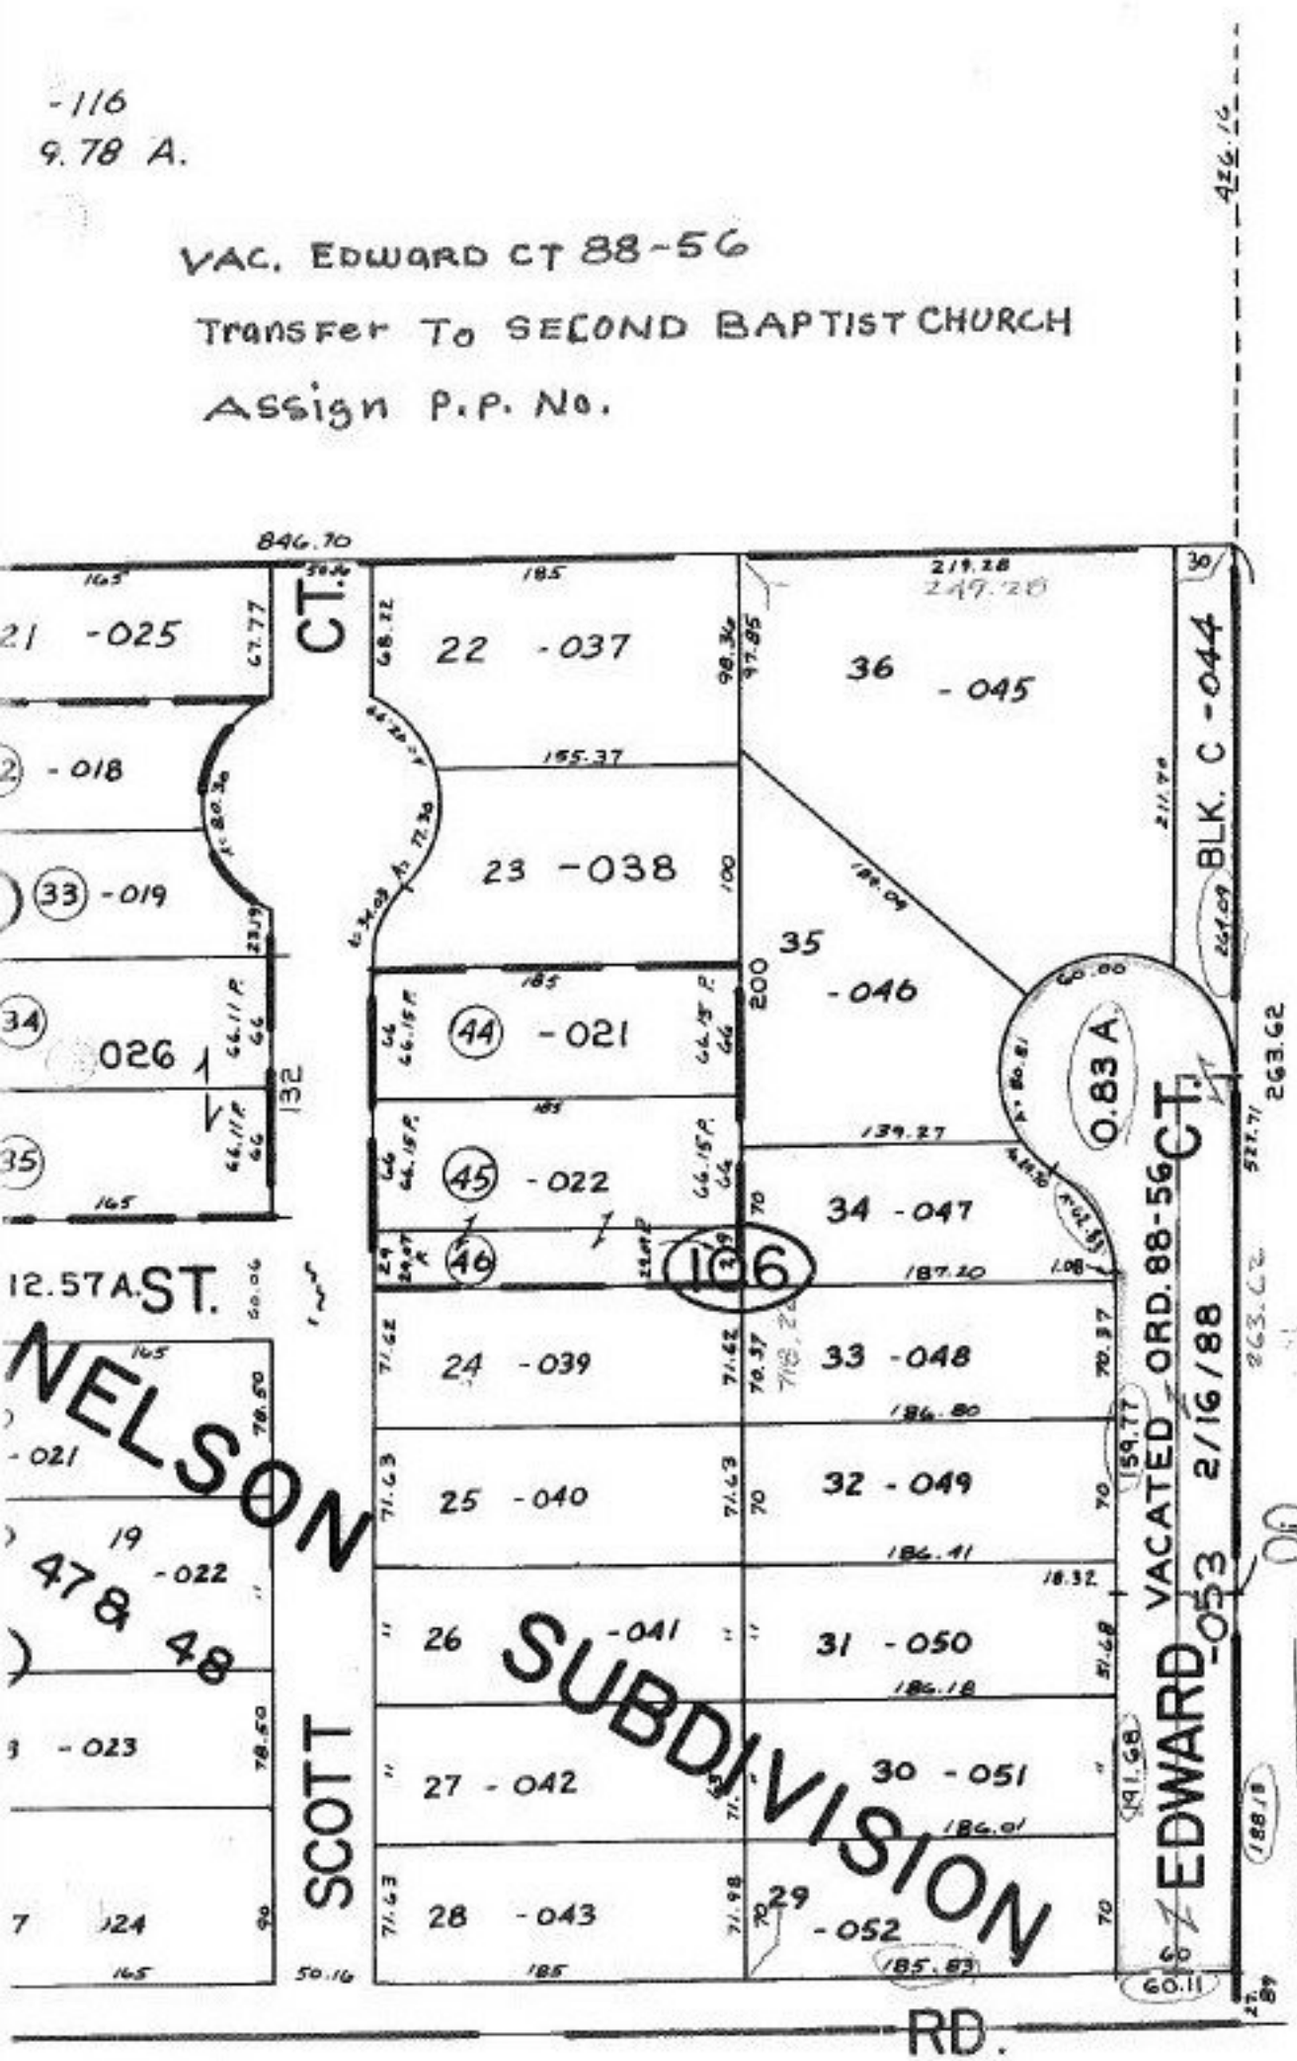

9/17/90
#18968

APPROVED
LORAIN CO.
MAP DEPT.
DATE 6-1-90
PAGE 10-00-004- A
BY CAROLYN FRANCIS
VOID AFTER # 18968

10-00-004-F

10-00-004-A