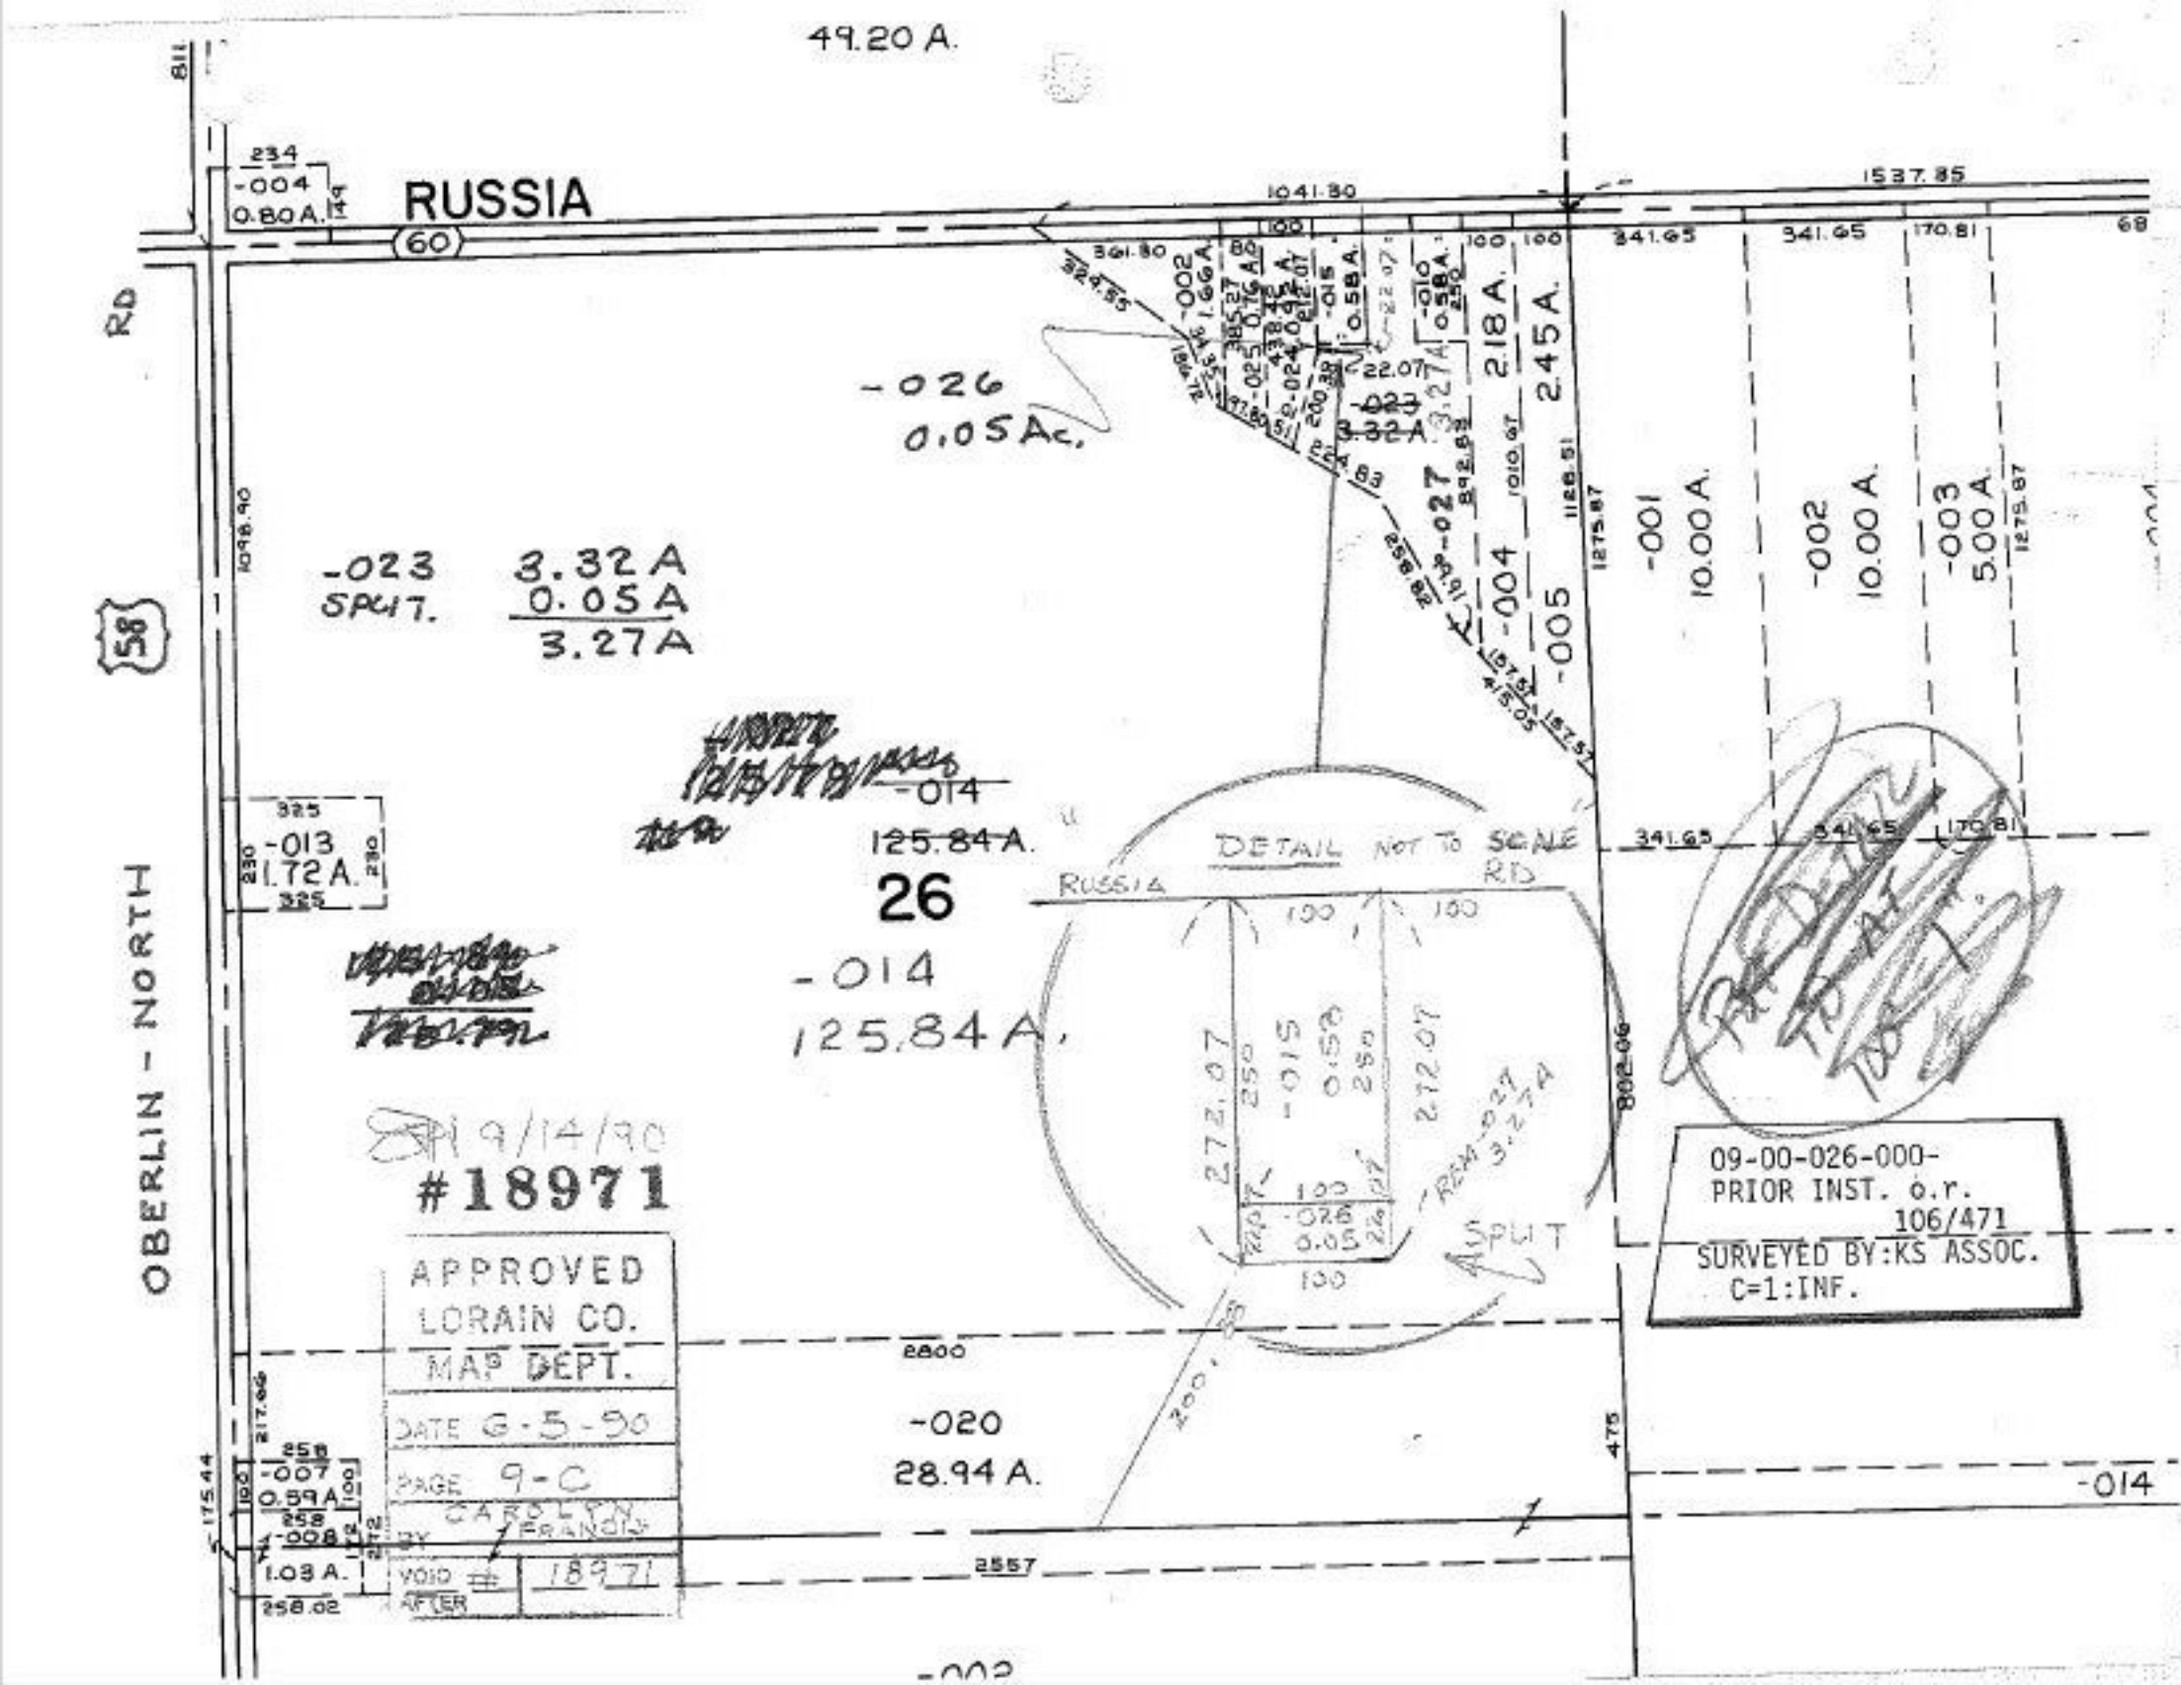
49.20 A.
RUSSIA
60
OBERLIN - NORTH
RD
58
-004
0.80A.
-026
0.05Ac.
-023
SPLIT.
3.32A
0.05A
3.27A
-014
125.84A.
26
-014
125.84A.
-013
1.72A.
-007
0.59A
-008
1.03A.
-020
28.94A.
-001
10.00A.
-002
10.00A.
-003
5.00A.
-004
-005
2.18A.
2.45A.
DETAIL NOT TO SCALE
RUSSIA RD
09-00-026-000-
PRIOR INST. o.r.
106/471
SURVEYED BY:KS ASSOC.
C=1:INF.
APPROVED
LORAIN CO.
MAP DEPT.
DATE 6-5-90
PAGE 9-C
BY CAROLYN FRANCIS
VOID AFTER
18971
9/14/90
#18971