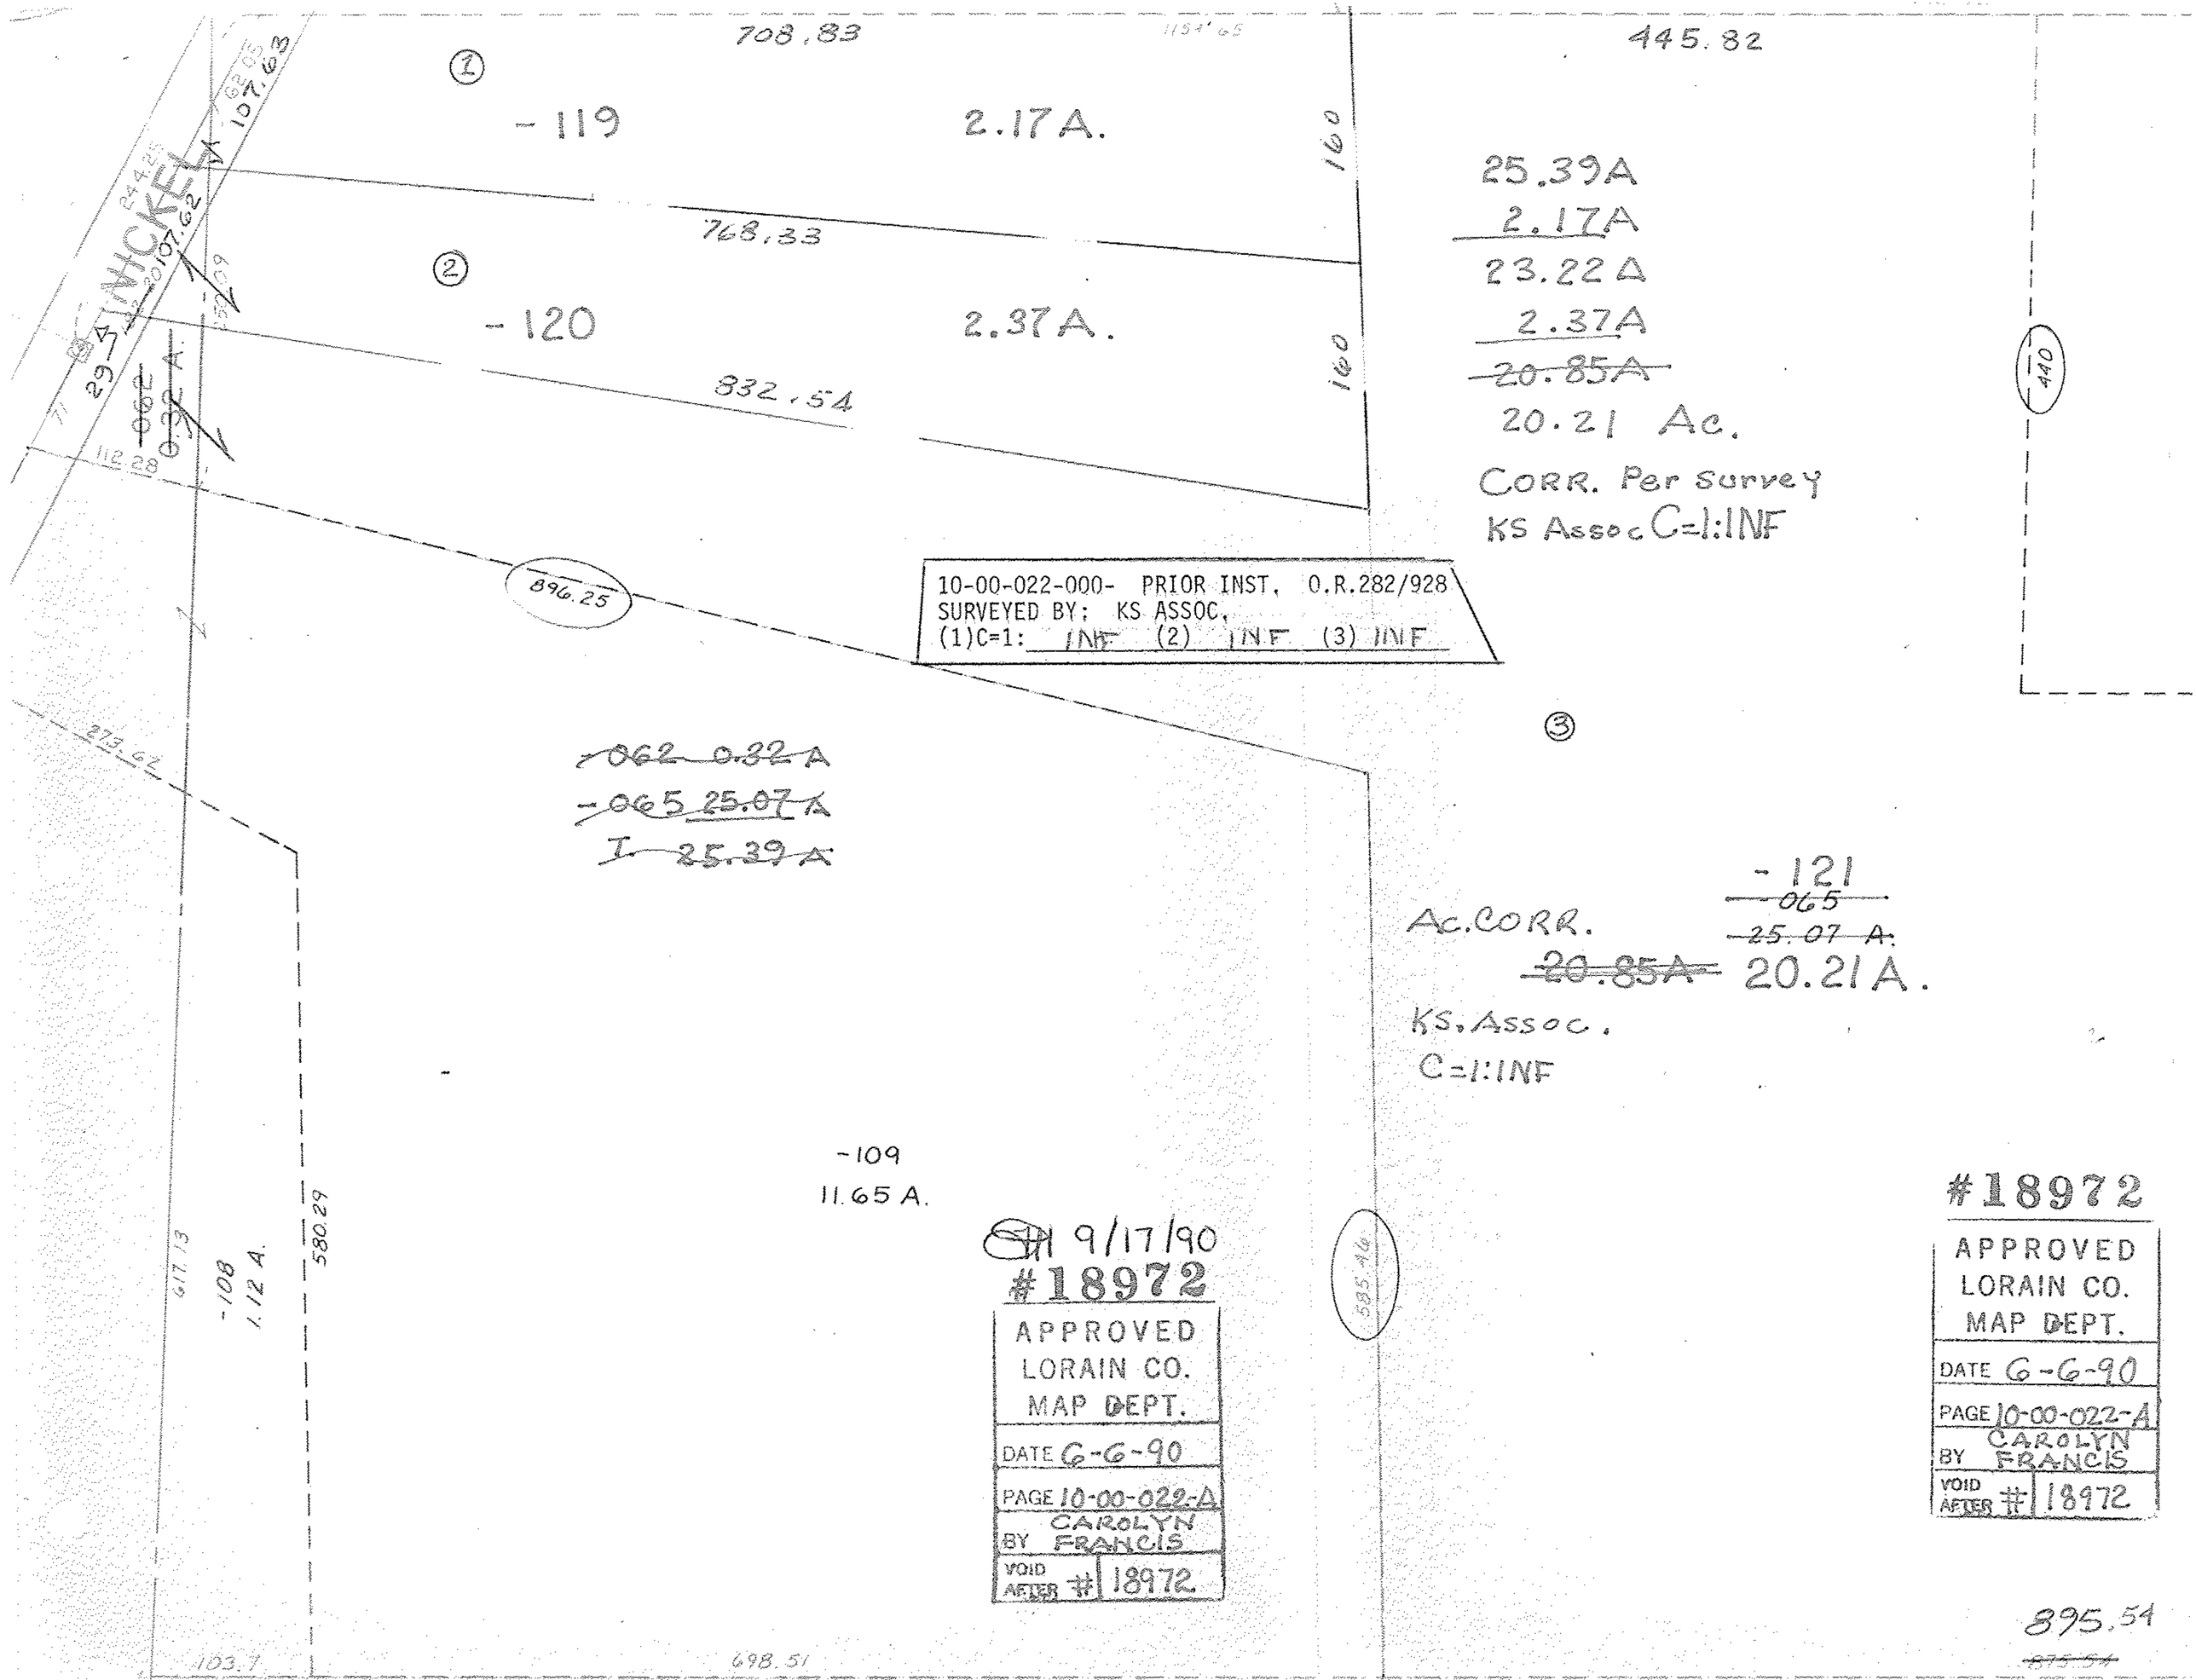

708.83
445.82
1
-119
2.17A.
160
768.33
2
-120
2.37A.
160
832.54
25.39A
2.17A
23.22A
2.37A
~~20.85A~~
20.21 Ac.
CORR. Per survey
KS Assoc C=1:INF
440
NICKEL
107.63
107.62
29
~~062~~
~~0.32 A.~~
112.28
896.25
10-00-022-000- PRIOR INST. O.R.282/928
SURVEYED BY: KS ASSOC.
(1)C=1: INF (2) INF (3) INF
273.62
3
~~062 0.32 A~~
~~-065 25.07 A~~
~~I. 25.39 A~~
-121
~~-065~~
~~25.07 A.~~
Ac.CORR.
~~20.85A~~ 20.21A.
KS. Assoc.
C=1:INF
-109
11.65 A.
617.13
-108
1.12 A.
580.29
585.46
9/17/90
#18972
APPROVED
LORAIN CO.
MAP DEPT.
DATE 6-6-90
PAGE 10-00-022-A
BY CAROLYN FRANCIS
VOID AFTER # 18972
#18972
APPROVED
LORAIN CO.
MAP DEPT.
DATE 6-6-90
PAGE 10-00-022-A
BY CAROLYN FRANCIS
VOID AFTER # 18972
895.54
103.7
698.51