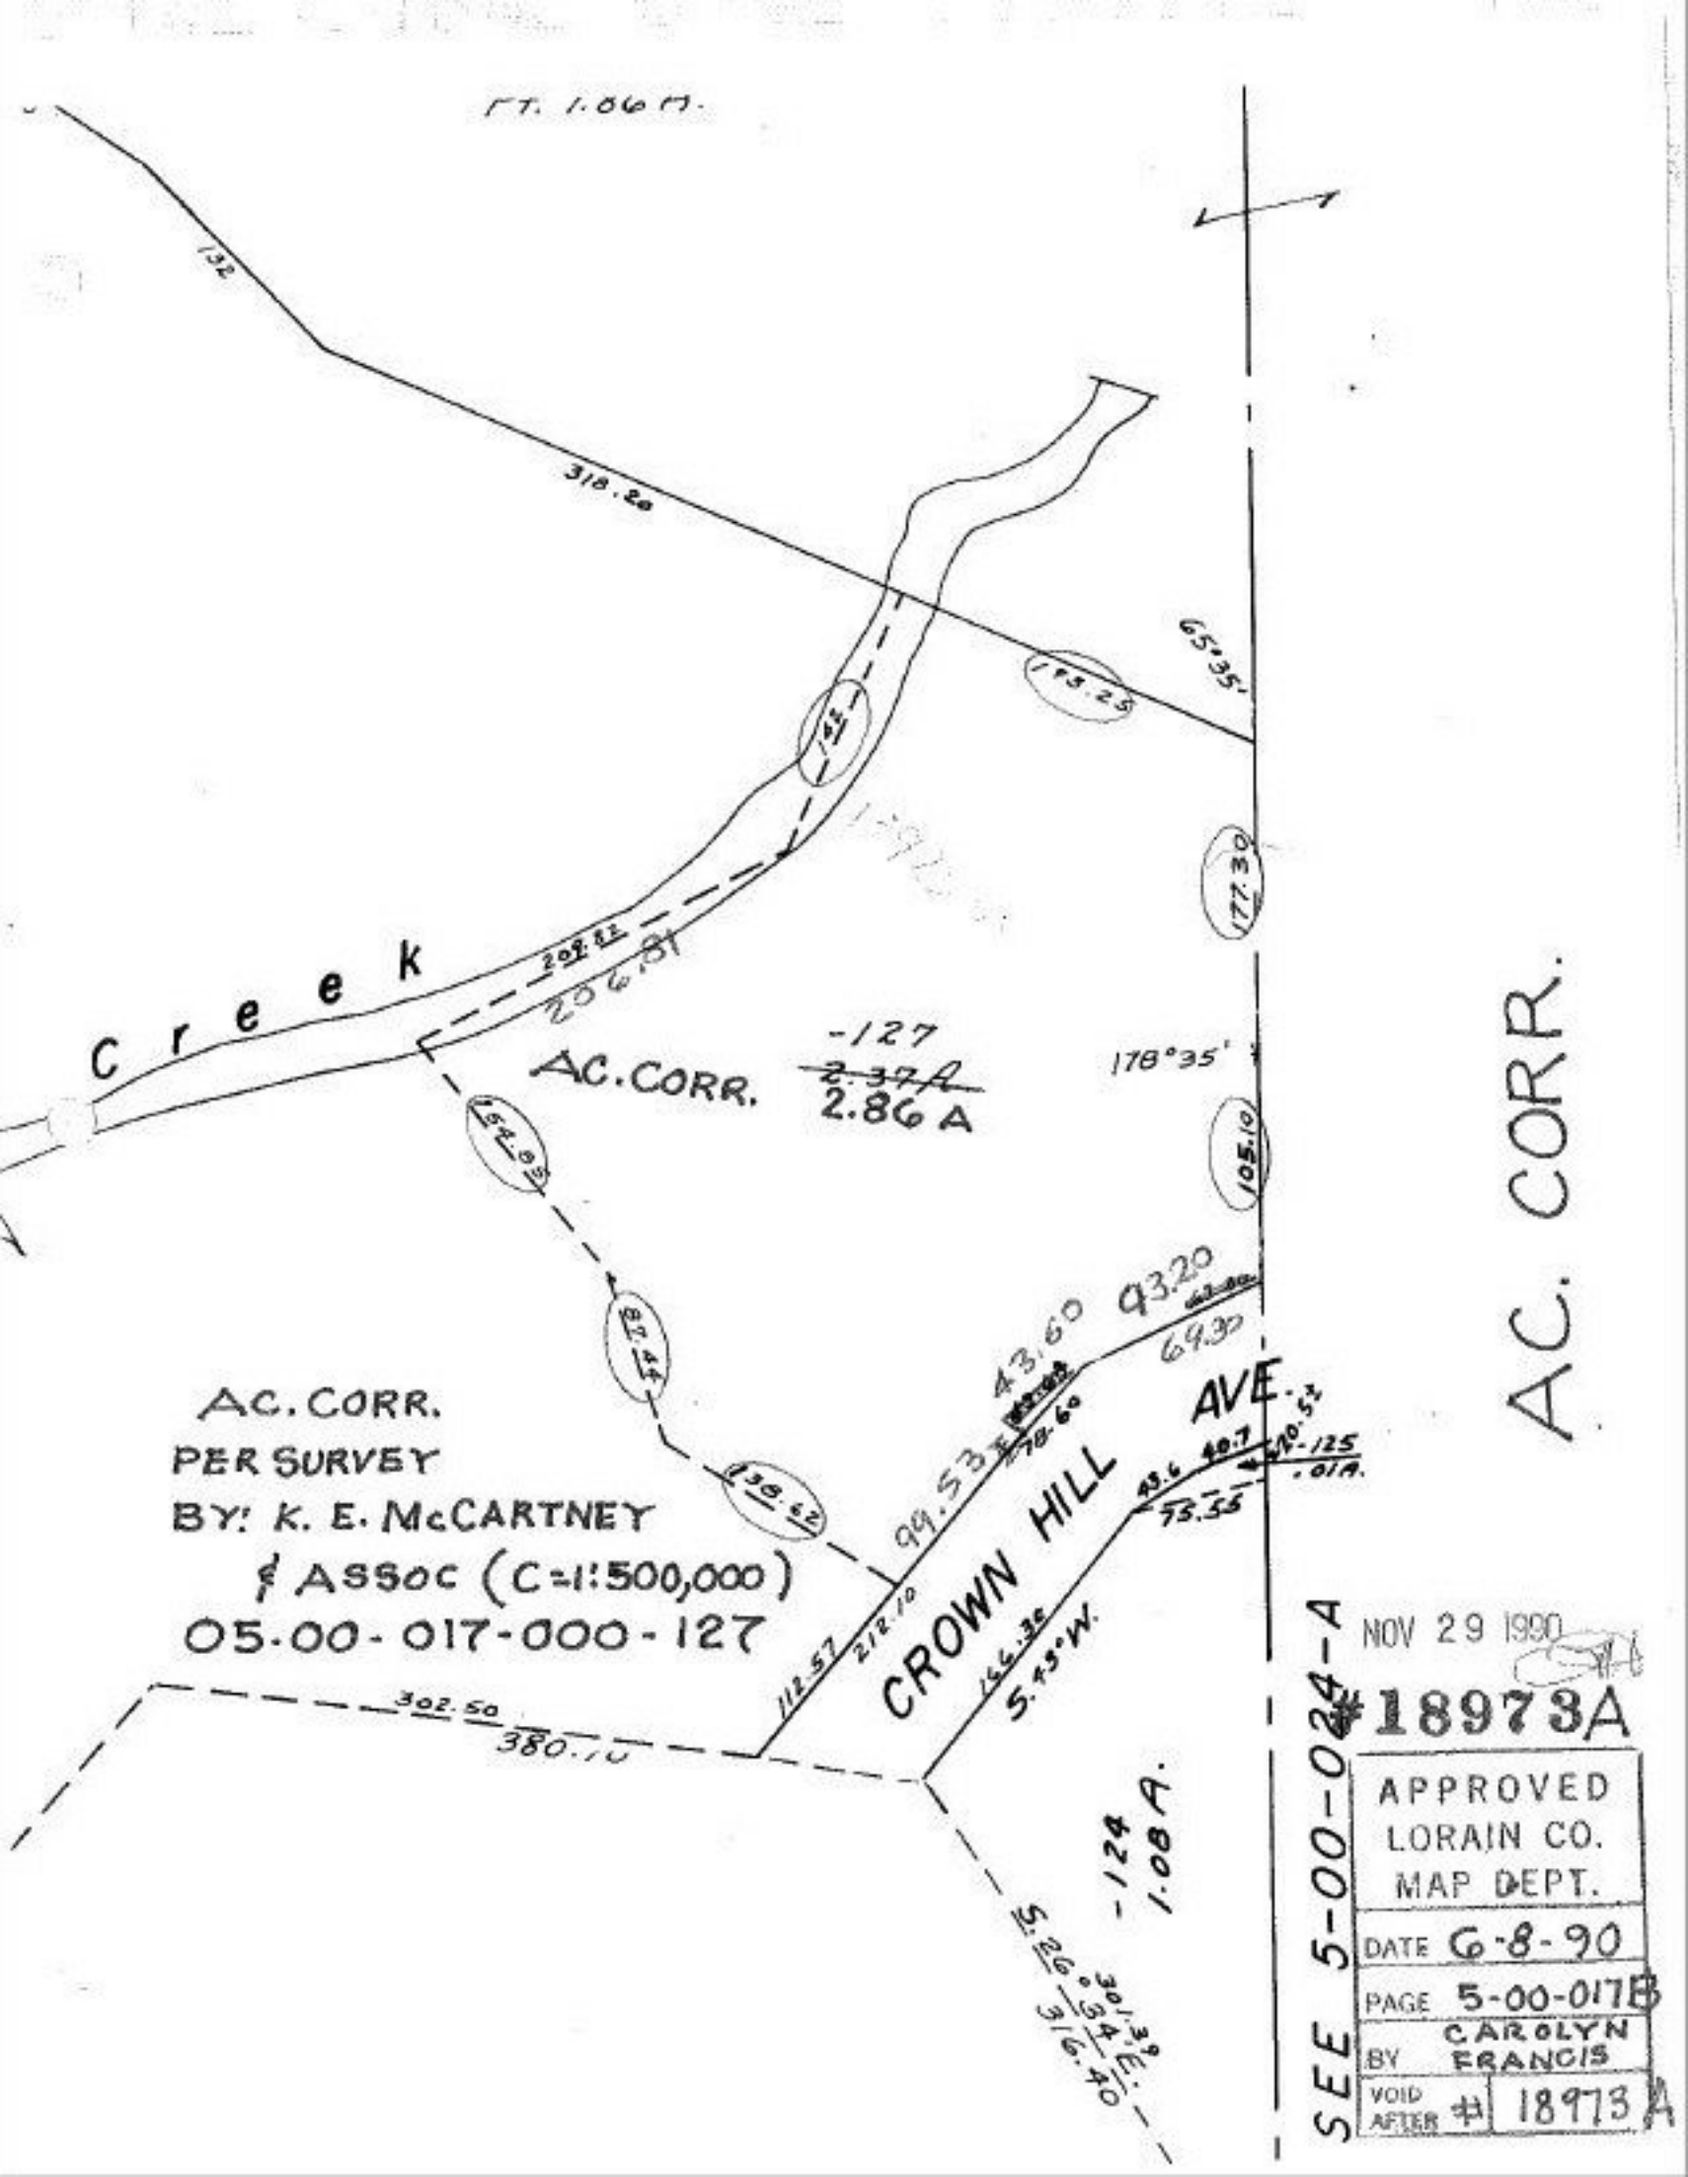
FT. 1.06 M.
132
318.20
65°35'
115.25
145
177.30
Creek
202.82
206.81
-127
AC. CORR.
2.37 A
2.86 A
178°35'
154.95
105.10
87.44
138.42
43.60
93.20
69.30
99.53
78.60
AVE.
CROWN HILL
40.7
40.5'
.125
.01A.
43.6
53.56
112.57
212.10
166.36
S. 45° W.
AC. CORR.
PER SURVEY
BY: K. E. McCARTNEY
& ASSOC (C=1:500,000)
05-00-017-000-127
302.50
380.10
-124
1.08A.
S. 26° 30' 54" E.
316.40
AC. CORR.
SEE 5-00-024-A
NOV 29 1990
#18973A
APPROVED
LORAIN CO.
MAP DEPT.
DATE 6-8-90
PAGE 5-00-017B
BY CAROLYN FRANCIS
VOID AFTER # 18973A