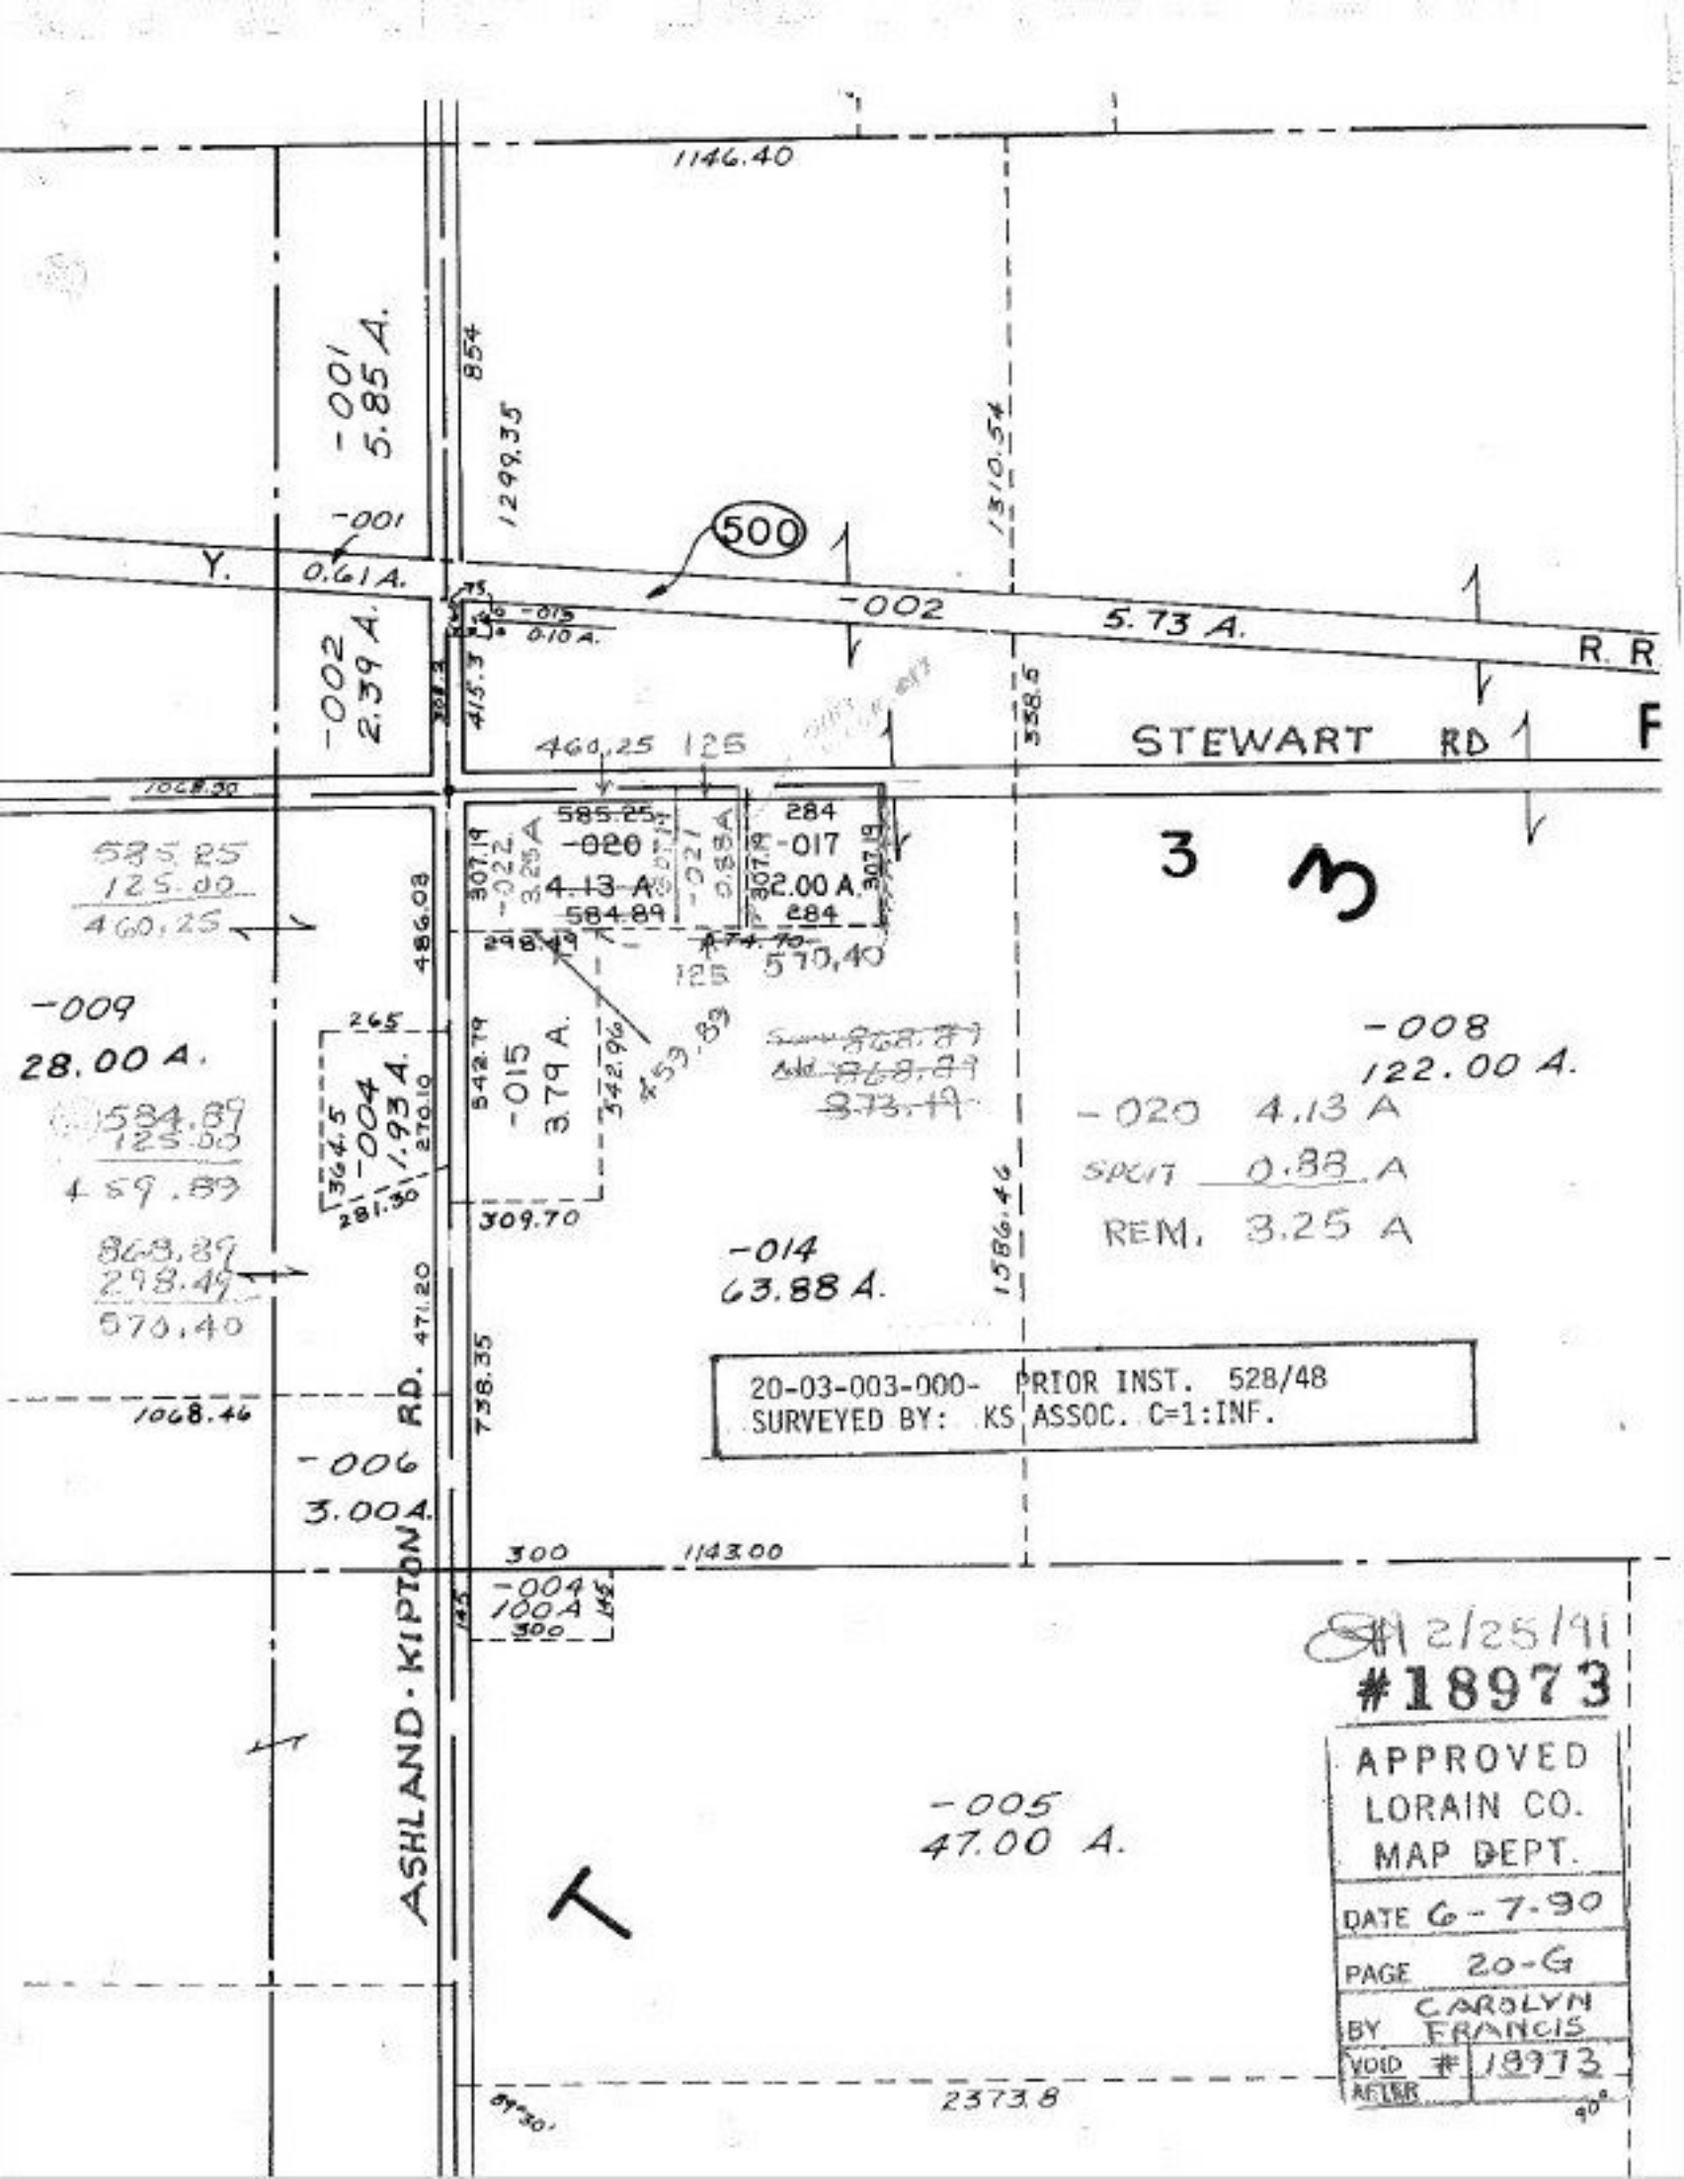
1146.40
-001
5.85 A.
854
1299.35
1310.54
-001
500
Y.
0.61 A.
-002
5.73 A.
R. R
-015
0.10 A.
-002
2.39 A.
415.3
338.5
STEWART RD
F
460.25
125
1068.30
585.25
-020
4.13 A
584.89
284
-017
2.00 A.
284
307.19
-022
3.25 A
-021
0.88 A
307.19
307.19
3
3
585.25
125.00
460.25
486.03
298.49
125
570.40
-009
28.00 A.
265
542.79
-015
3.79 A.
542.96
459.89
868.89
868.89
873.19
-008
122.00 A.
584.89
125.00
459.89
364.5
-004
1.93 A.
270.10
281.30
309.70
-020 4.13 A
SPLIT 0.88 A
REM. 3.25 A
868.89
298.49
570.40
-014
63.88 A.
1586.46
471.20
738.35
20-03-003-000- PRIOR INST. 528/48
SURVEYED BY: KS ASSOC. C=1:INF.
1068.46
-006
3.00 A.
ASHLAND-KIPTON RD.
300
1143.00
-004
100 A
300
145
145
2/25/91
#18973
APPROVED
LORAIN CO.
MAP DEPT.
DATE 6-7-90
PAGE 20-G
BY CAROLYN FRANCIS
VOID # 18973
AFTER
-005
47.00 A.
2373.8