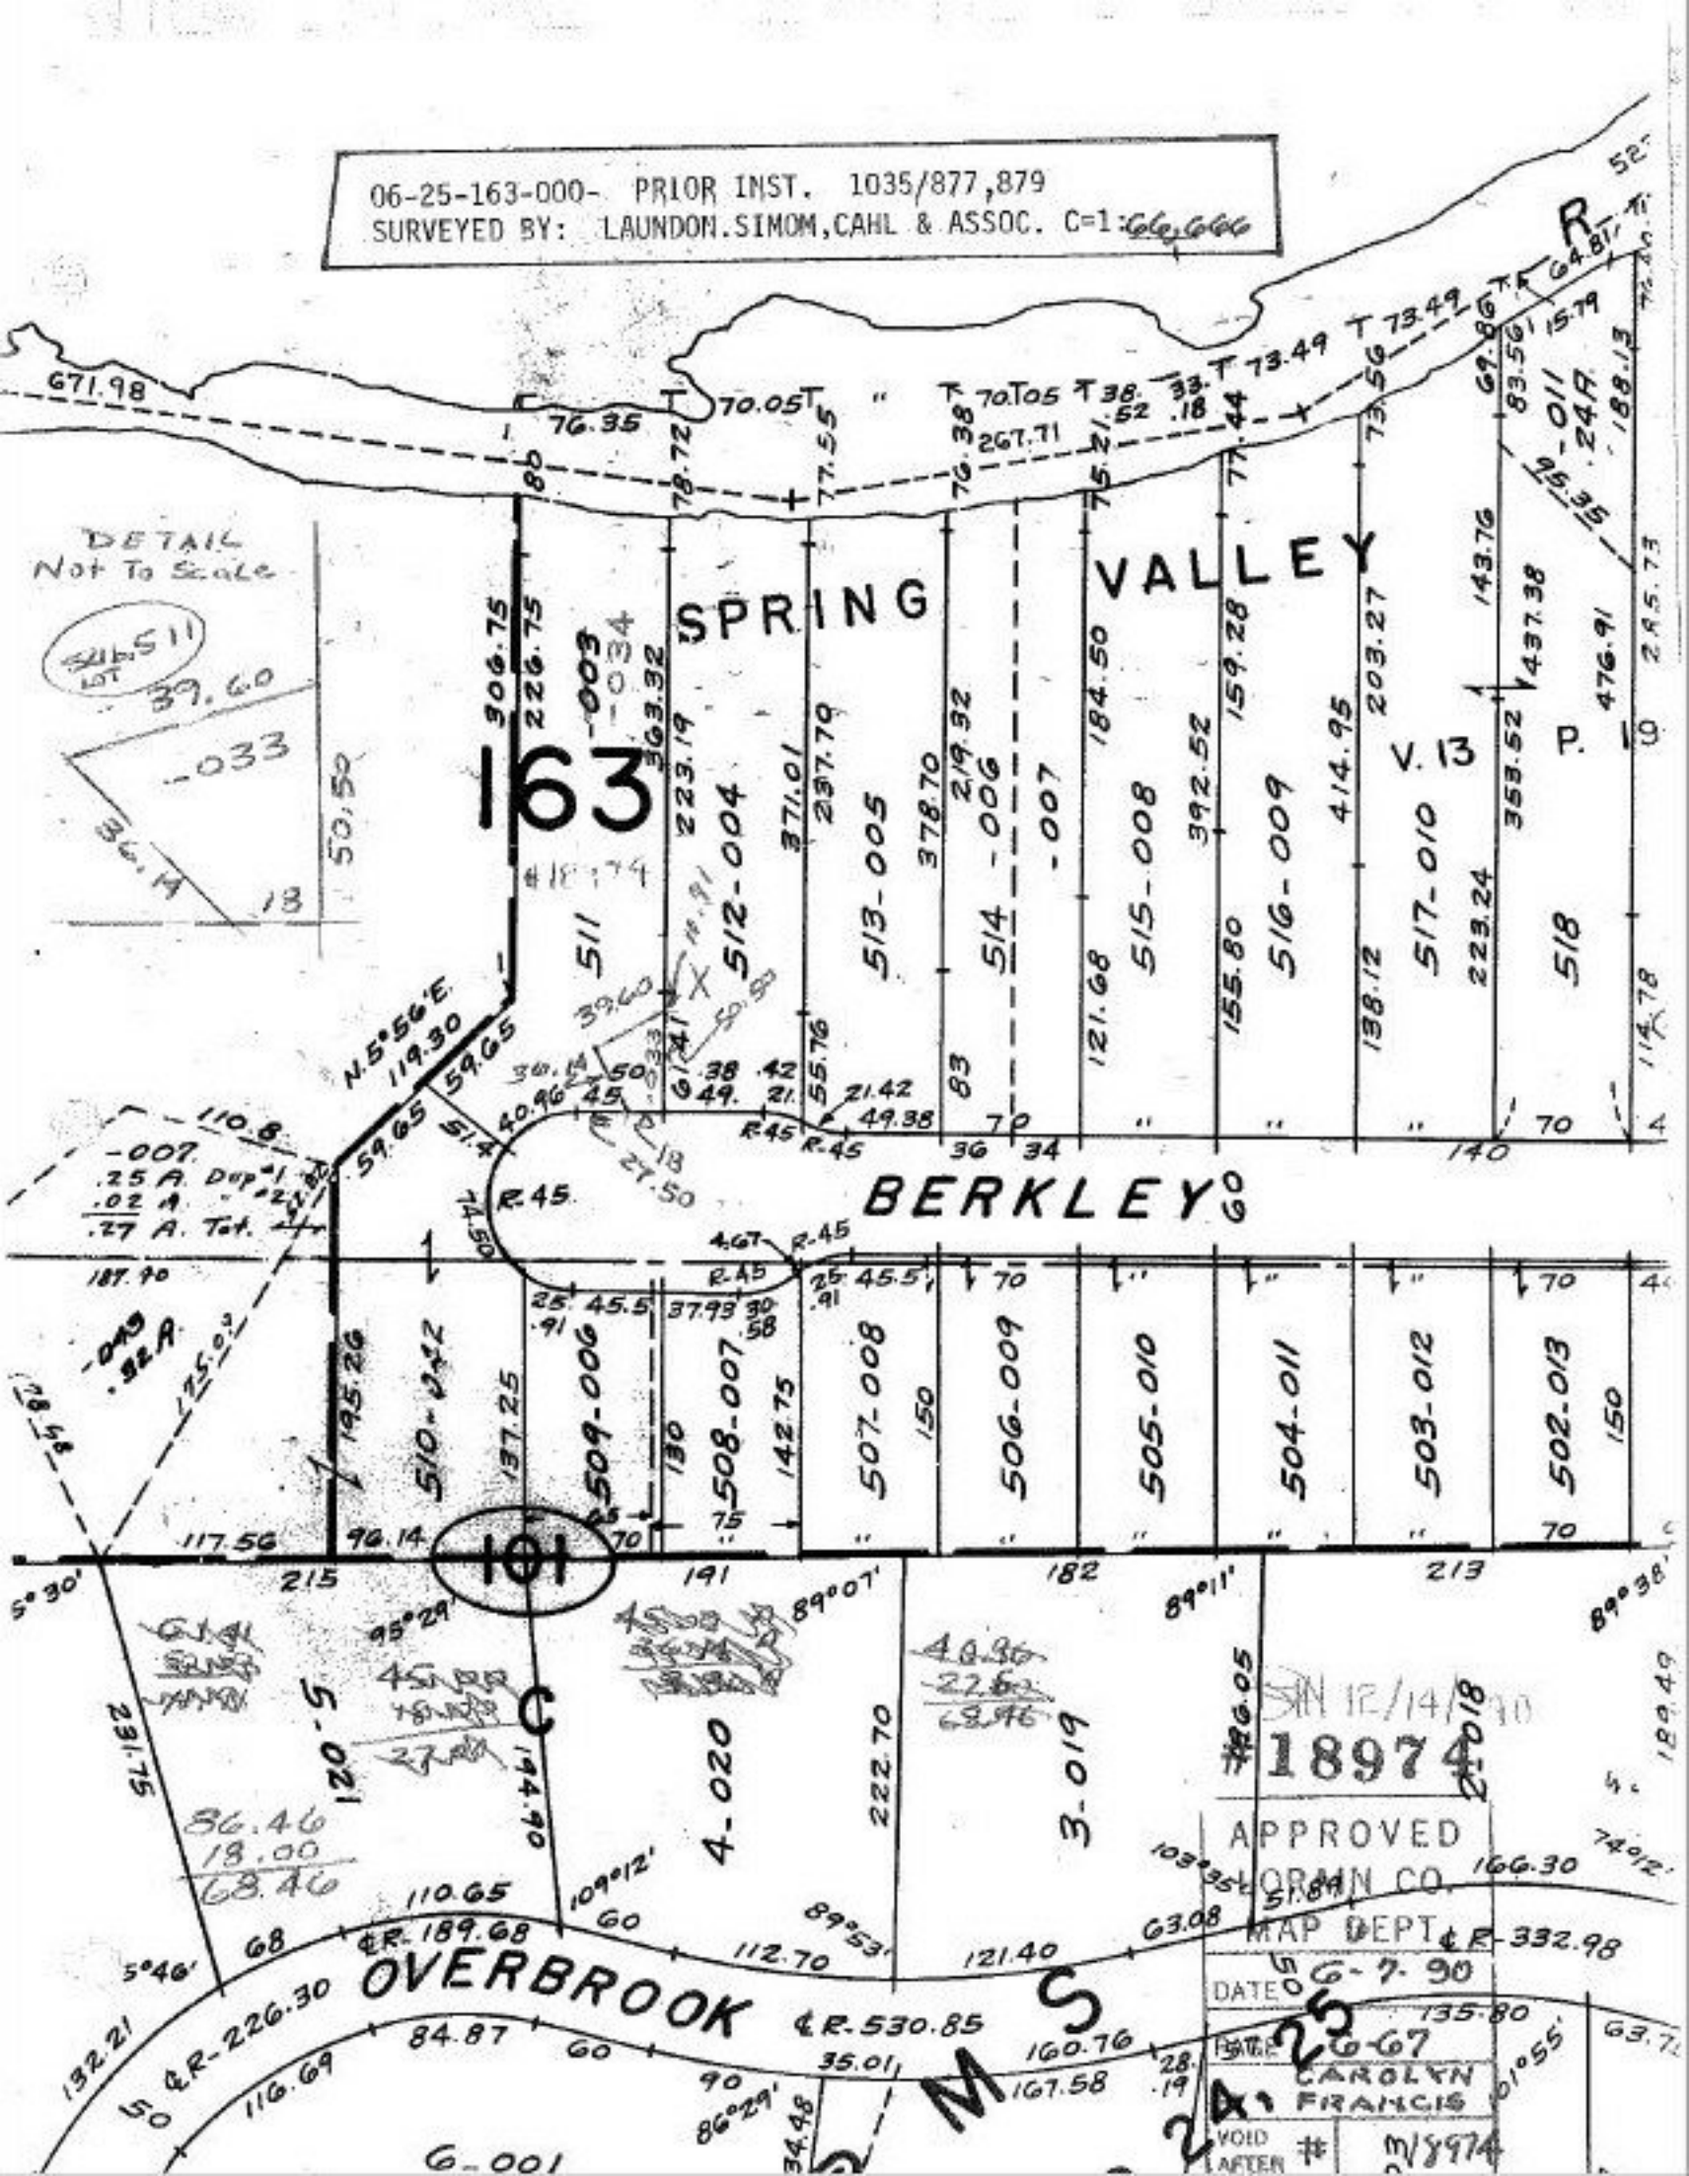
06-25-163-000- PRIOR INST. 1035/877,879
SURVEYED BY: LAUNDON.SIMOM,CAHL & ASSOC. C=1:66,666
DETAIL
Not To Scale
163
SPRING VALLEY
V. 13 P. 9
BERKLEY
OVERBROOK
101
511
512-004
513-005
514-006
-007
515-008
516-009
517-010
518
509-006
508-007
507-008
506-009
505-010
504-011
503-012
502-013
510-012
4.020
3.019
120-S
-007
.25 A. Dup
.02 A.
.27 A. Tot.
-040
.92 A.
APPROVED
ORMAN CO.
MAP DEPT
DATE 6-7-90
CAROLYN FRANCIS
VOID AFTER
18974