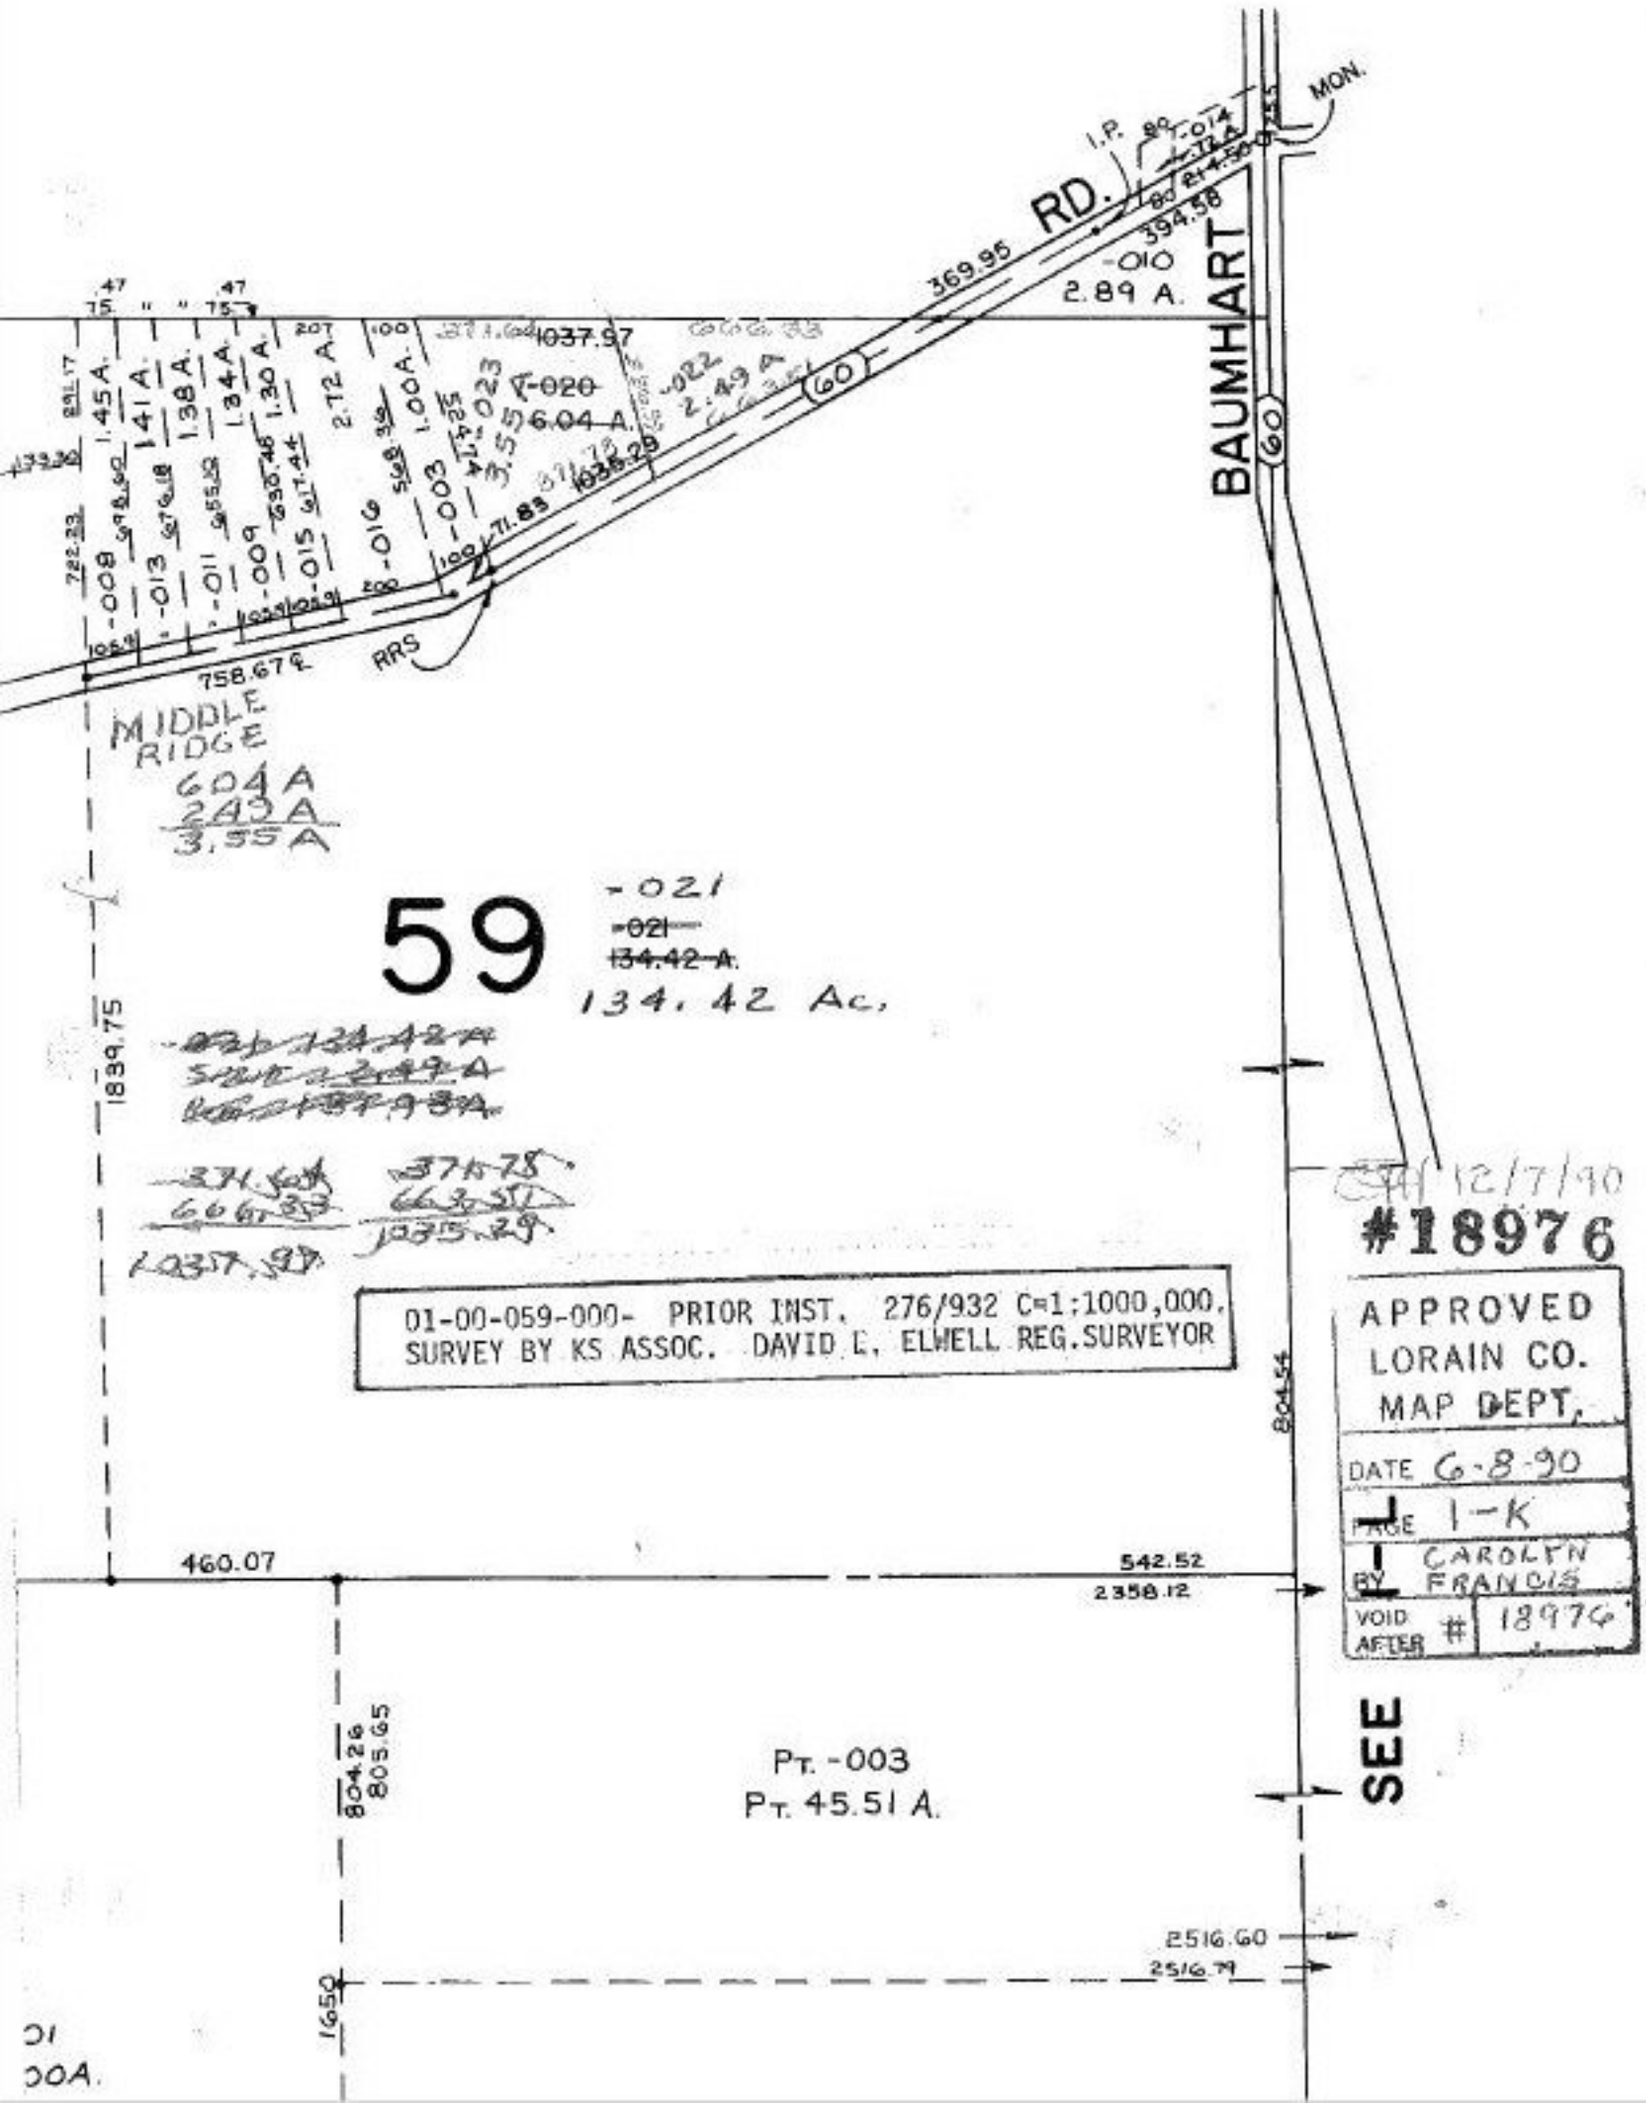
RD.
BAUMHART
MON.
I.P.
394.58
-010
2.89 A.
369.95
1037.97
-020
6.04 A.
-022
2.49 A.
-023
3.55 A.
-003
1.00 A.
-016
-015
-009
-011
-013
-009
1.45 A.
1.41 A.
1.38 A.
1.34 A.
1.30 A.
2.72 A.
758.67
RRS
MIDDLE RIDGE
604 A
2.49 A
3.55 A
59
-021
-021
134.42 A.
134.42 Ac.
1839.75
01-00-059-000- PRIOR INST. 276/932 C=1;1000,000.
SURVEY BY KS ASSOC. DAVID E. ELWELL REG.SURVEYOR
12/7/90
#18976
APPROVED
LORAIN CO.
MAP DEPT.
DATE 6-8-90
PAGE 1-K
BY CAROLYN FRANCIS
VOID AFTER # 18976
804.54
460.07
542.52
2358.12
SEE
PT. -003
PT. 45.51 A.
804.26
805.65
2516.60
2516.79
1650
01
00A.