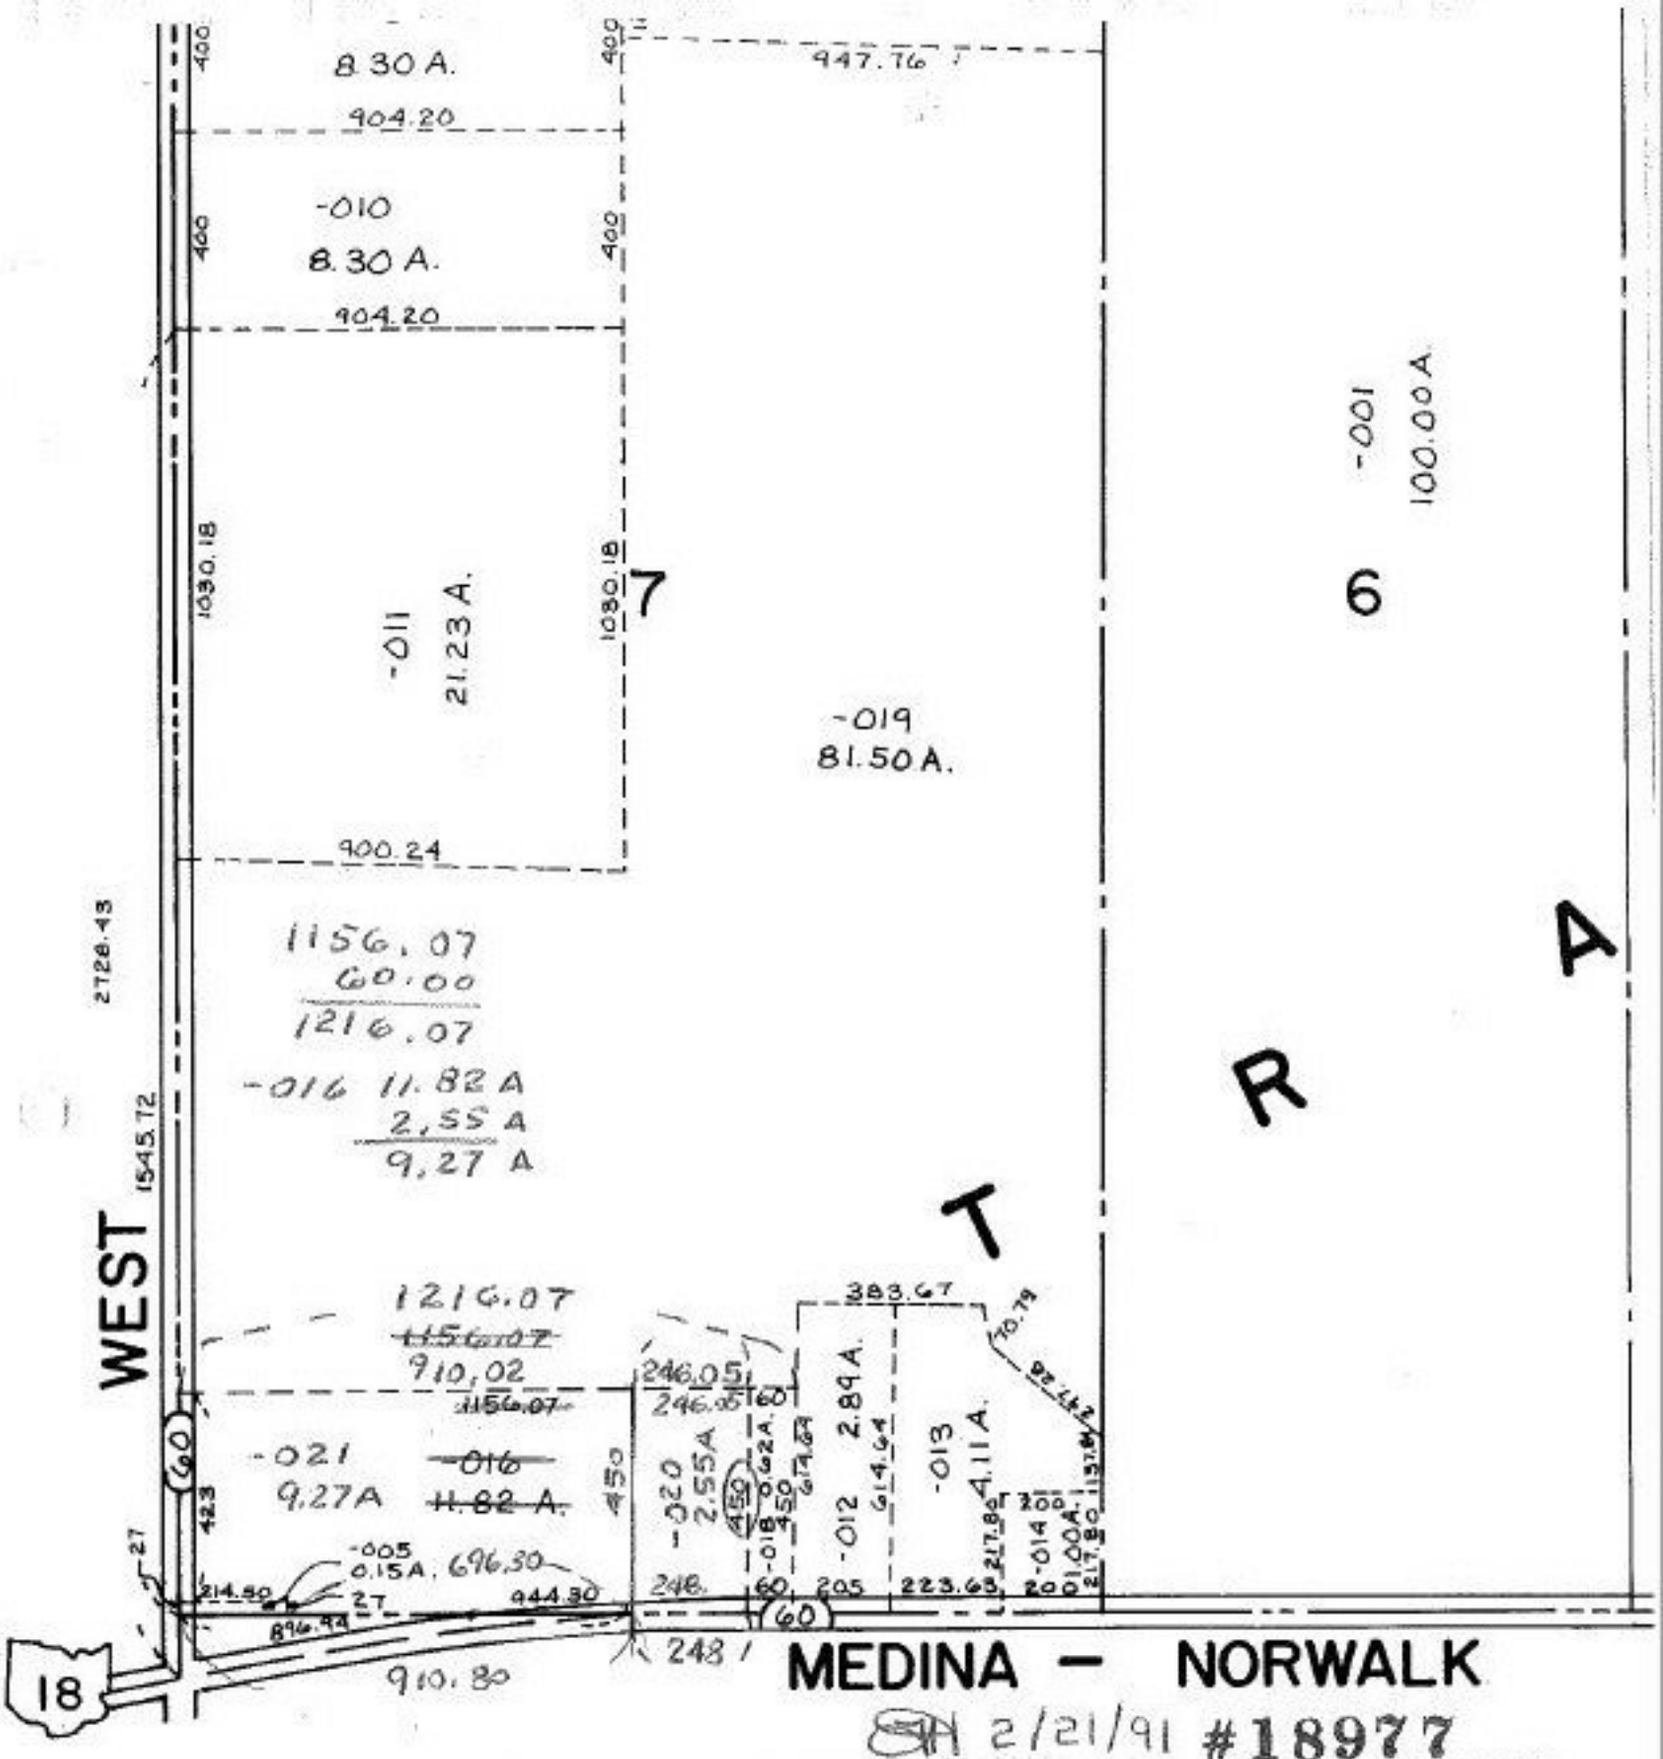

2/21/91 #18977

19-04-007-000- PRIOR INST. o.r.270/883
SURVEYED BY: WILLIAM B. BARTON REG. SURV.
C=1: 100,000.

APPROVED LORAIN CO. MAP DEPT.	
DATE	6-8-90
PAGE	19-A
BY	CAROLYN FRANCIS
VOID AFTER #	18977