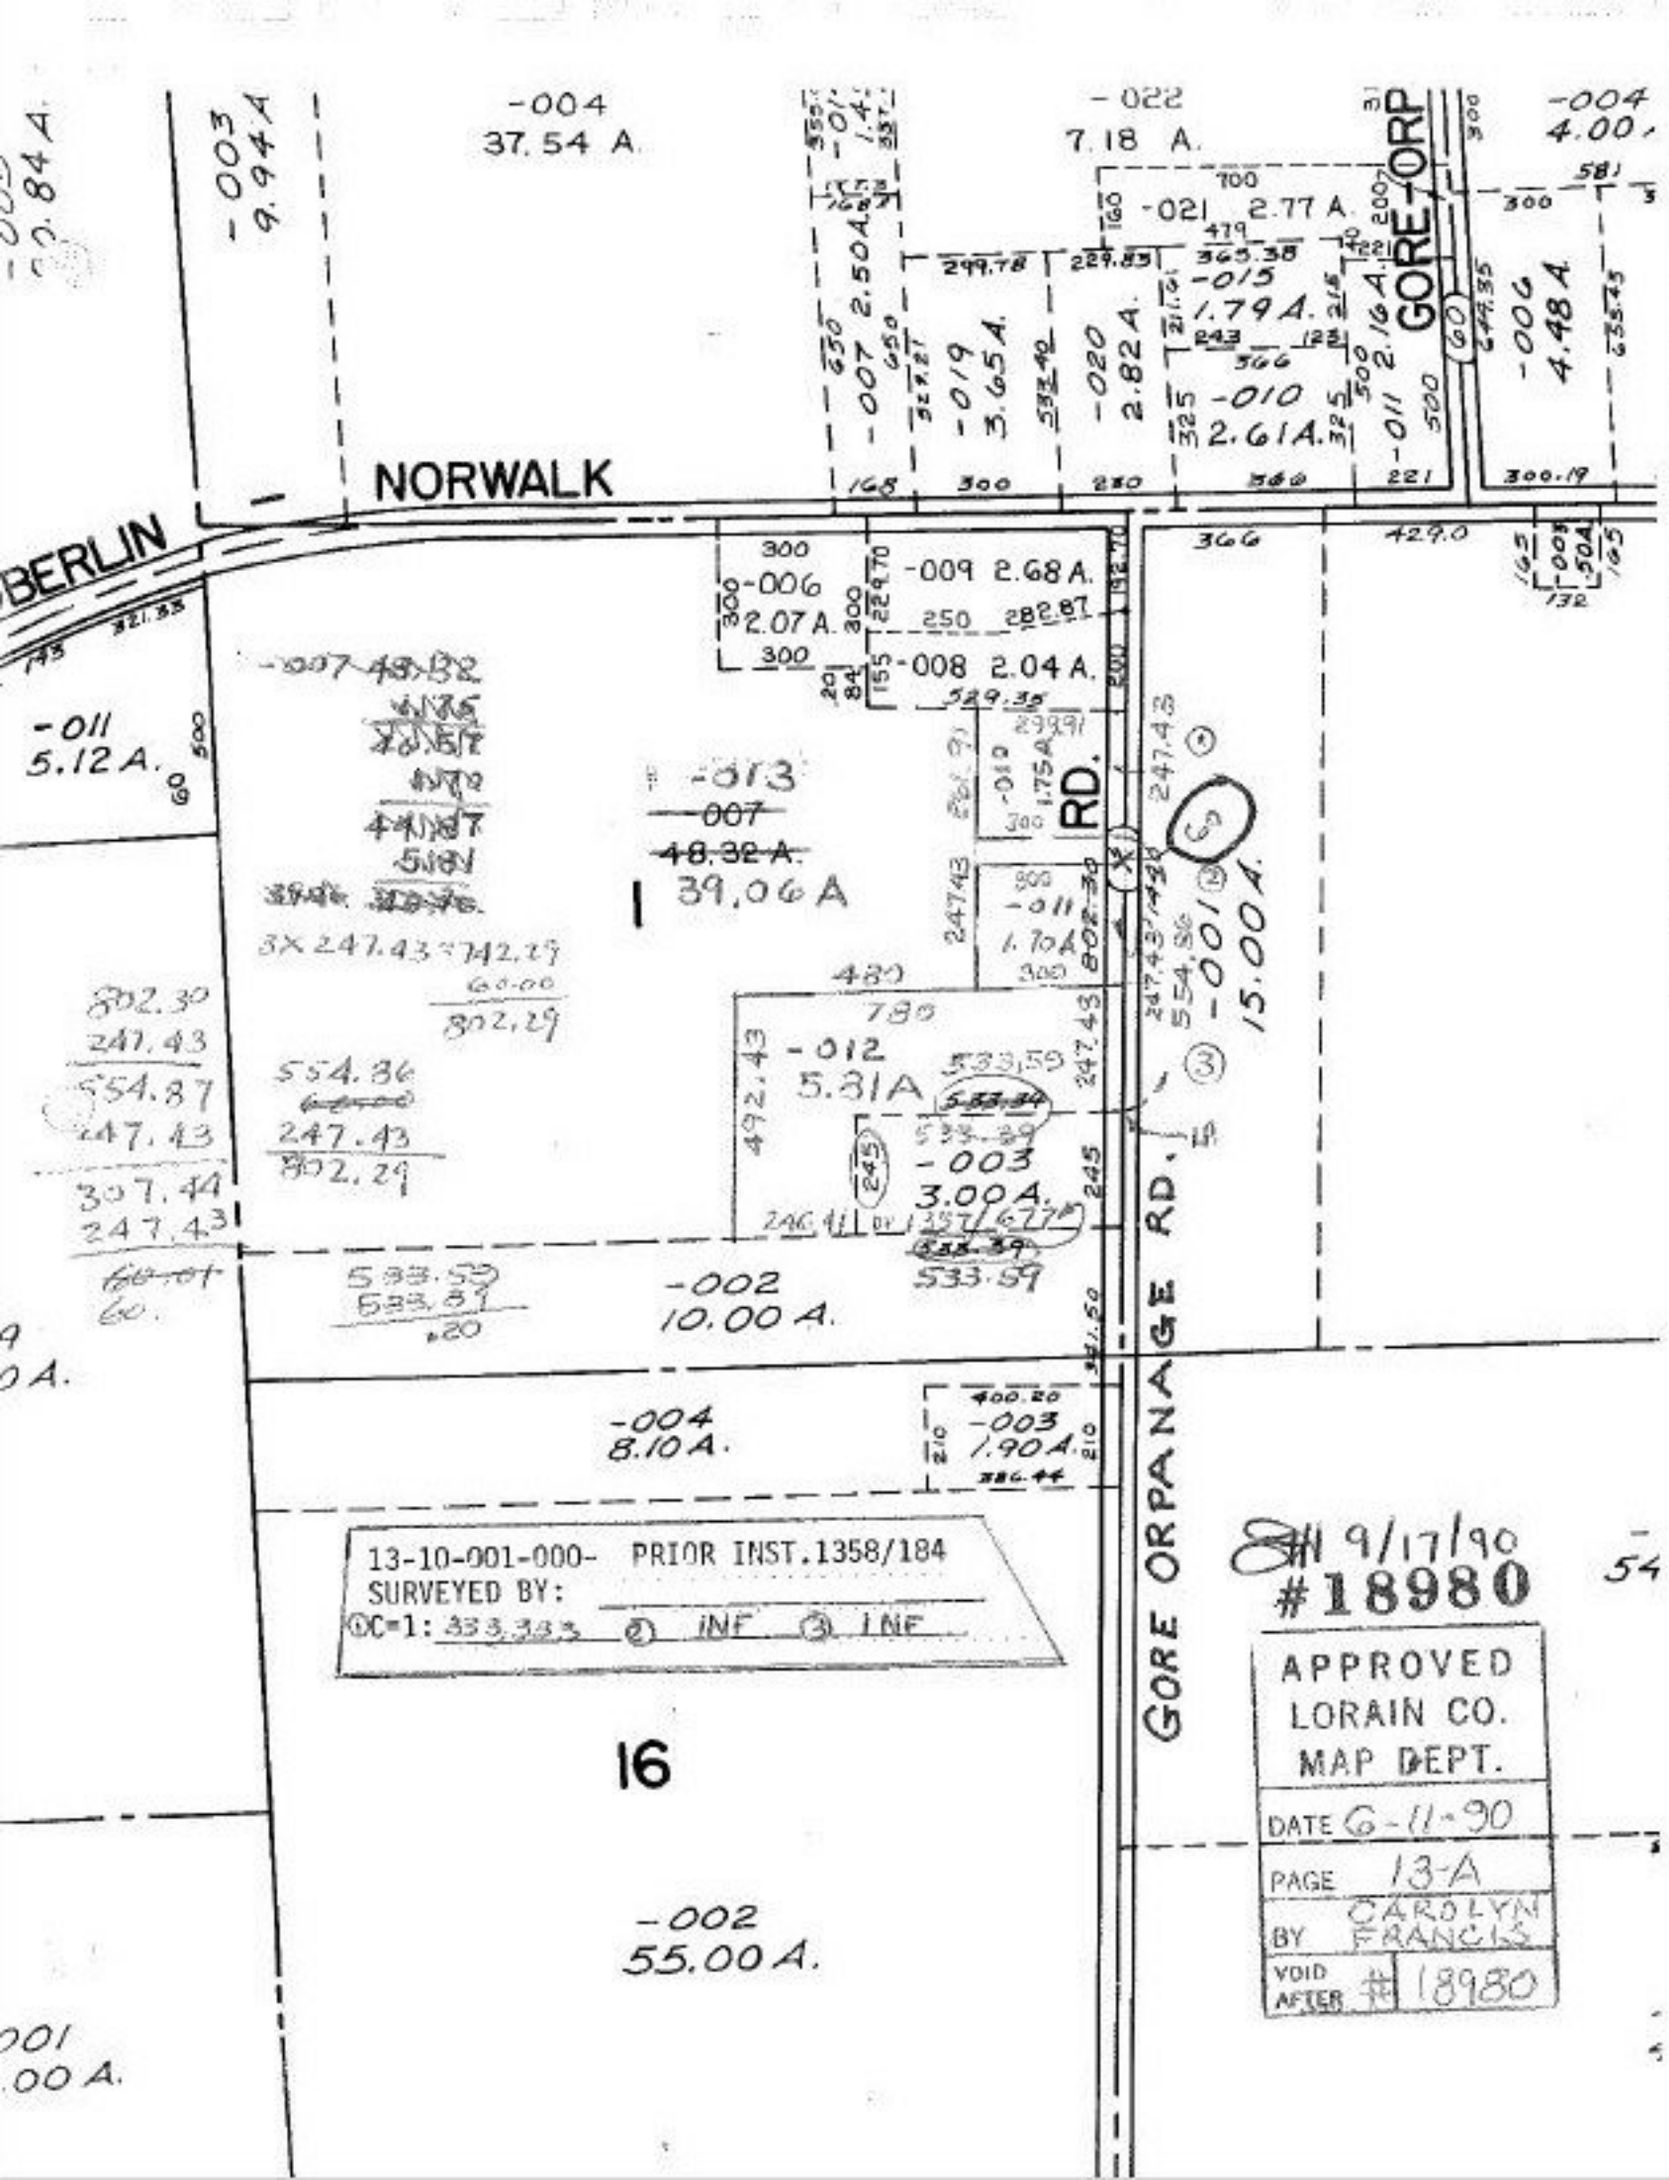
-004
37.54 A.
-003
9.944 A.
-022
7.18 A.
-021 2.77 A.
-004
4.00 A.
-007 2.50A.
-019 3.65A.
-020 2.82 A.
-015 1.79 A.
-010 2.61A.
-011 2.16A.
-006 4.48A.
GORE ORP
NORWALK
BERLIN
-006 2.07 A.
-009 2.68 A.
-008 2.04 A.
-011 5.12 A.
-007 48.32
-013
-007
48.32 A.
39.06 A
-010 1.75A.
-011 1.70A
-001 15.00A.
-012 5.31A
-003 3.00 A.
-002 10.00 A.
-004 8.10A.
-003 1.90A.
-002 55.00 A.
GORE ORPHANAGE RD.
RD.
802.30
247.43
554.87
247.43
307.44
247.43
554.36
247.43
802.29
533.59
533.59
533.59
16
13-10-001-000- PRIOR INST.1358/184
SURVEYED BY:
①C=1: 333.333 ② INF ③ INF
9/17/90
#18980
APPROVED
LORAIN CO.
MAP DEPT.
DATE 6-11-90
PAGE 13-A
BY CAROLYN FRANCIS
VOID AFTER # 18980