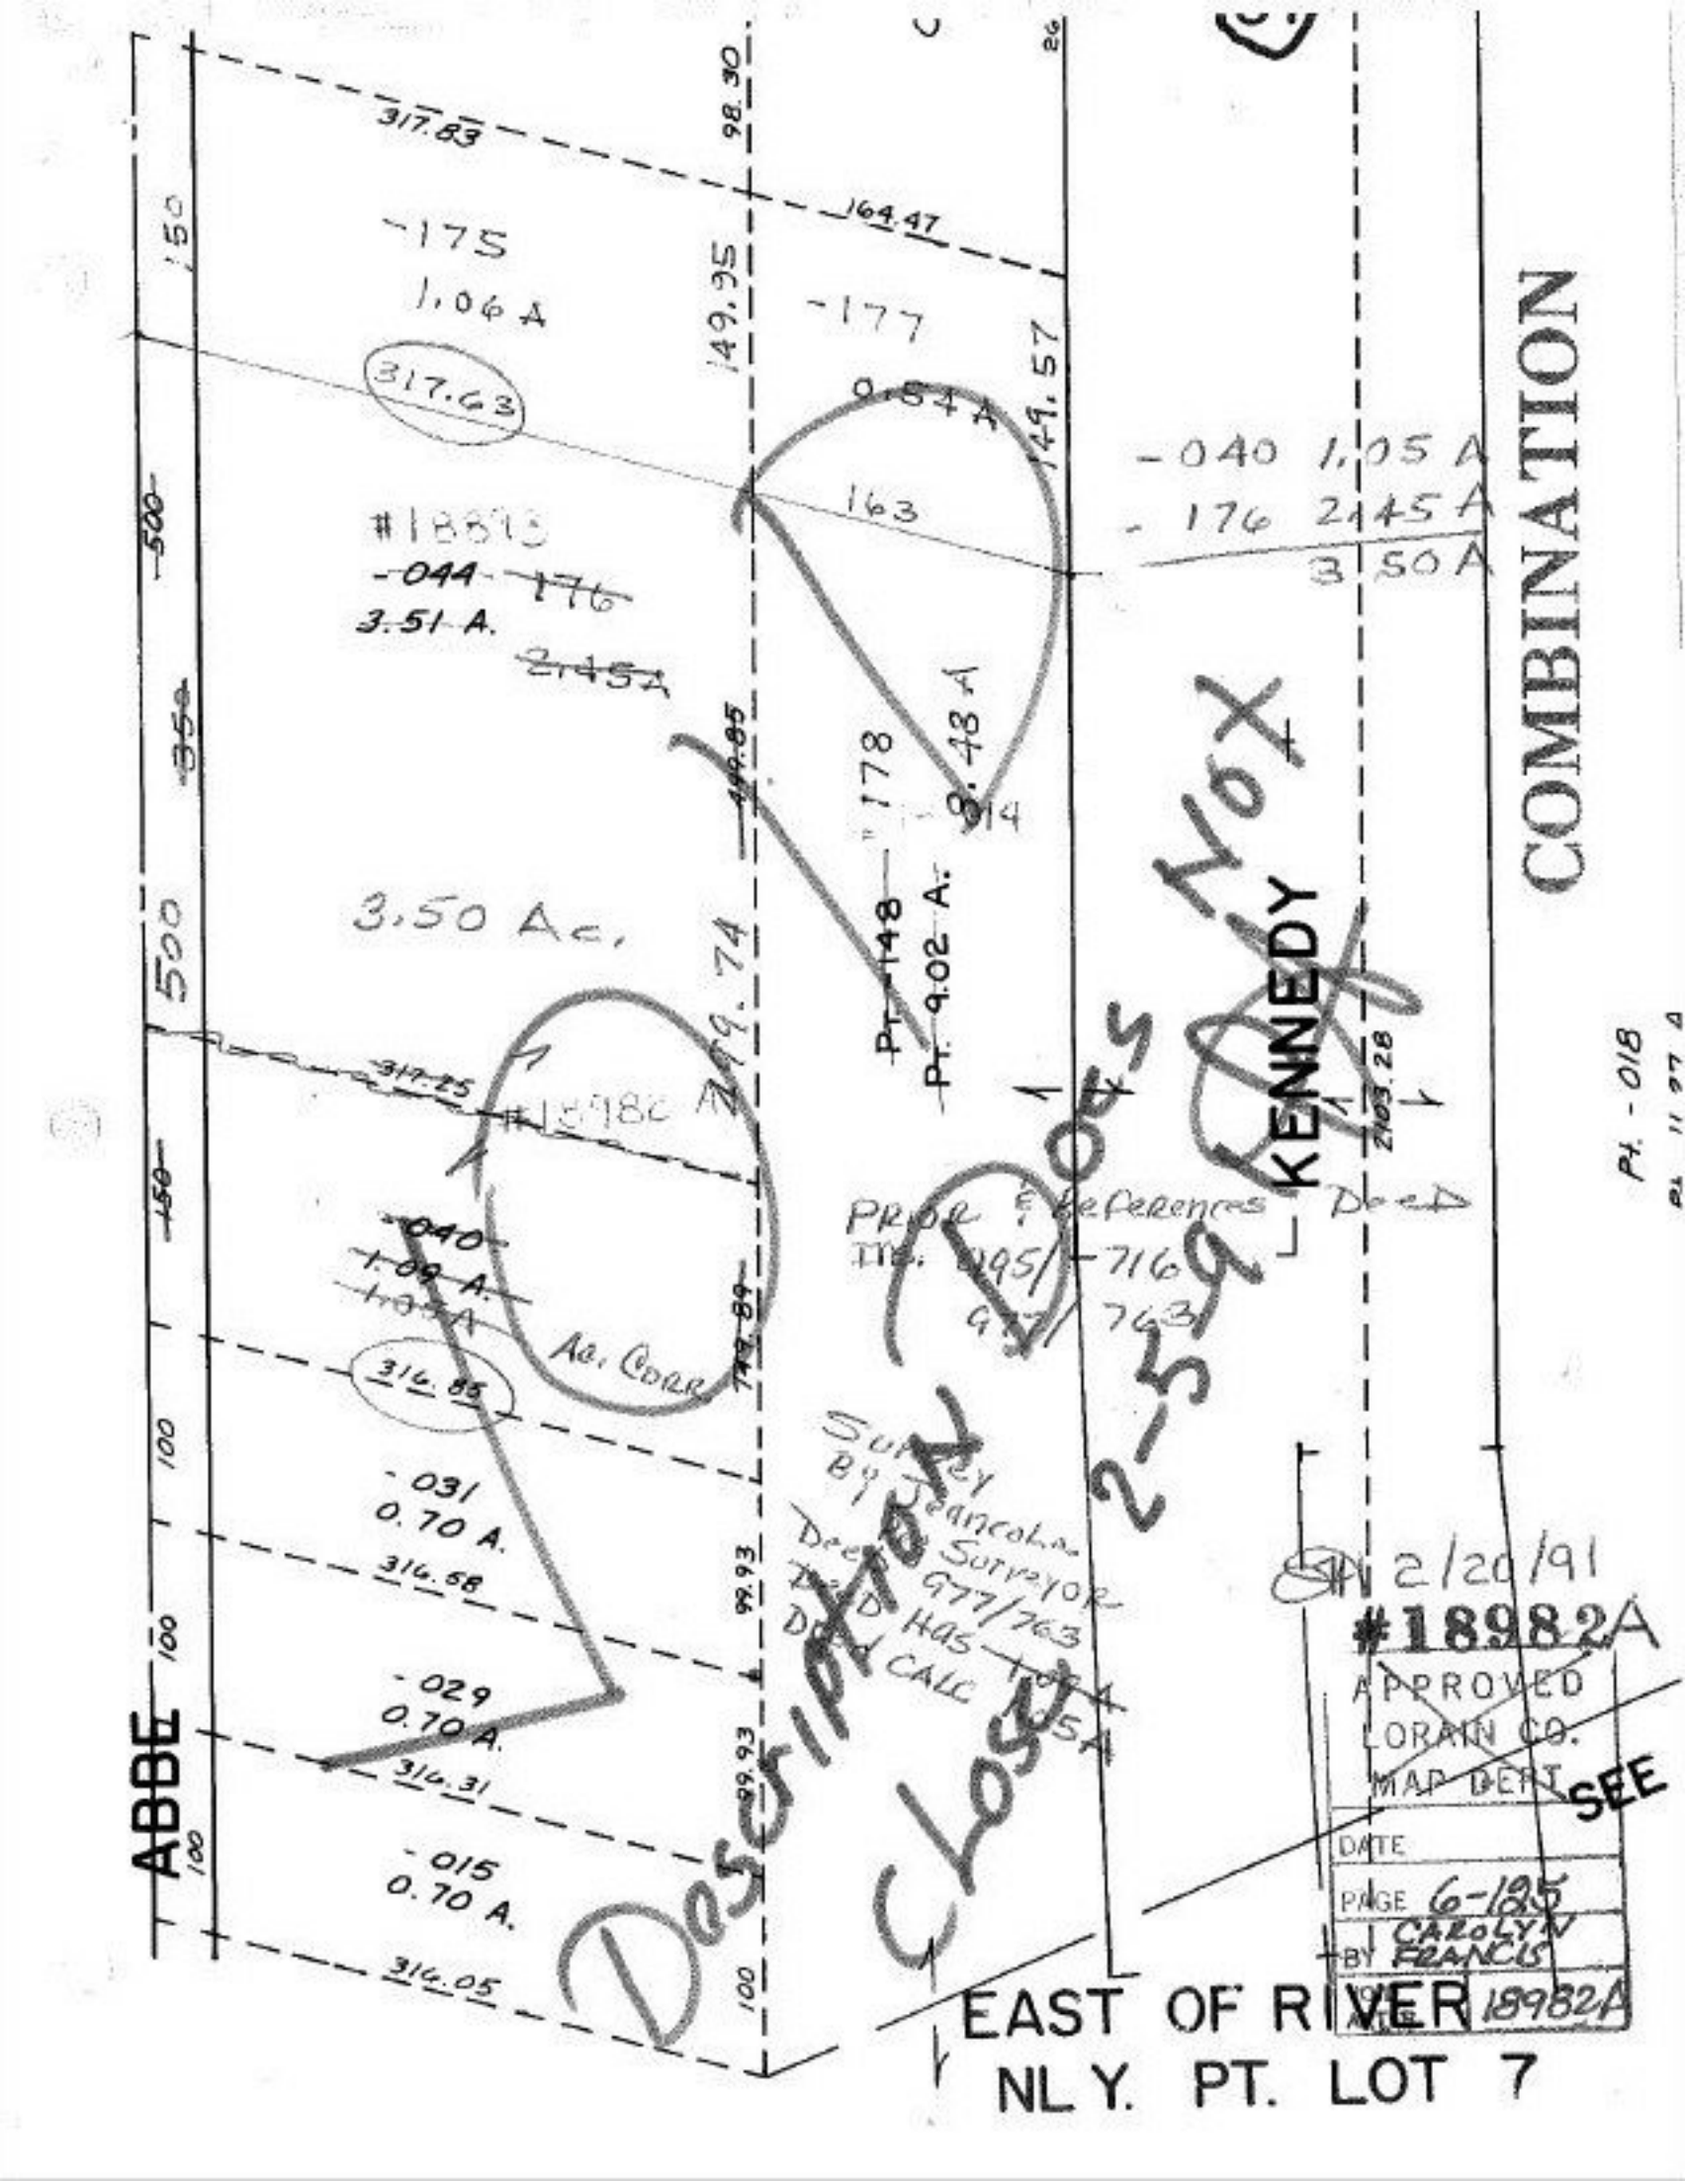
COMBINATION
KENNEDY
ABBE
EAST OF RIVER
NLY. PT. LOT 7
Description Does Not Close
2-39
-175
1.06 A
317.63
-177
0.64 A
149.35
149.57
164.47
317.83
-040 1.05 A
-176 2.45 A
3.50 A
#18982
-044 -176
3.51 A.
2145 A
Pt. 178
Pt. 9.02 A.
3.48 A
3.50 Ac.
319.74
317.25
#18982
-040
1.09 A.
1.10 A
Ac. Corr
316.85
-031
0.70 A.
316.68
-029
0.70 A.
316.31
-015
0.70 A.
316.05
PROP. REFERENCES
DEED
2/20/91
#18982A
APPROVED
LORAIN CO.
MAP DEPT.
SEE
DATE
PAGE 6-125
BY CAROLYN FRANCIS
18982A