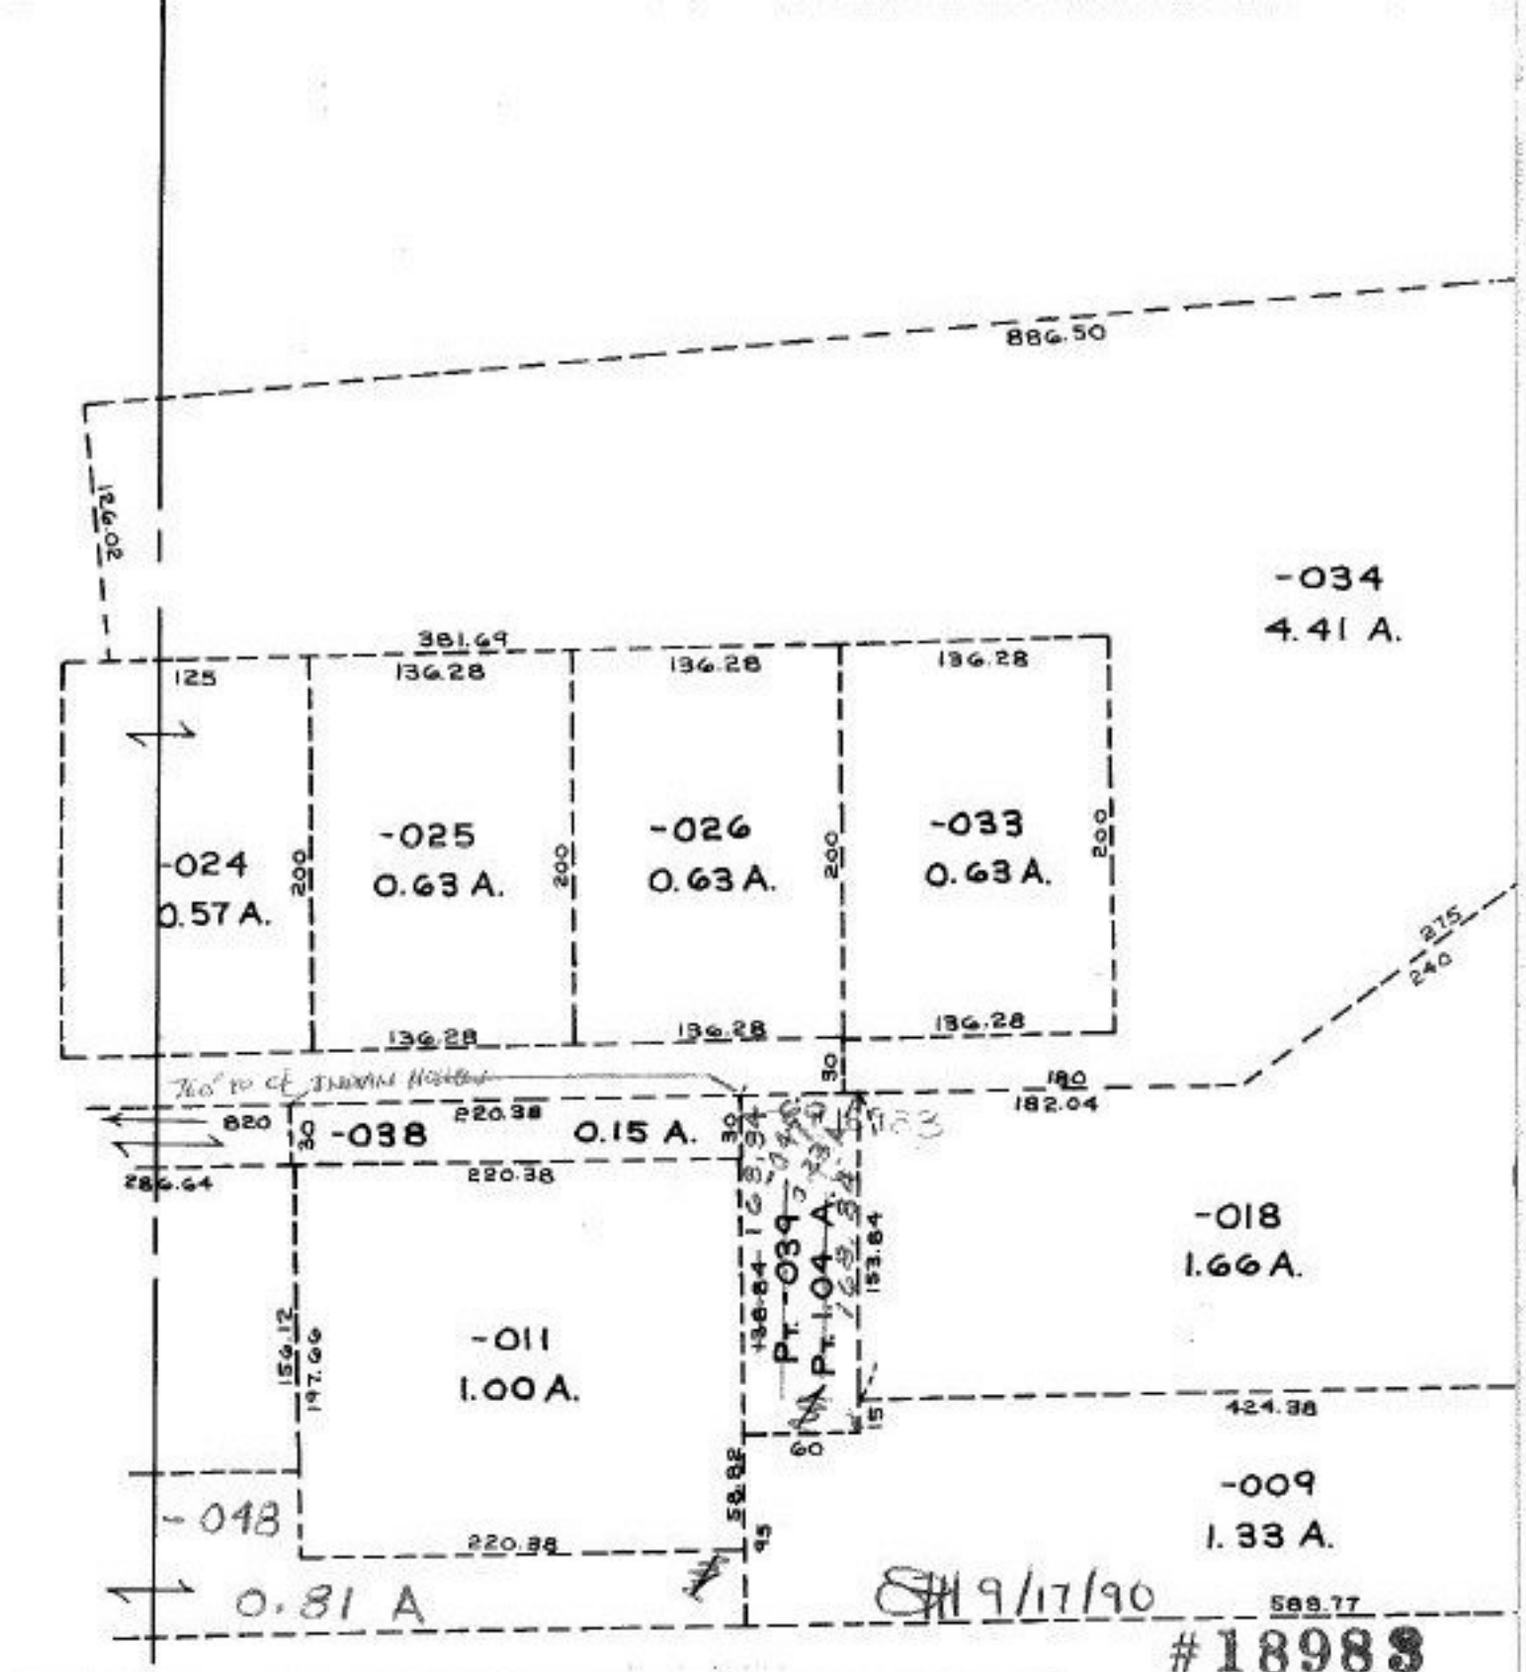

10-00-015-101- PRIOR INST. 222/492 C=1:INF. INFORMATION TAKEN FROM SURVEY DONE BY: GARY PENFOUND. & ADDITIONAL INFORMATION GIVEN BY: LAUNDON,SIMON,CAHL & ASSOC.

#18983

APPROVED
LORAIN CO.
MAP DEPT.
DATE 6-13-90
PAGE 10-00-015 A
BY CAROLYN FRANCIS
VOID AFTER # 18983

10-00-015 A