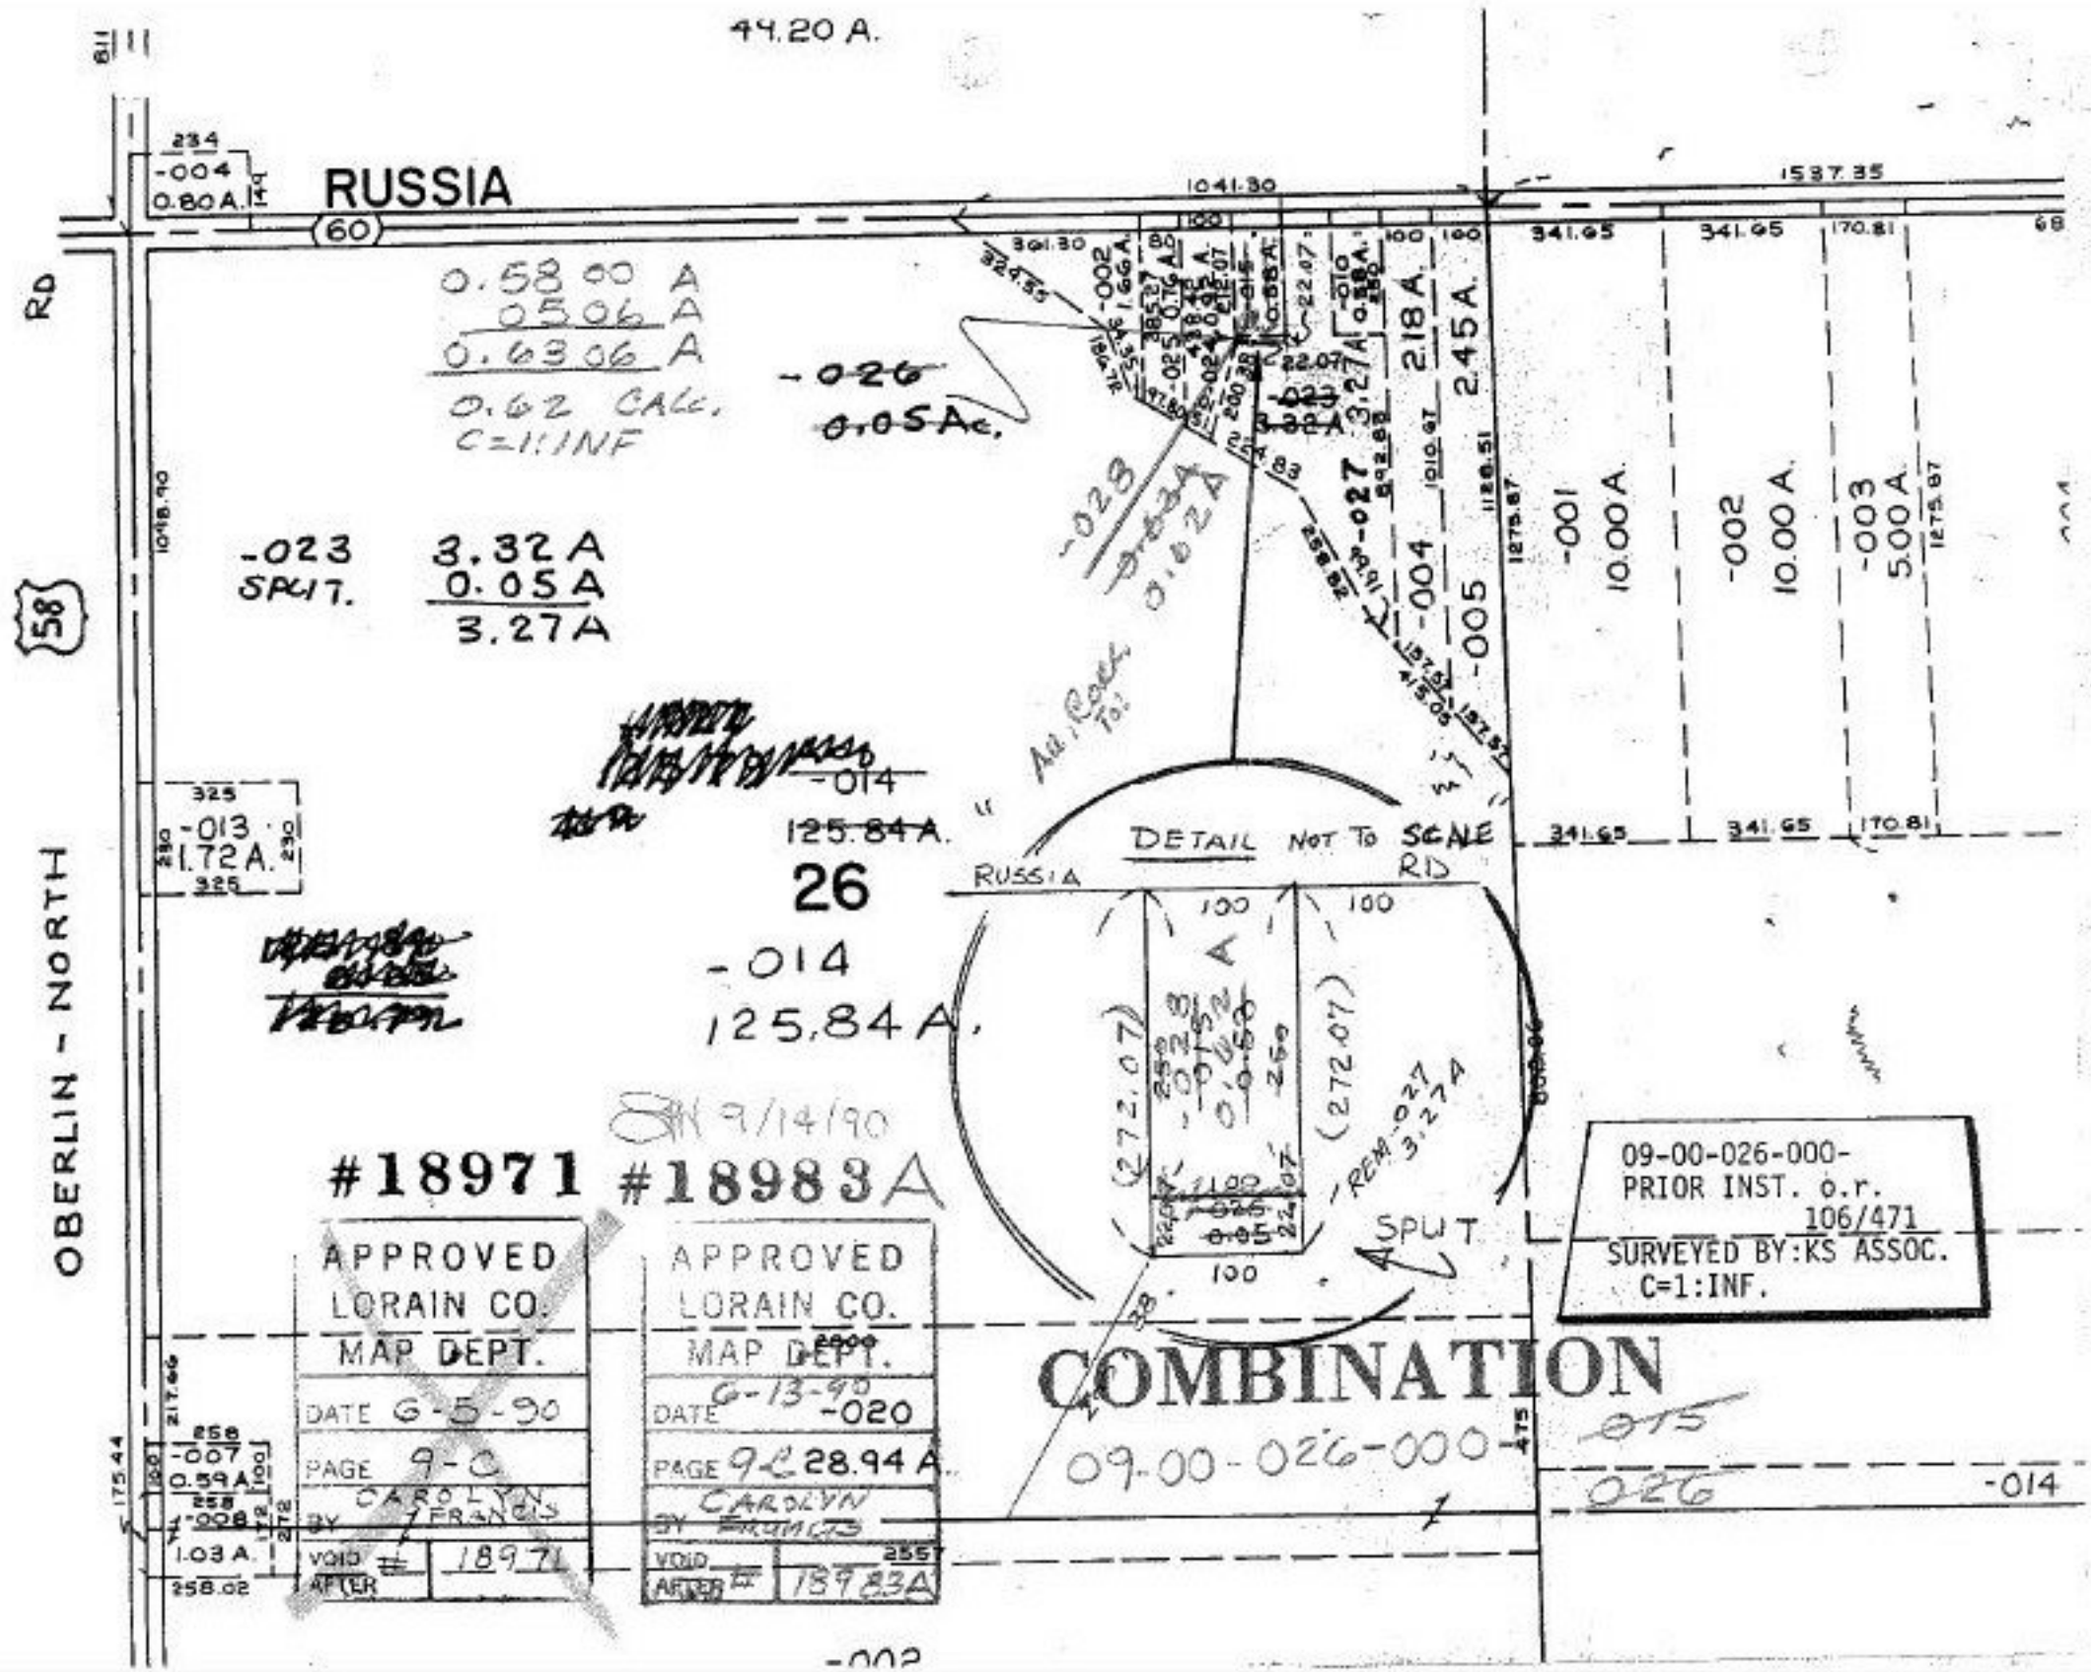

44.20 A.
RUSSIA
60
RD
58
OBERLIN - NORTH
-004
0.80 A.
0.58 00 A
0.5 06 A
0.63 06 A
0.62 CALC.
C=1:INF
-026
0.05 Ac.
-023
SPLIT.
3.32 A
0.05 A
3.27 A
-028
0.63 A
0.62 A
-014
125.84 A.
26
-014
125.84 A.
-013
1.72 A.
-002
1.66 A.
-023
3.32 A
-027
3.27 A
2.18 A.
2.45 A.
-004
-005
-001
10.00 A.
-002
10.00 A.
-003
5.00 A.
DETAIL NOT TO SCALE
RUSSIA
RD
100
(272.07)
REM -027
3.27 A
SPLIT
09-00-026-000-
PRIOR INST. o.r.
106/471
SURVEYED BY:KS ASSOC.
C=1:INF.
#18971
#18983A
APPROVED
LORAIN CO.
MAP DEPT.
DATE 6-5-90
PAGE 9-C
BY CAROLYN FRANCIS
VOID AFTER # 18971
APPROVED
LORAIN CO.
MAP DEPT.
DATE 6-13-90
-020
PAGE 9-C 28.94 A.
BY CAROLYN FRANCIS
VOID AFTER # 18983A
COMBINATION
09-00-026-000-
-015
-026
-014
-007
0.59 A
-008
1.03 A.
-002