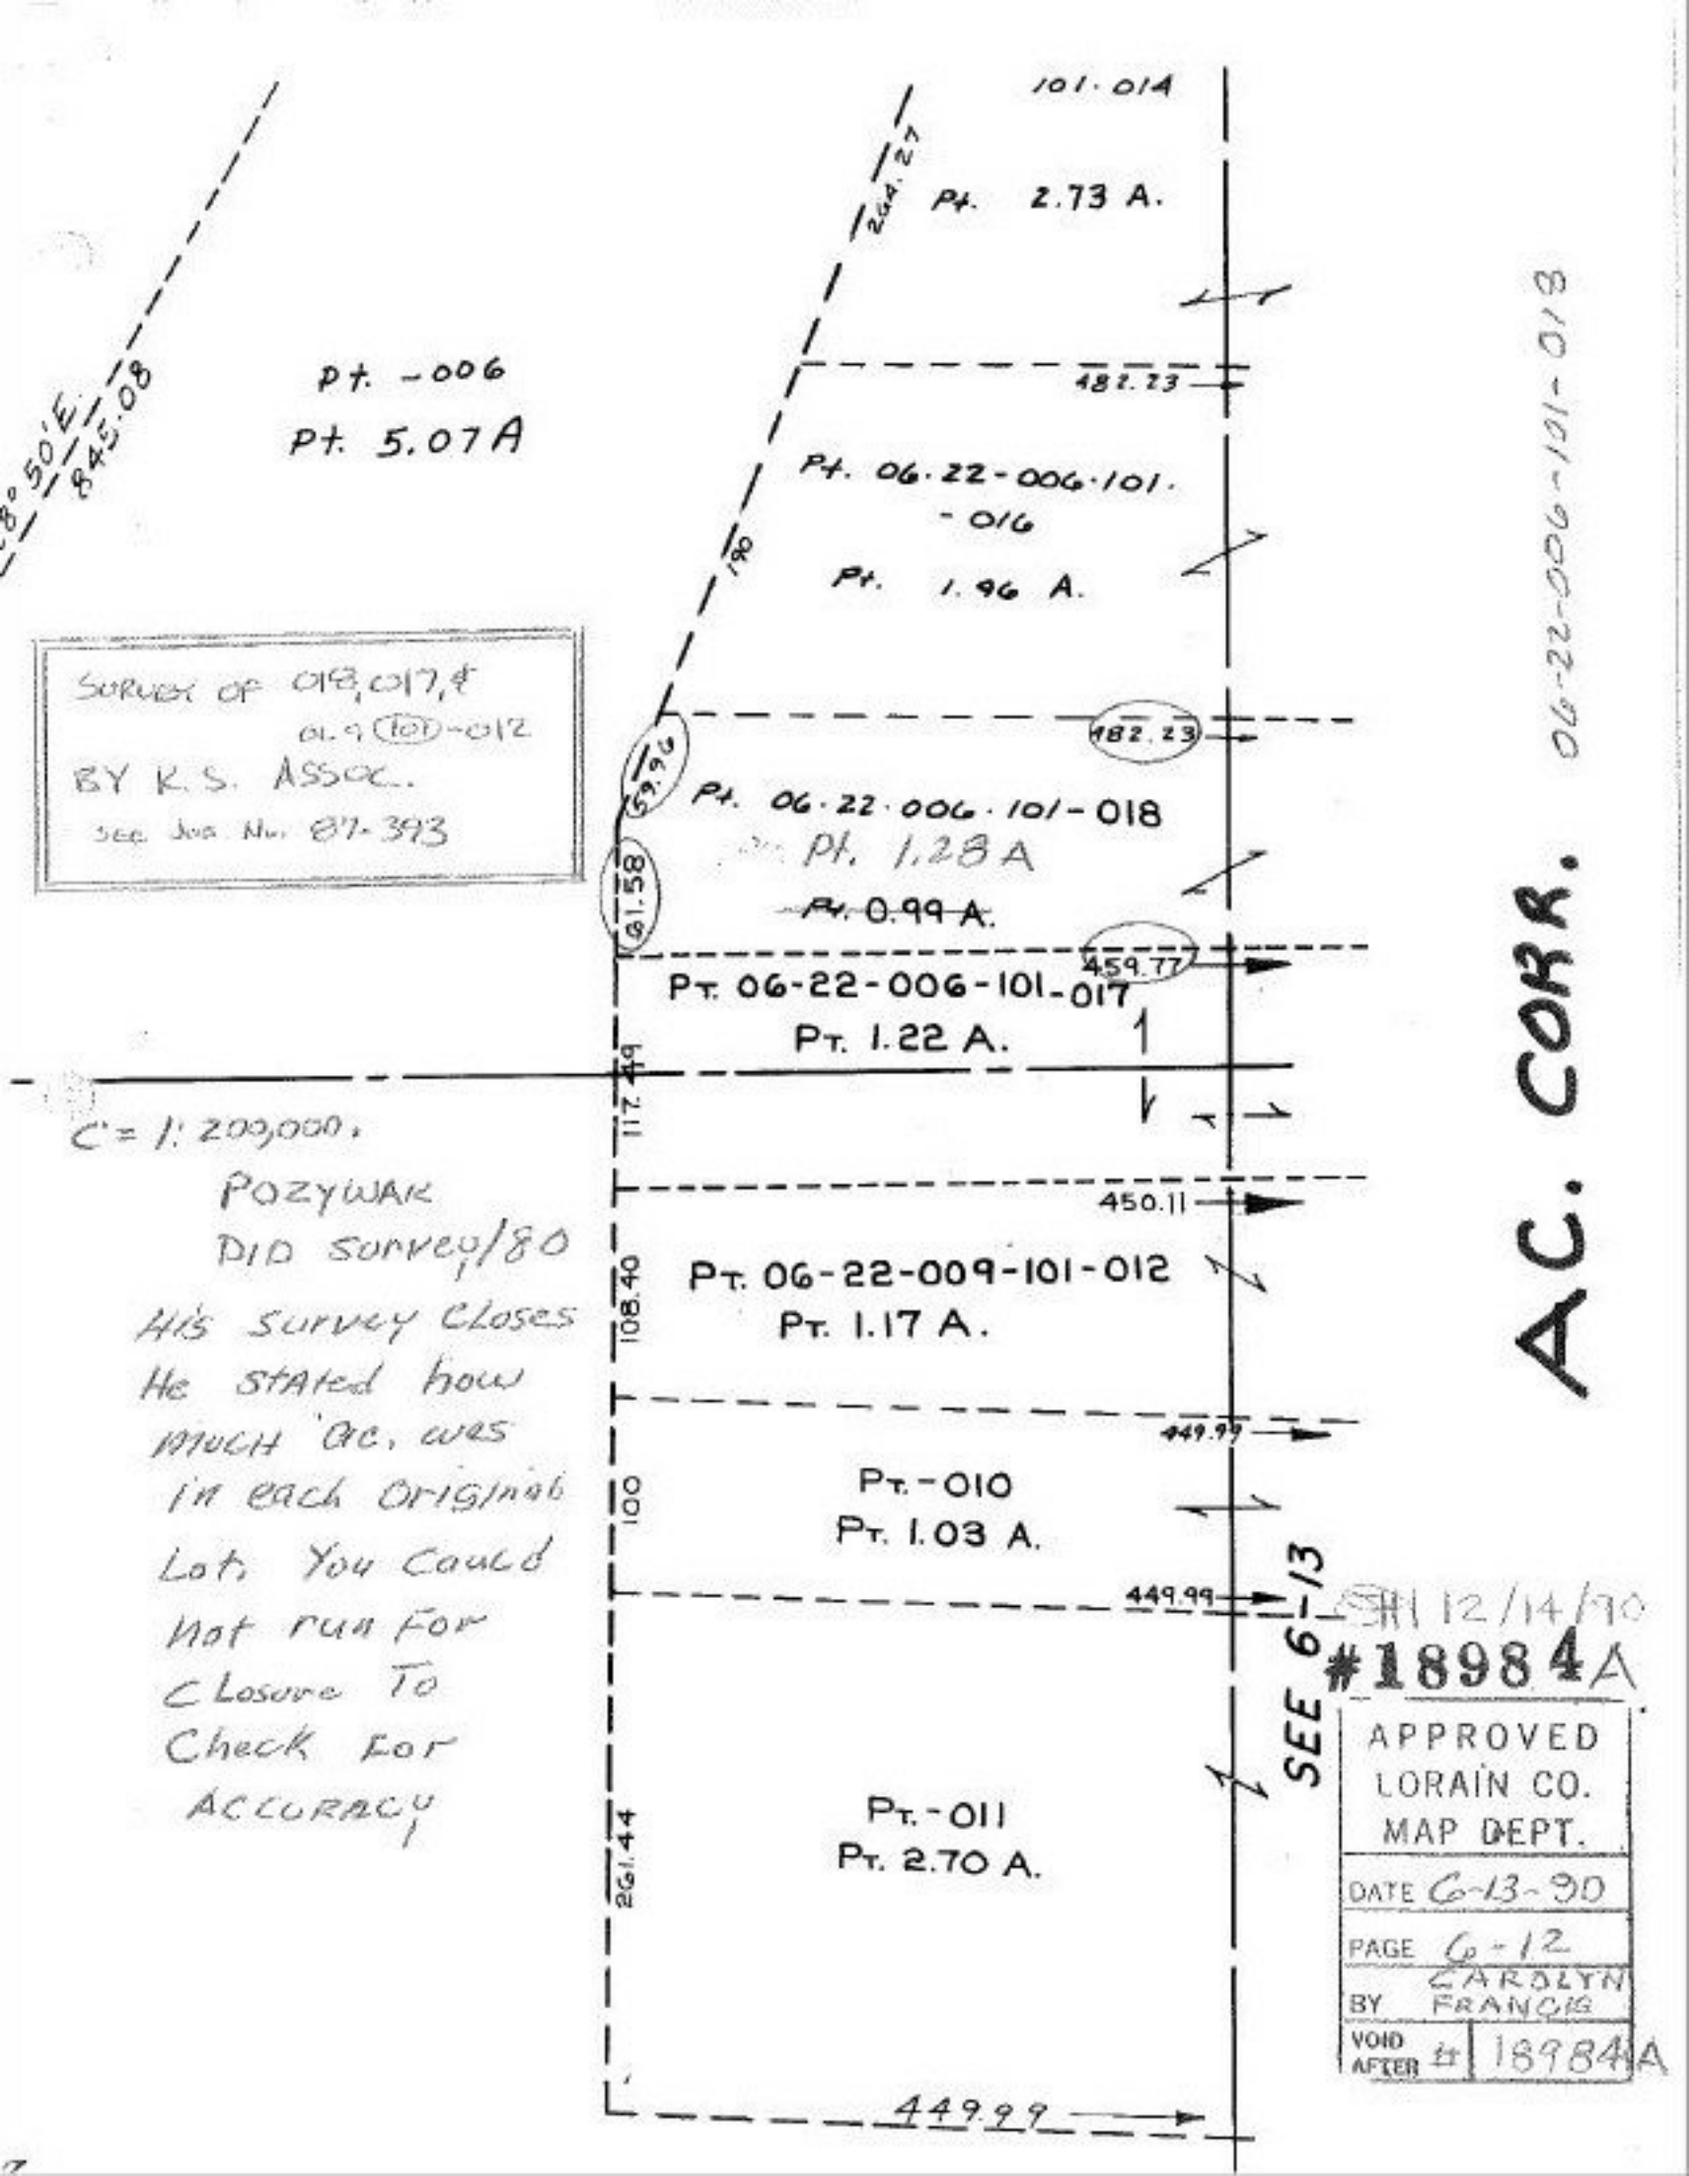

Survey of 018, 017, & 01.9 (101)-012
BY K.S. ASSOC.
See Job No. 87-393

C = 1:200,000.
POZYWAK
DID survey/80
His survey Closes
He stated how
much Ac. was
in each Original
Lot. You could
not run for
Closure To
Check for
ACCURACY

12/14/90
#18984A

APPROVED
LORAIN CO.
MAP DEPT.
DATE 6-13-90
PAGE 6-12
BY CAROLYN FRANCIS
VOID AFTER # 18984A