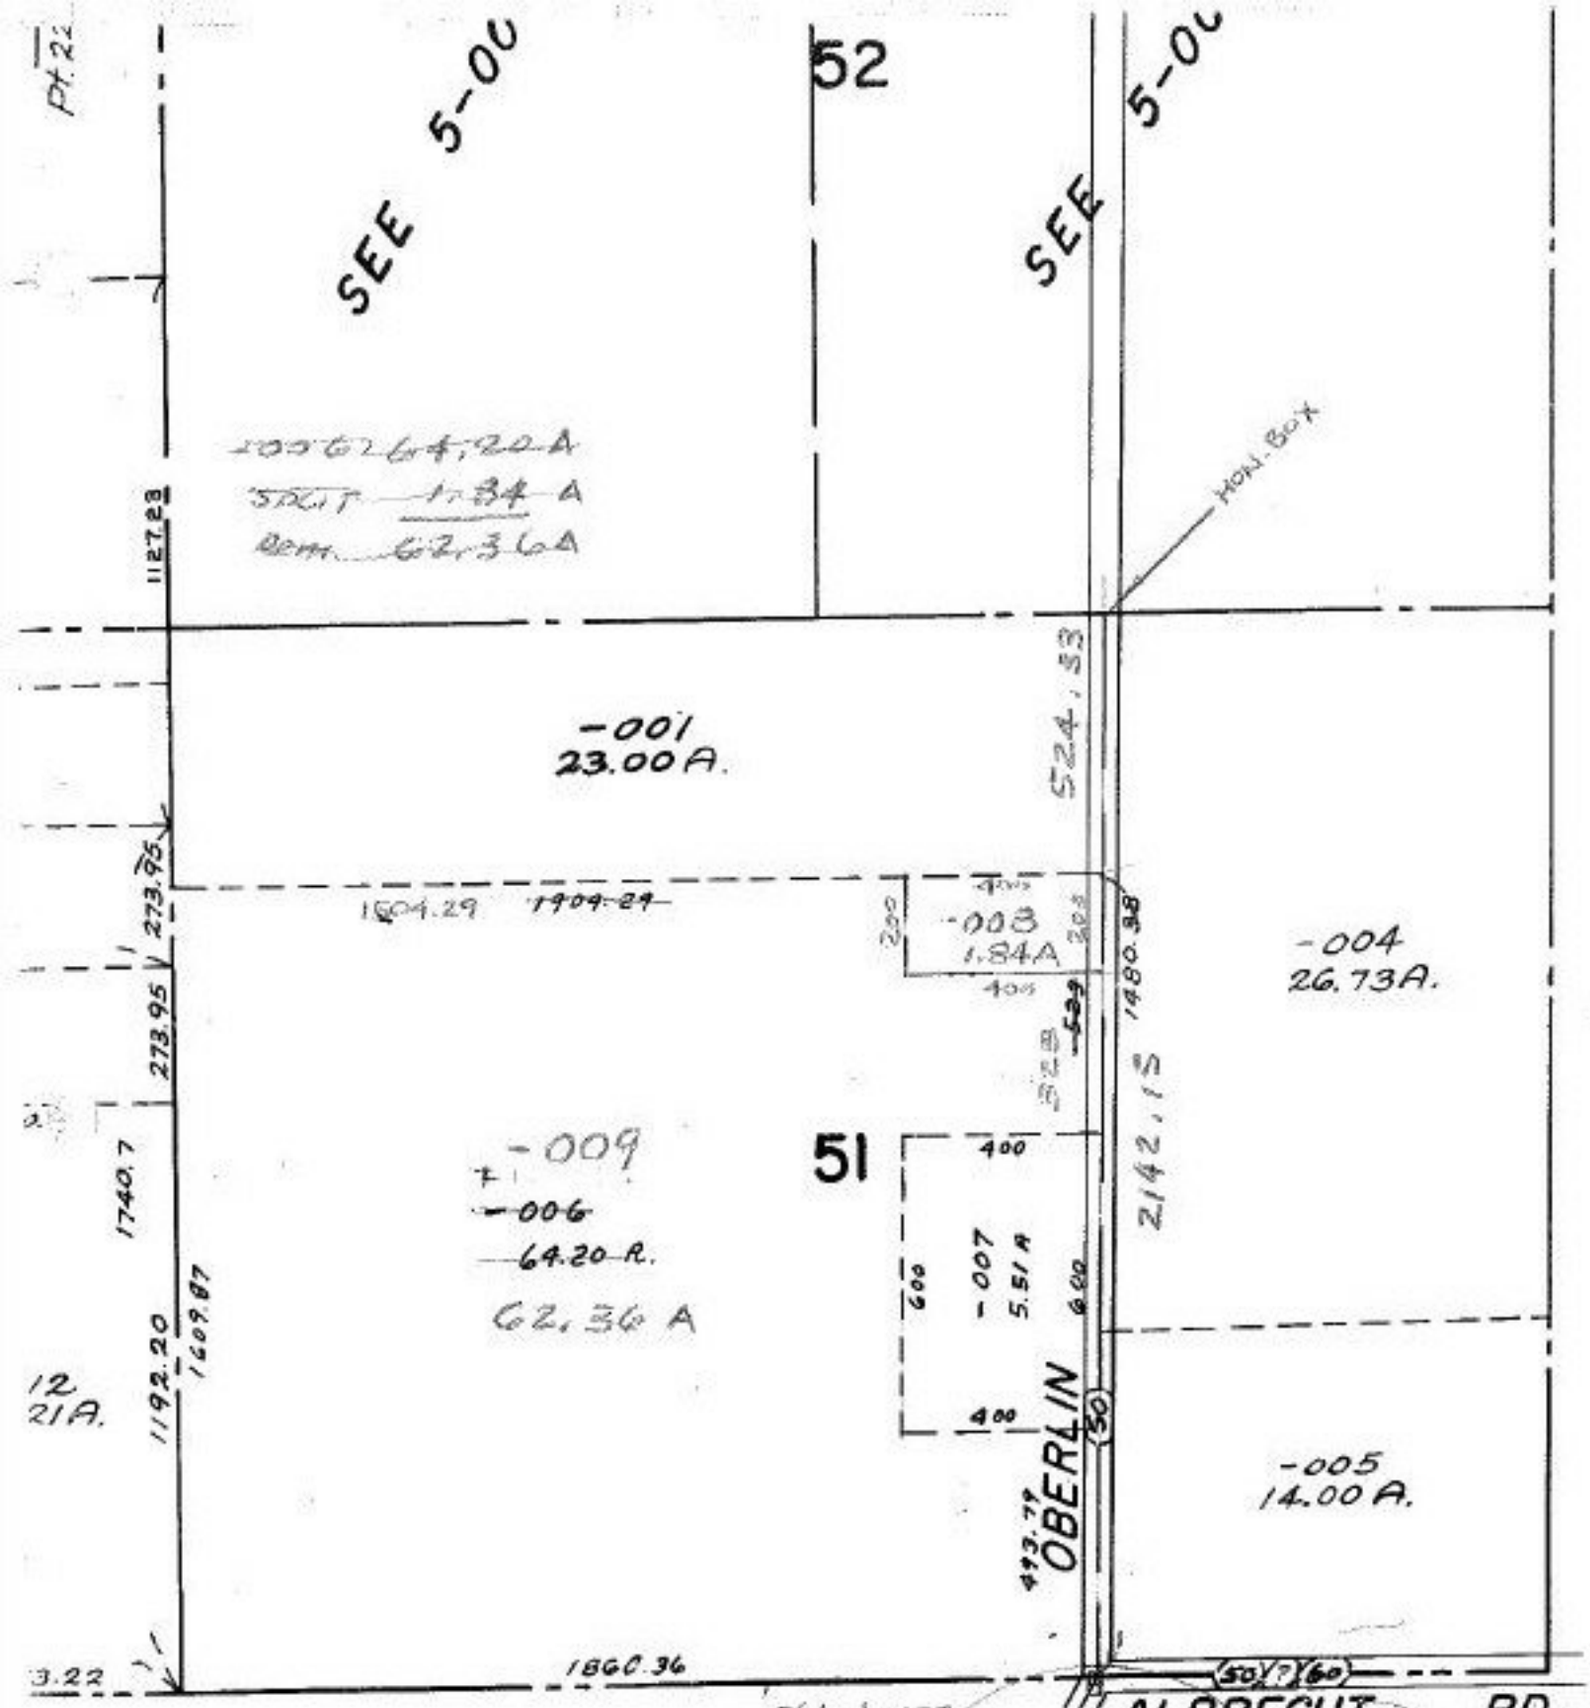

CH 11/26/90

#18985

05-00-051-000-
PRIOR INST.1187/456 1297/777
SURVEYED BY: JOHN POZYWAK
C=1: INF REG. SURVEYOR

APPROVED
LORAIN CO.
MAP DEPT.

DATE 6-14-90
PAGE 5-G
BY CAROLYN FRANCIS
VOID # 18985