① 901.
② 901. 5.04
③ 901. ~~125.04~~ DEC'D ERROR
250.08
④ 901. 375.12

912.33
500.00
412.33

409.54
101.25
308.29

BX 125.04 = 375.12
24.26
399.38

8.09 A
-4.17 A
3.92 A

1.06 A
1.05 A
1.04 A
1.02 A
4.17 A

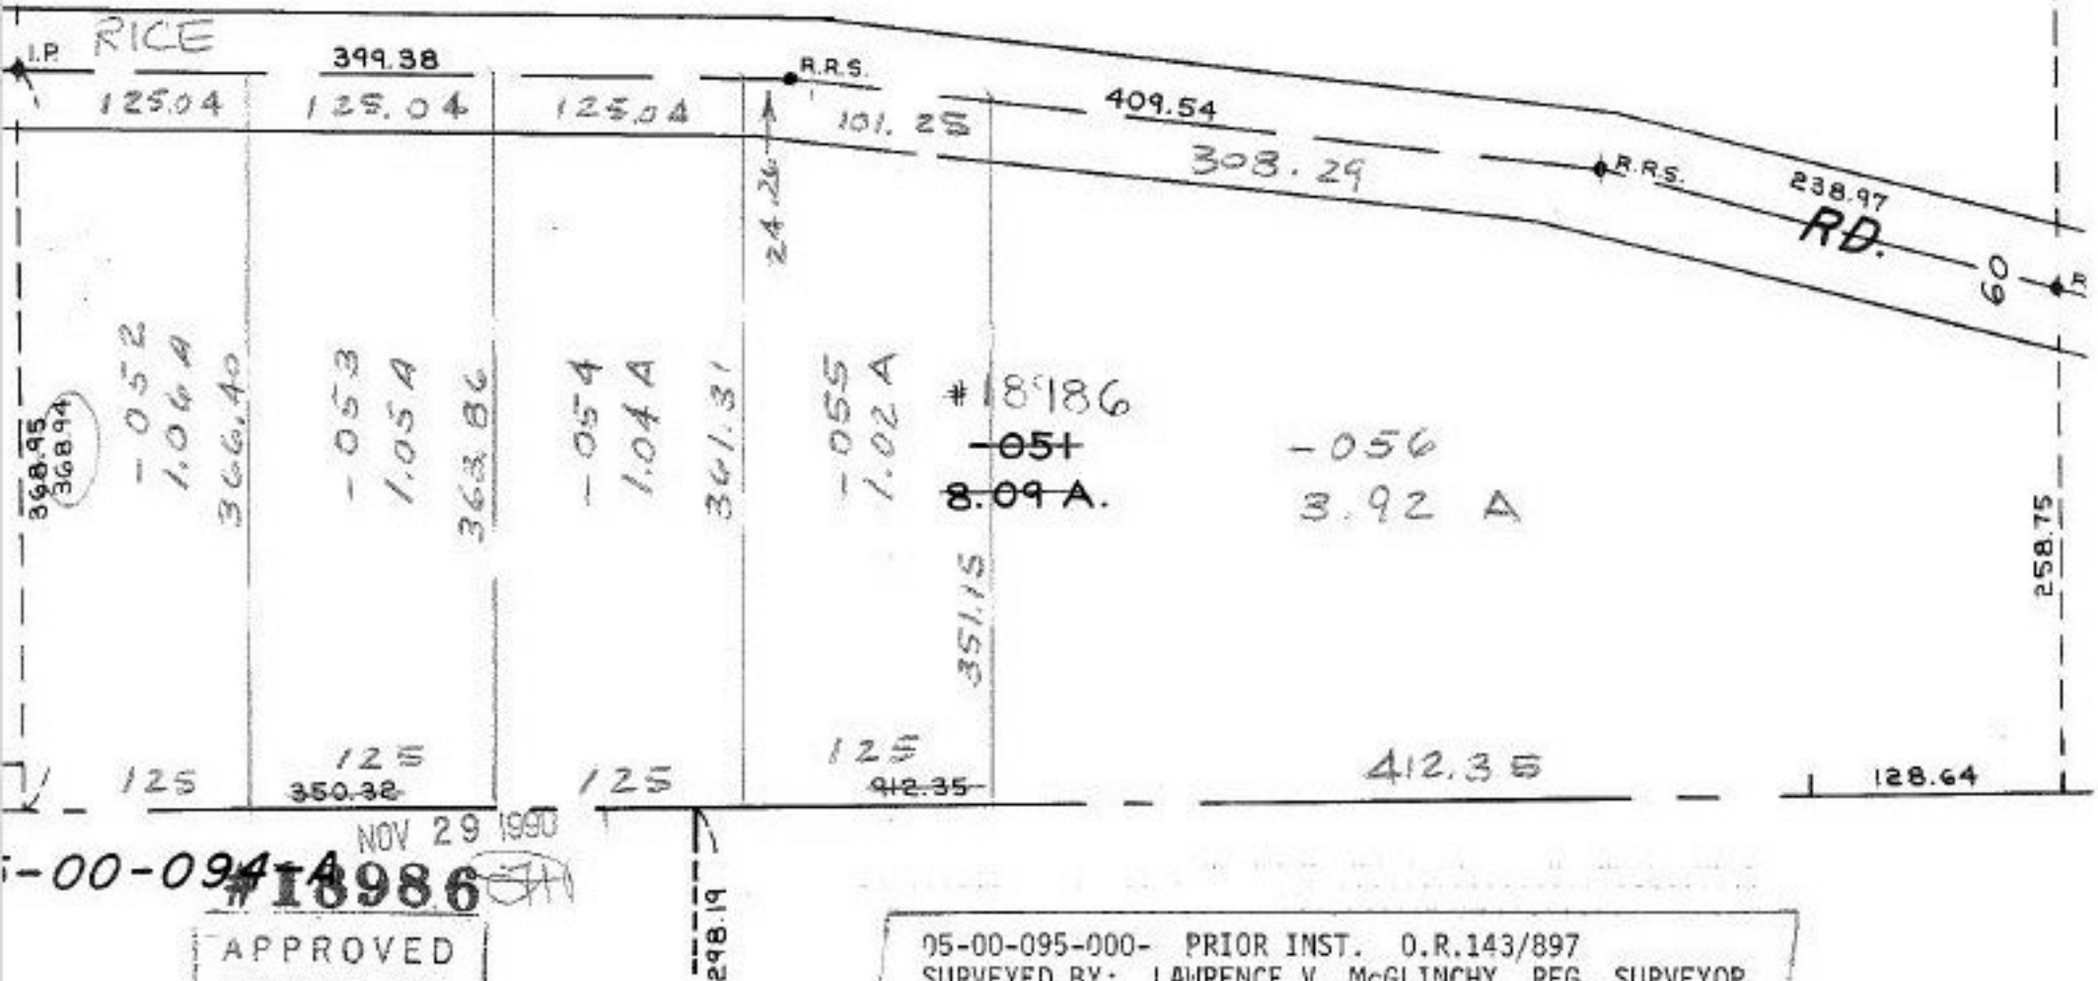

NOV 29 1990

05-00-095-000- #16986

APPROVED
LORAIN CO.
MAP DEPT.
DATE 6-14-90
PAGE 05-00-095- A
BY CAROLYN FRANCIS
VOID AFTER # 18986

05-00-095-000- PRIOR INST. O.R.143/897
SURVEYED BY: LAWRENCE V. McGLINCHY REG. SURVEYOR
