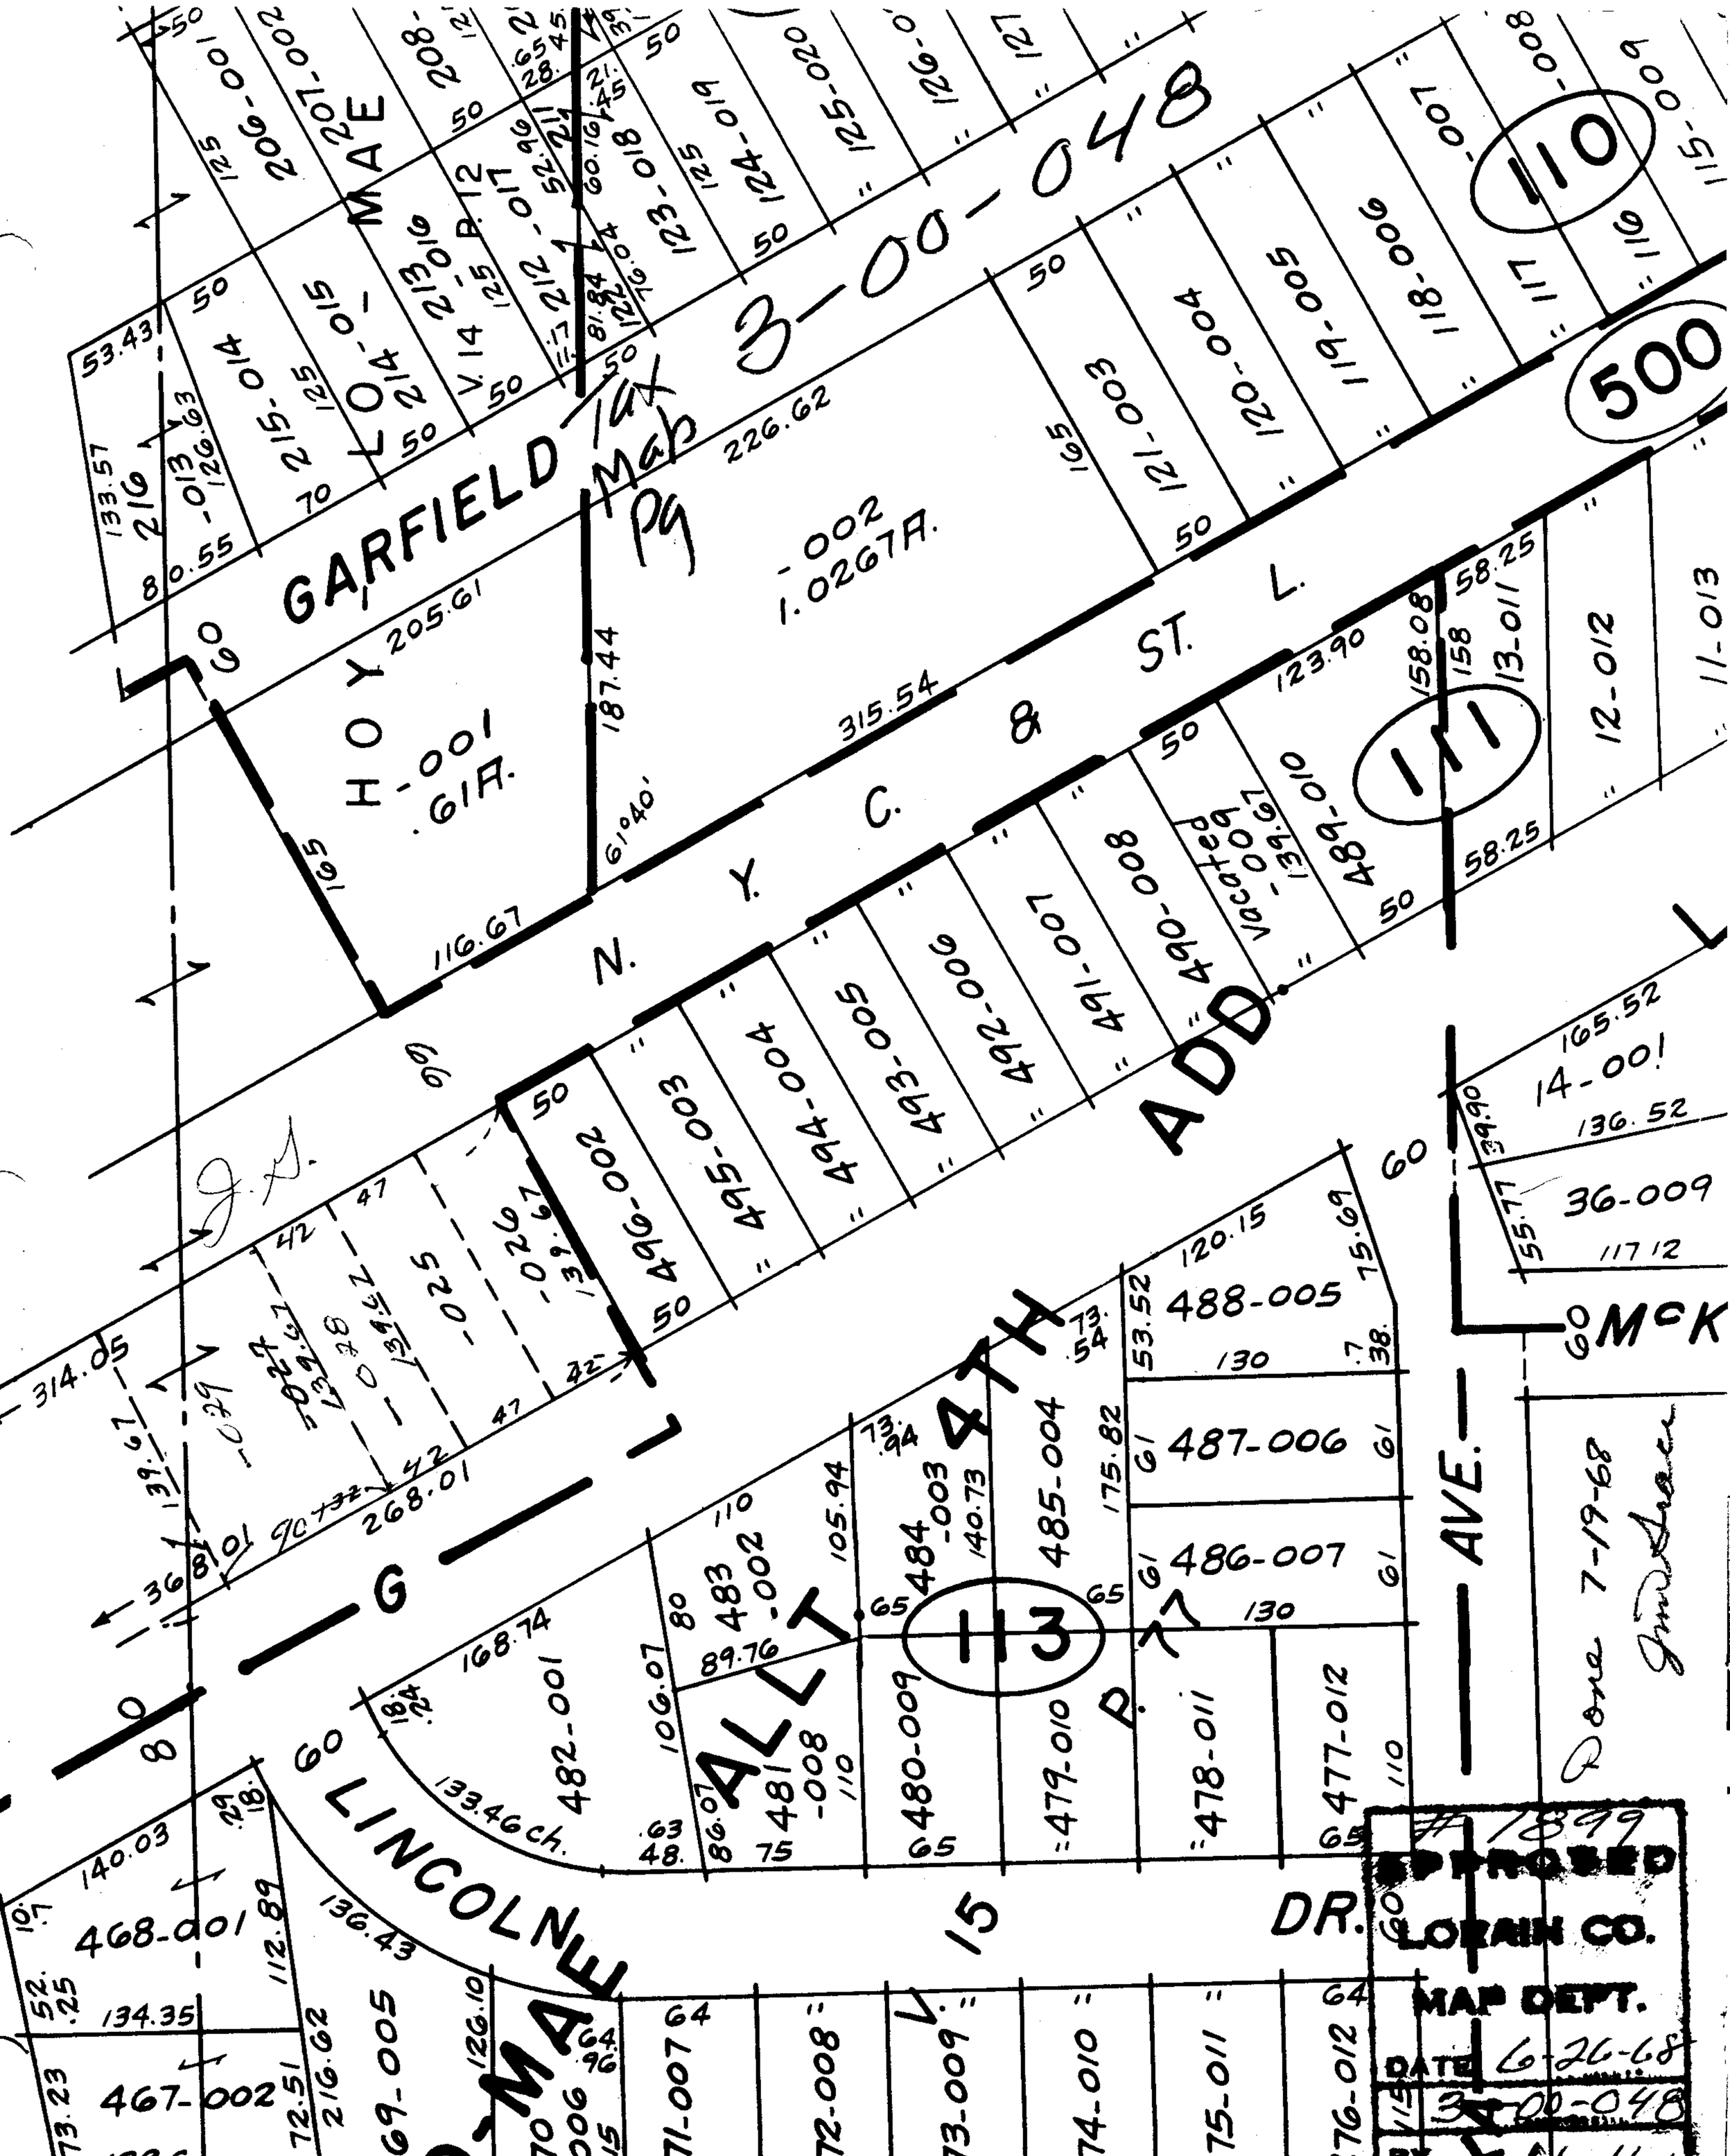
3-00-048
GARFIELD
MAP
PG
-002
1.0267A.
HOY
H-001
.61A.
N. Y. C. & ST. L.
ADD
G
ALLT
4TH
AVE.
LINCOLN
LO-MAE
DR.
AVE.
McK
Vacated
-0.29
-0.26
-0.25
500
113
114
APPROVED
LORAIN CO.
MAP DEPT.
DATE 6-26-68
BY L.W. Hall
7-19-68