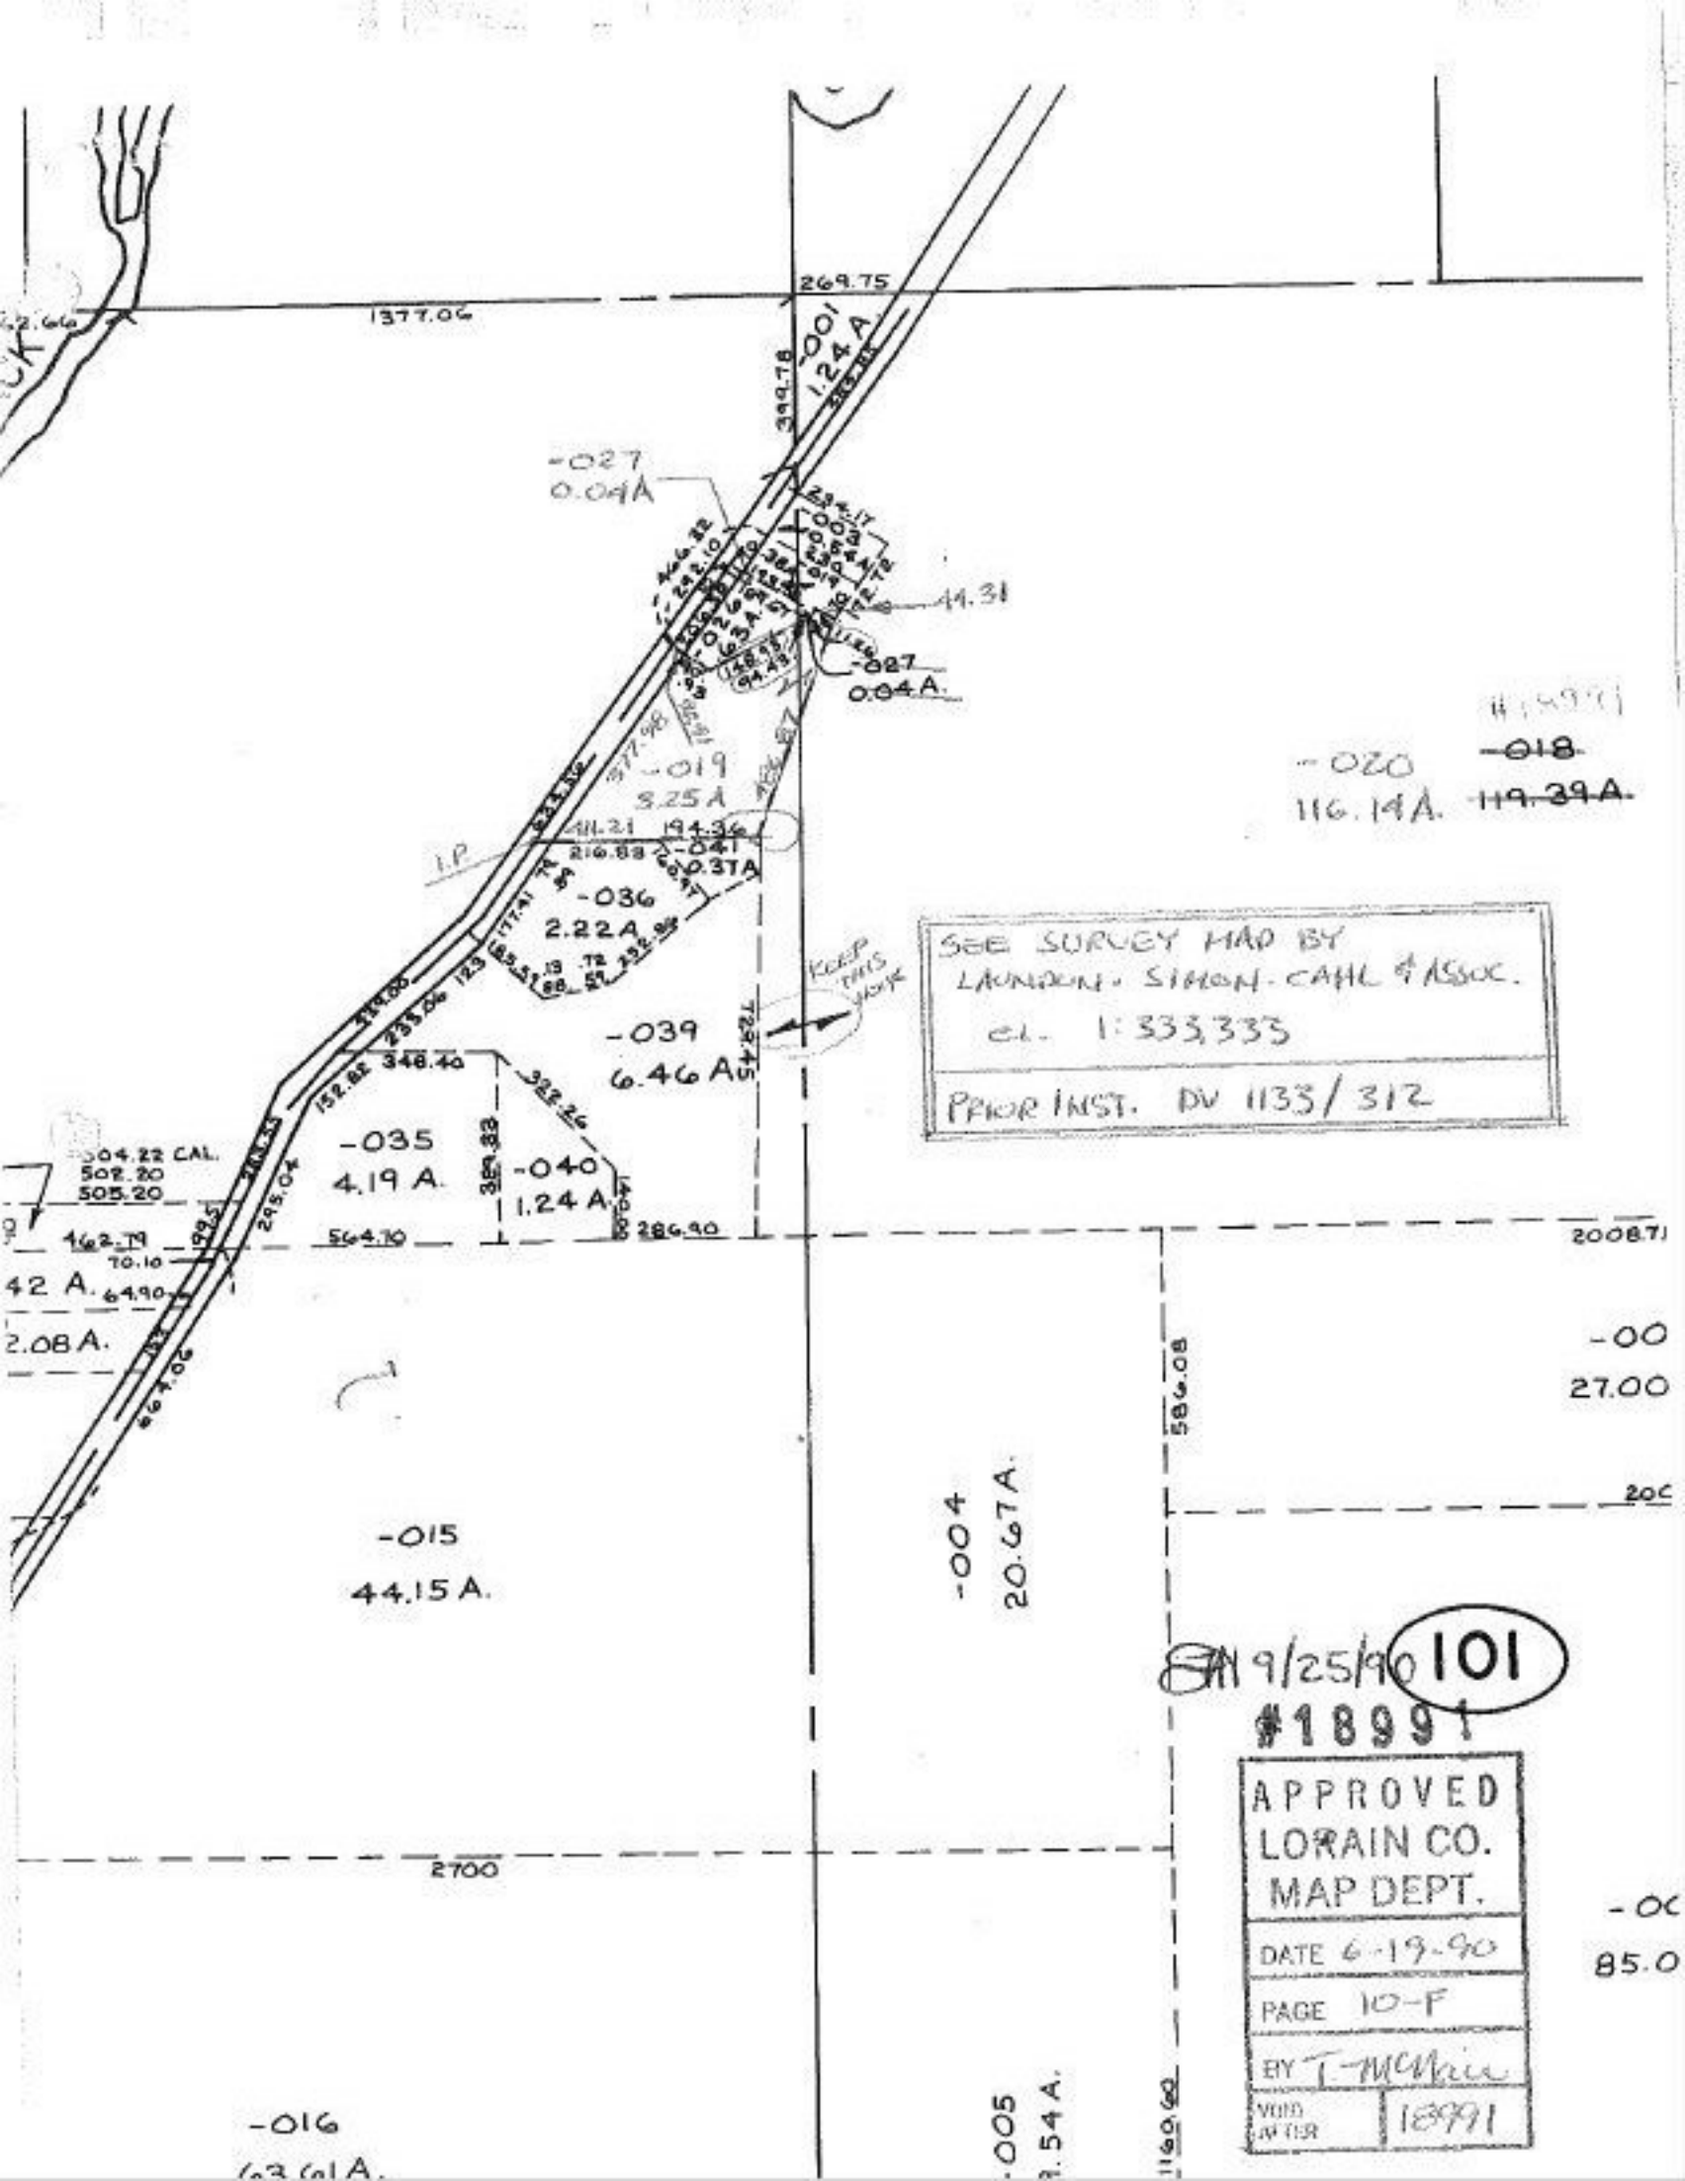

269.75
1377.06
-001
1.24 A
-027
0.04A
44.31
-027
0.04 A.
-019
3.25 A
-041
0.37A
-036
2.22 A
-039
6.46 A
-035
4.19 A.
-040
1.24 A.
-020
116.14A.
~~-018~~
~~119.39 A.~~
SEE SURVEY MAP BY
LAUNDON - SIMON - CAHL & ASSOC.
CL. 1:333,333
PRIOR INST. DV 1133/312
-015
44.15 A.
-004
20.67 A.
2700
-016
63.61 A.
-00
27.00
85.0
9/25/90
101
#18991
APPROVED
LORAIN CO.
MAP DEPT.
DATE 6-19-90
PAGE 10-F
BY T. McNair
VOID AFTER 18991