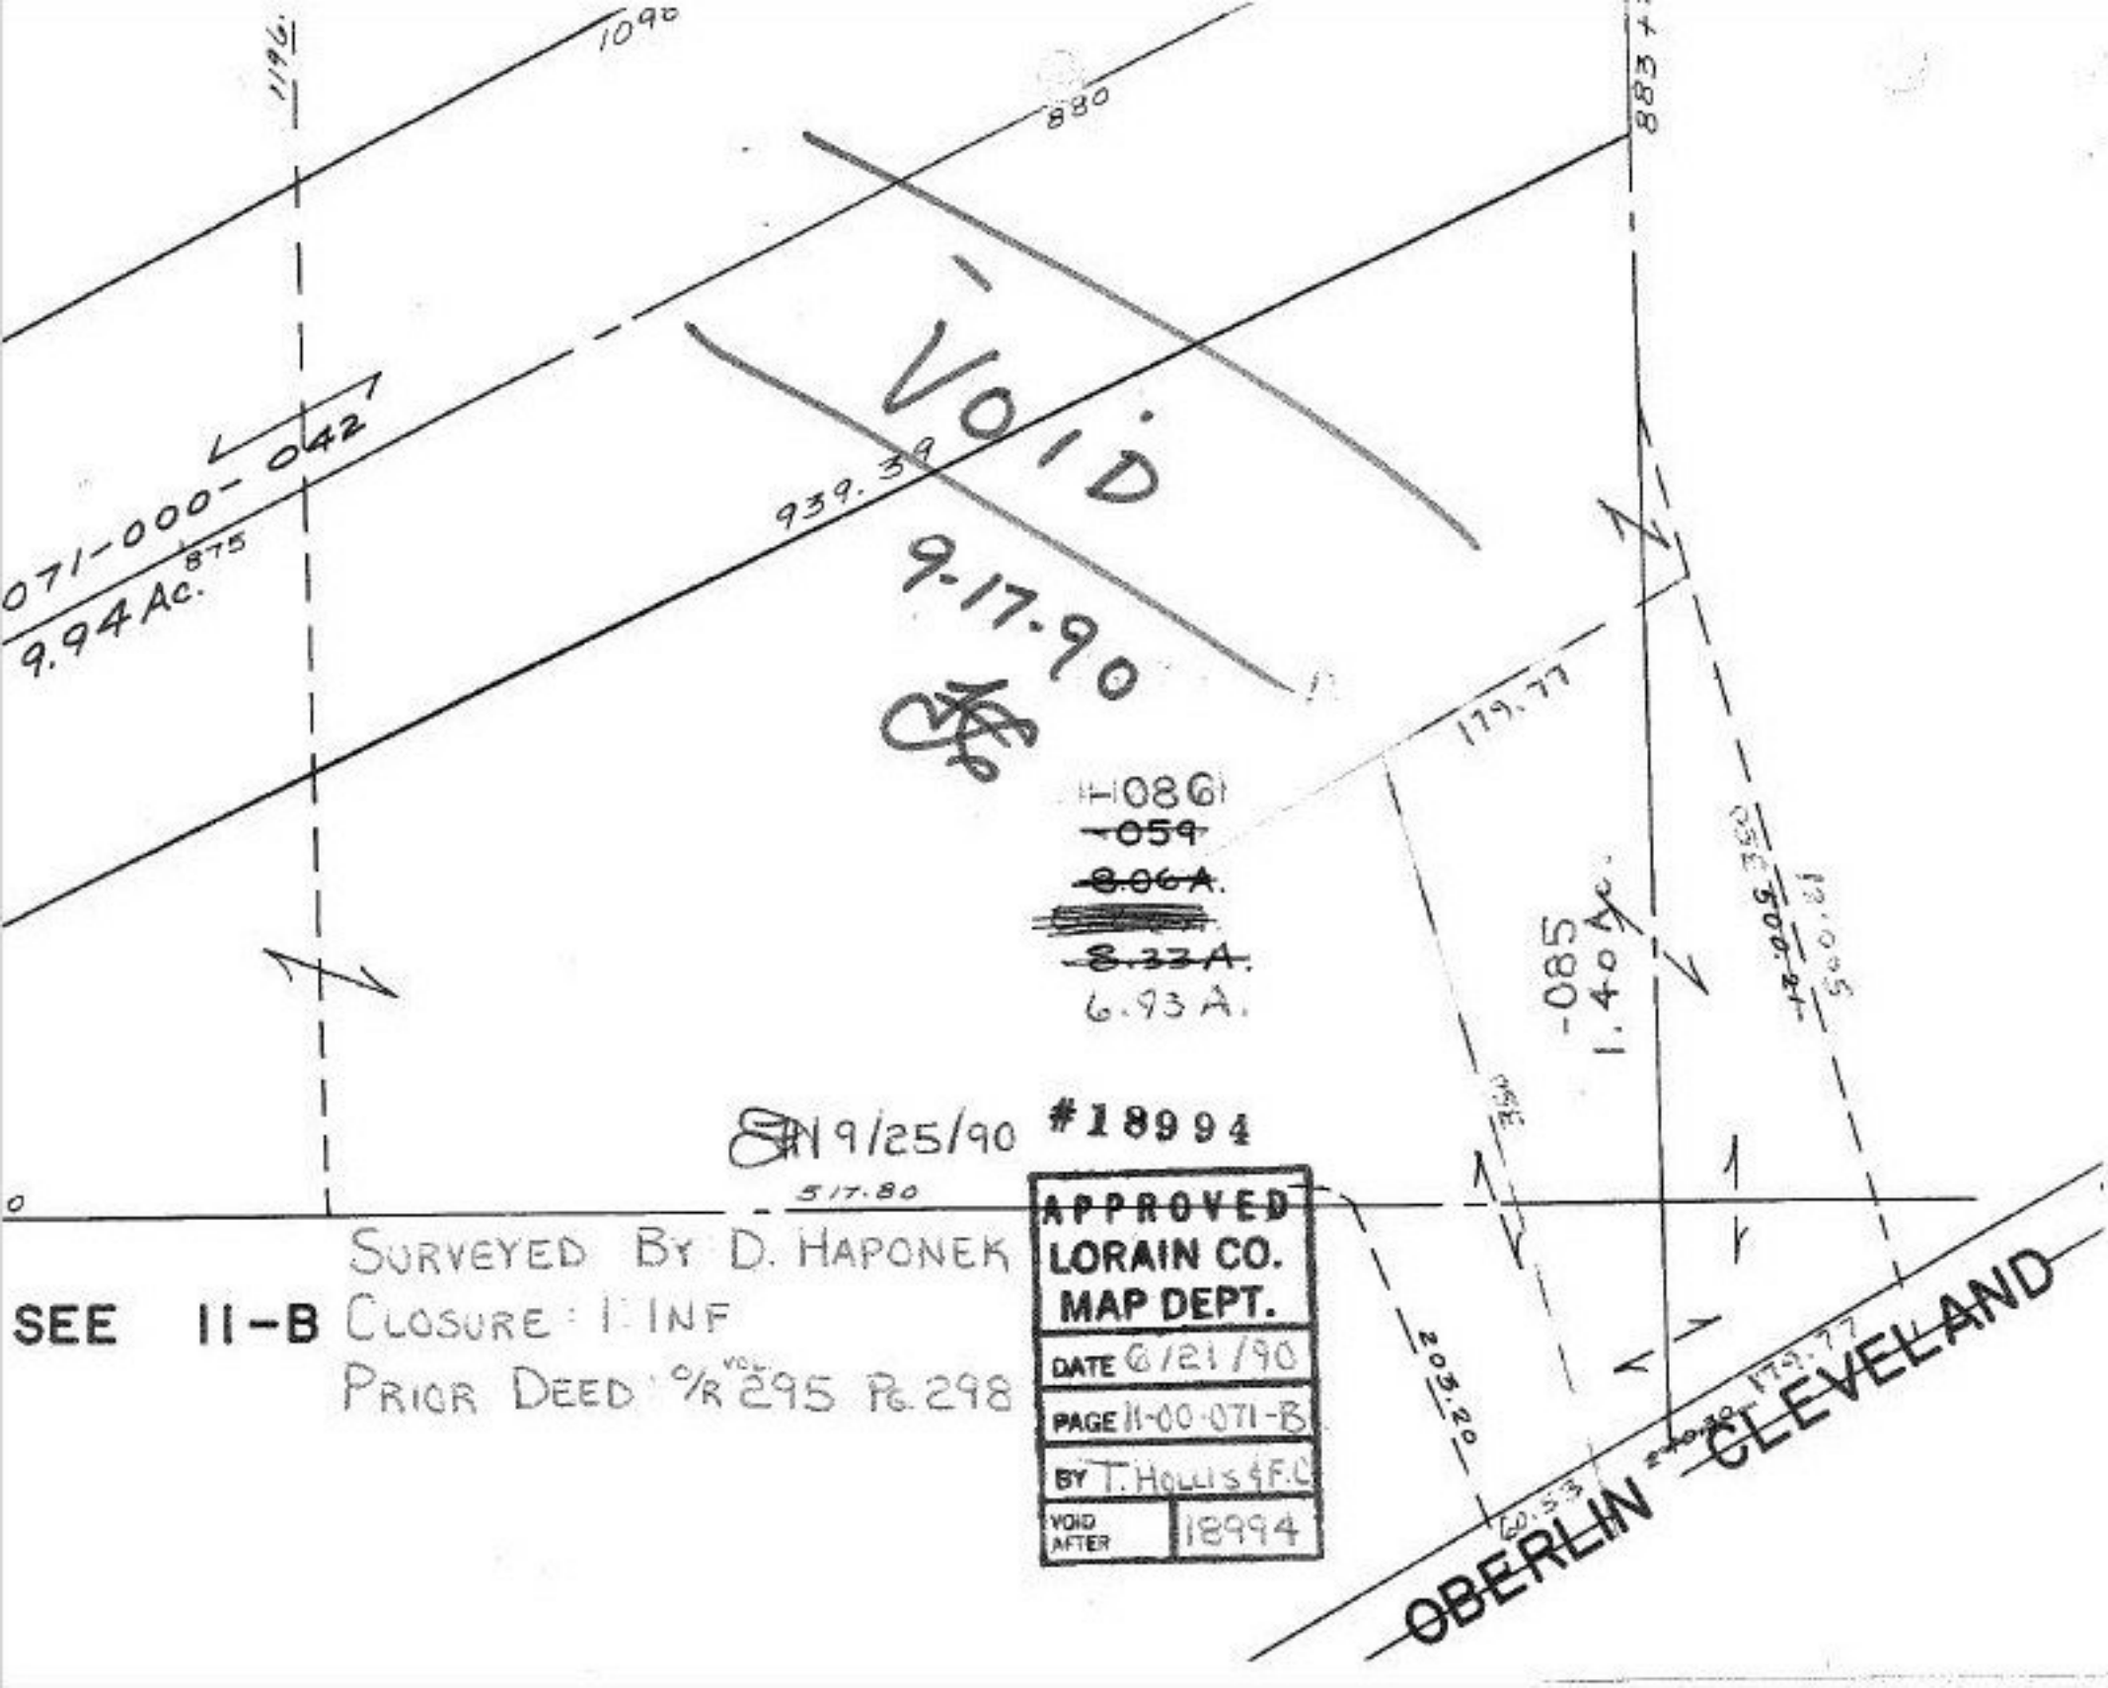
1196
1090
880
883
071-000-042
875
9.94 Ac.
939.39
VOID
9-17-90
179.77
-086
~~-059~~
~~8.06 A.~~
~~8.33 A.~~
6.93 A.
-085
1.40 Ac.
350
12.005
500.21
9/25/90
#18994
517.80
203.20
60.53
179.77
OBERLIN
CLEVELAND
SEE 11-B
SURVEYED BY D. HAPONEK
CLOSURE: 1: INF
PRIOR DEED: O/R VOL. 295 PG. 298
APPROVED
LORAIN CO.
MAP DEPT.
DATE 6/21/90
PAGE 11-00-071-B
BY T. HOLLIS & F.C.
VOID AFTER 18994