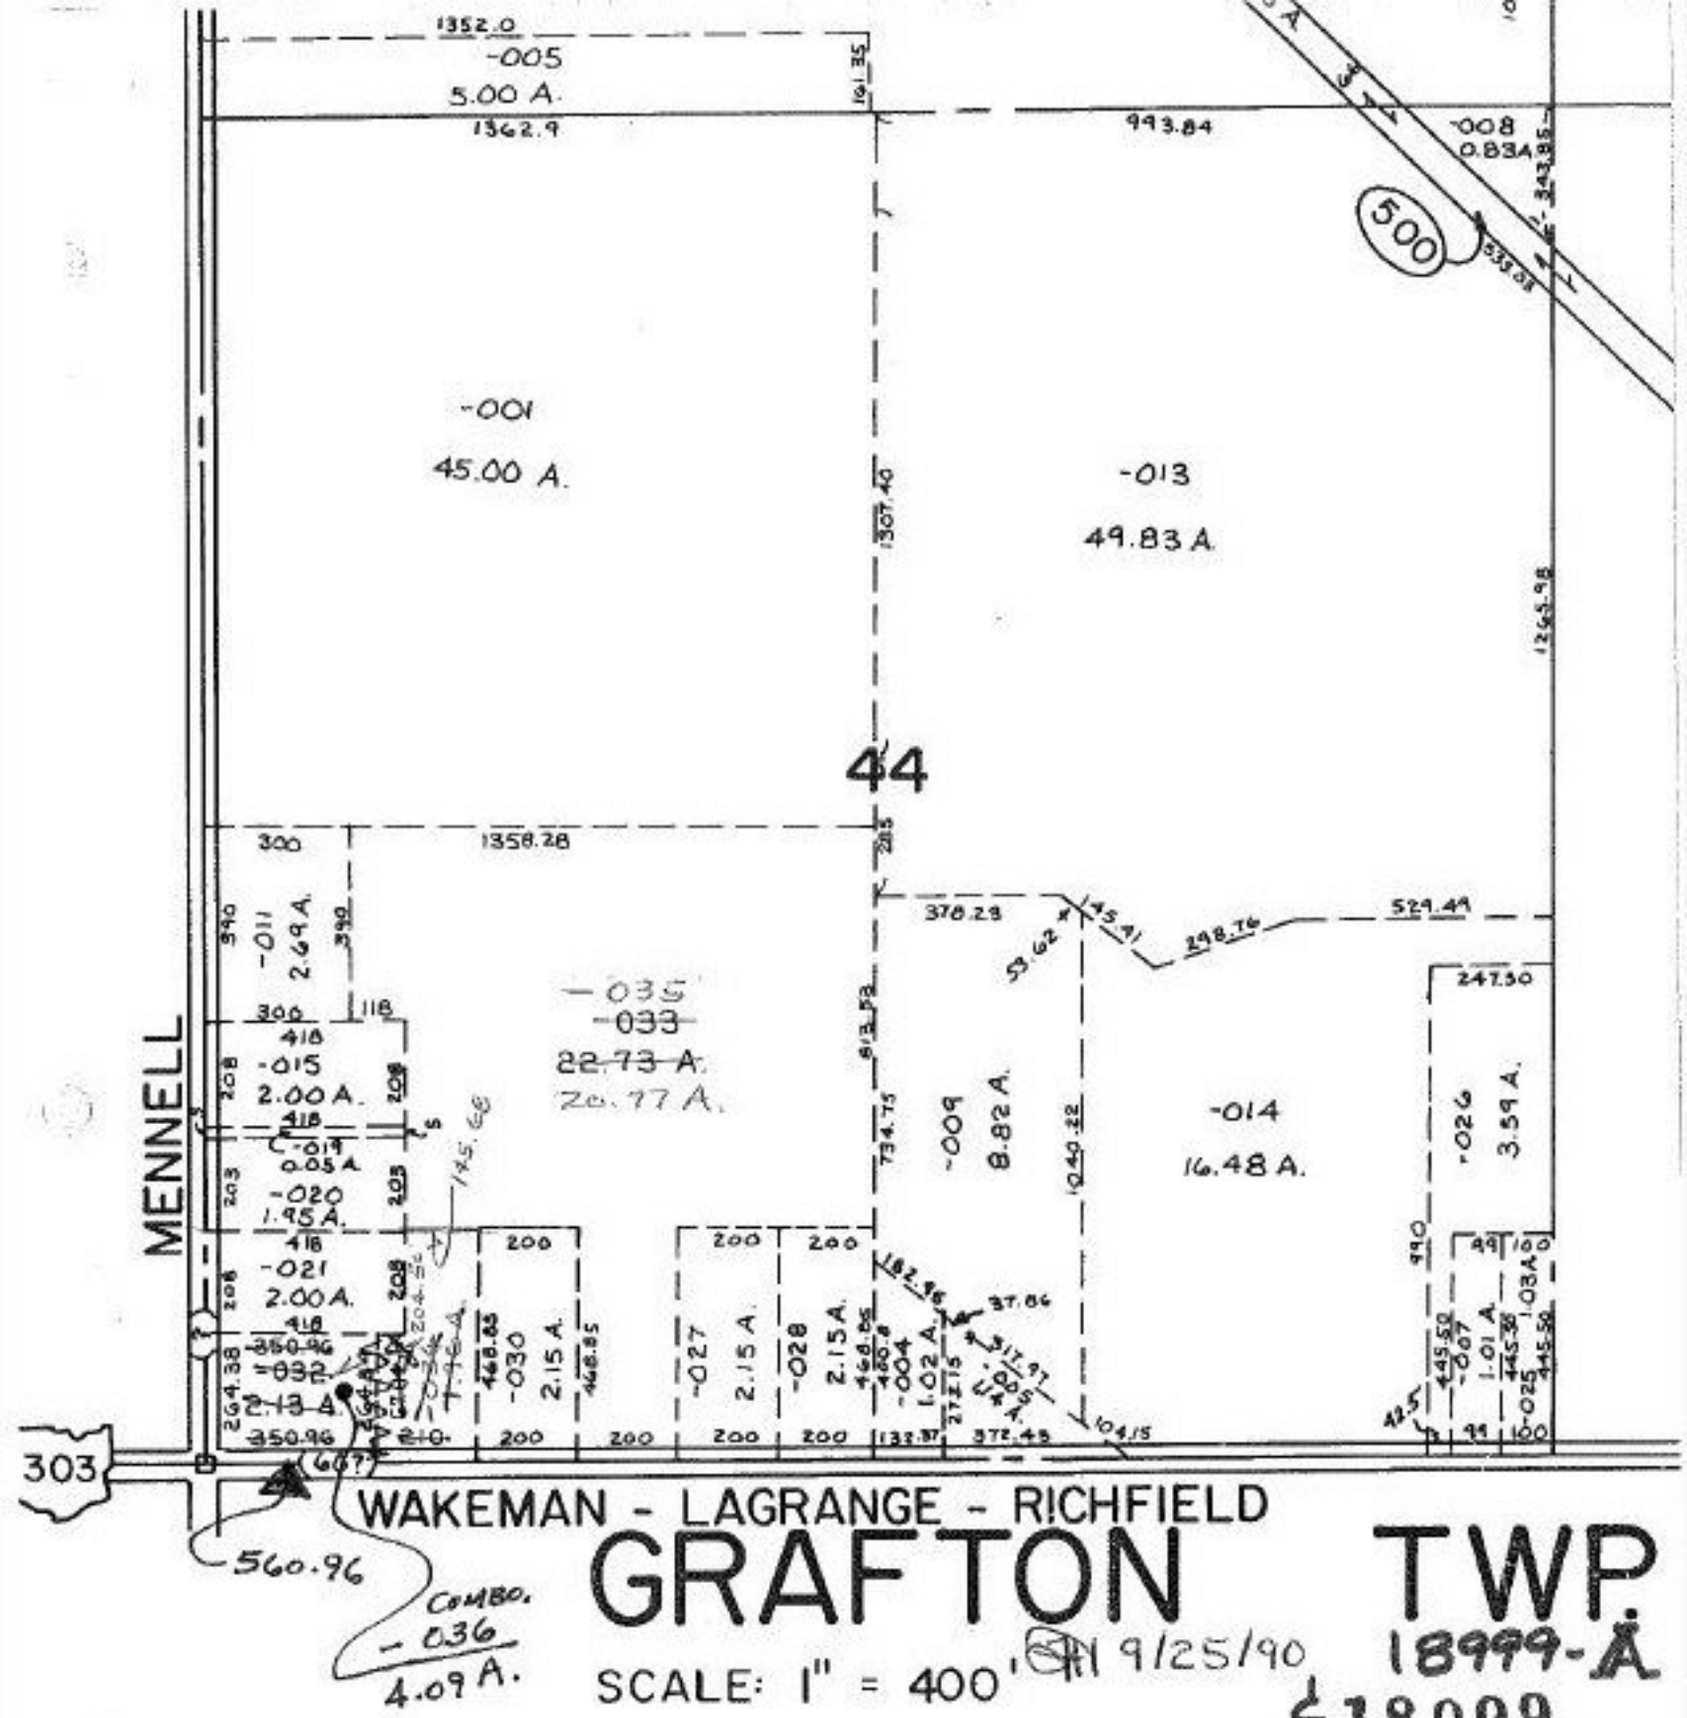

GRAFTON TWP.

SCALE: 1" = 400'

#1 9/25/90

18999-A

€18999

SURVEYED BY: K.S. & ASSOCIATES

CLOSURE: 1:200,000

PRIOR DEED
VOL. 1029 PG. 996

SPLIT +

COMBINATION

#18999 A

APPROVED LORAIN CO. MAP DEPT.	
DATE 6-20-90	
PAGE 16-B	
BY	
VOID AFTER	18999