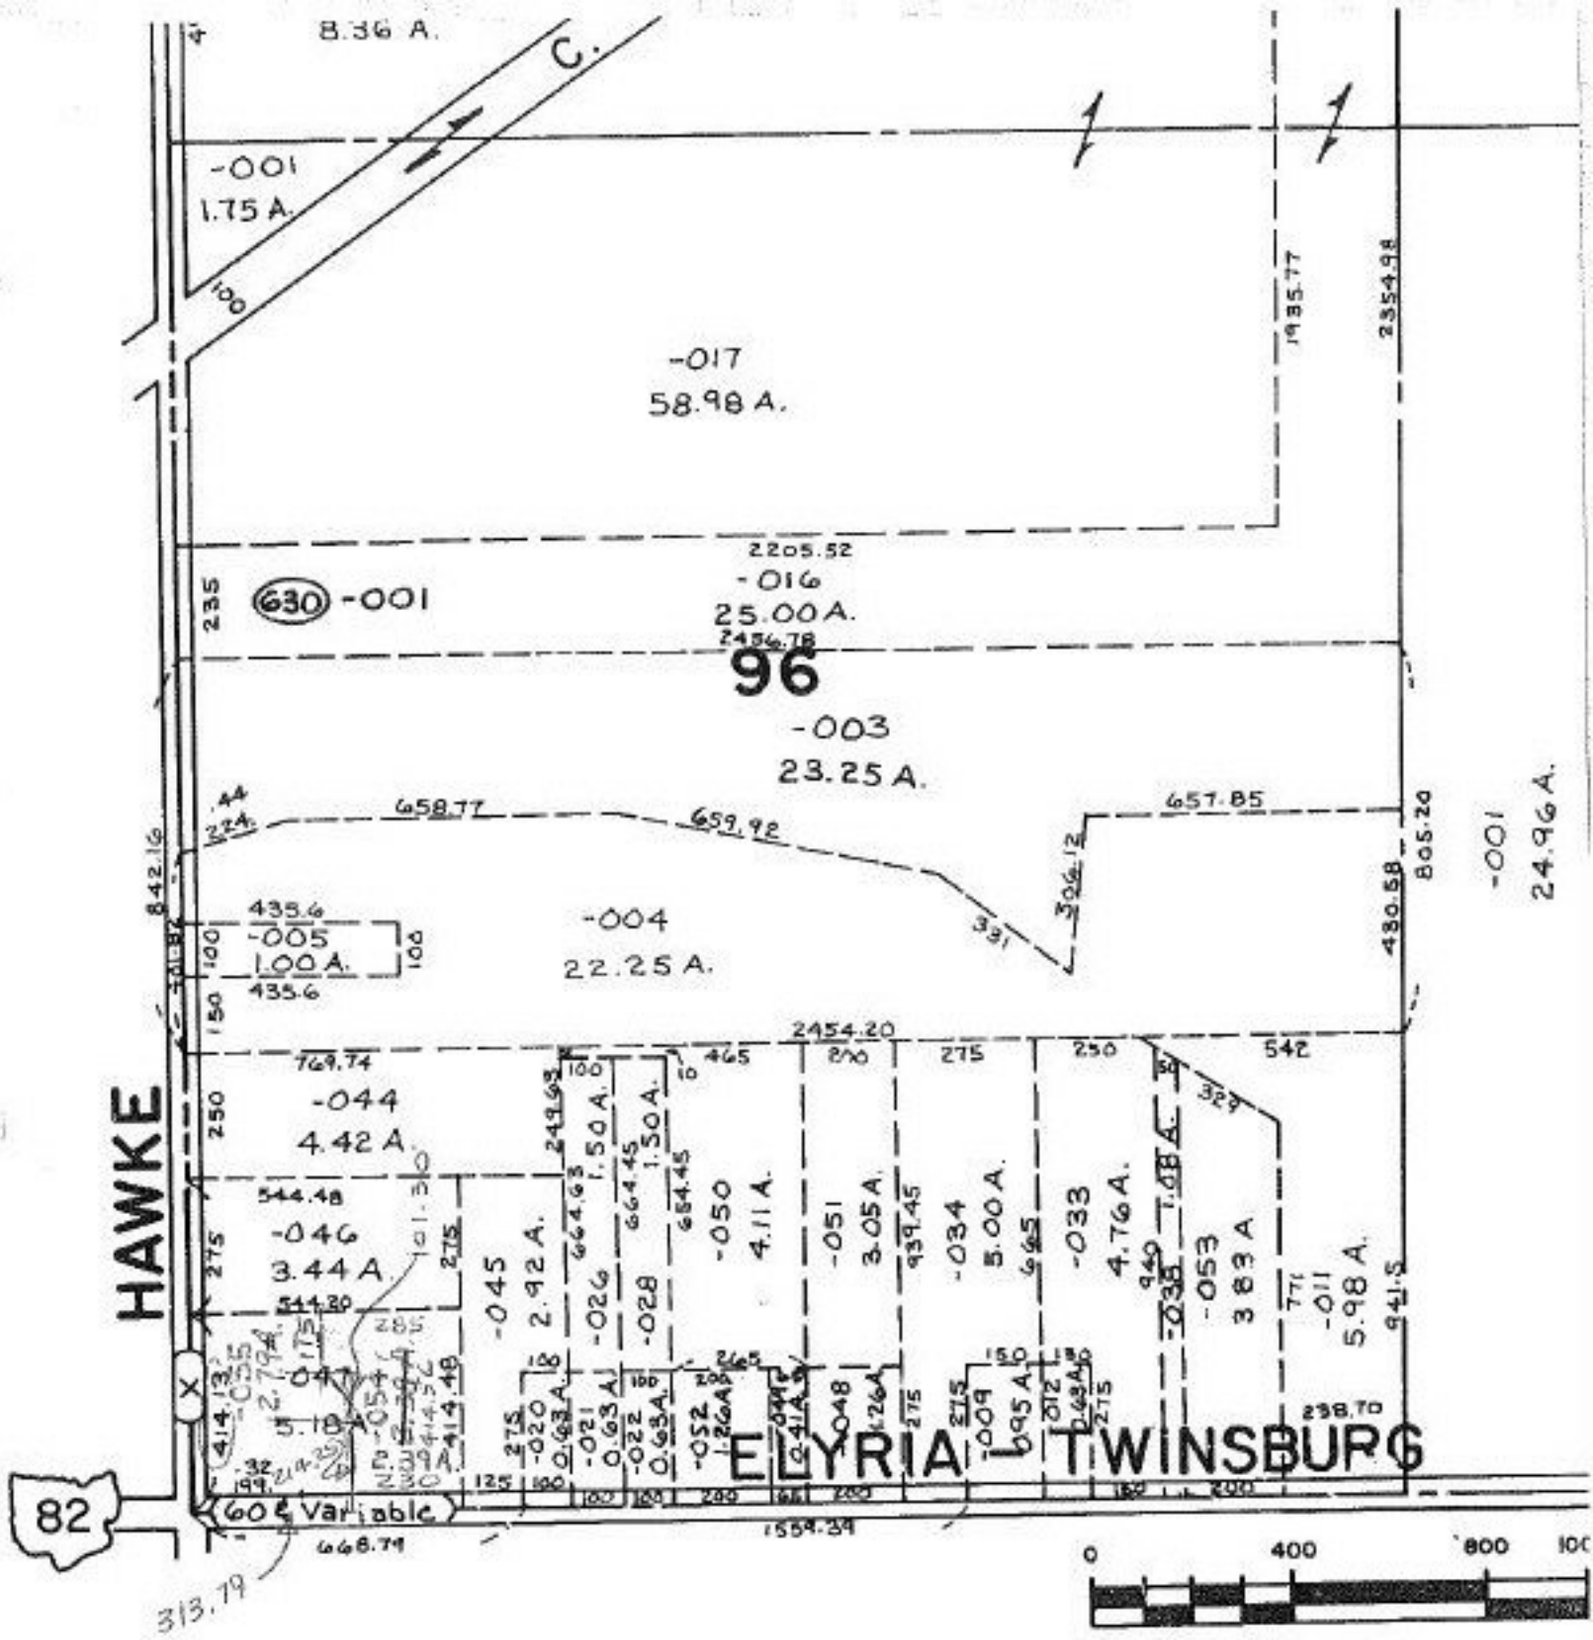

LOTS 76 THRU 85, 96 THRU

19002

SH 2/14/91

SURVEY BY: B. KARAPANDZICH
CLOSURE: (1) 1:16,666
(2) 1:71,428
PRIOR DEED: VOL. 1352 PG. 713

APPROVED
LORAIN CO.
MAP DEPT.
DATE 6/21/90
PAGE 12-A
BY T. Hollis F.C.
VOID AFTER 19002