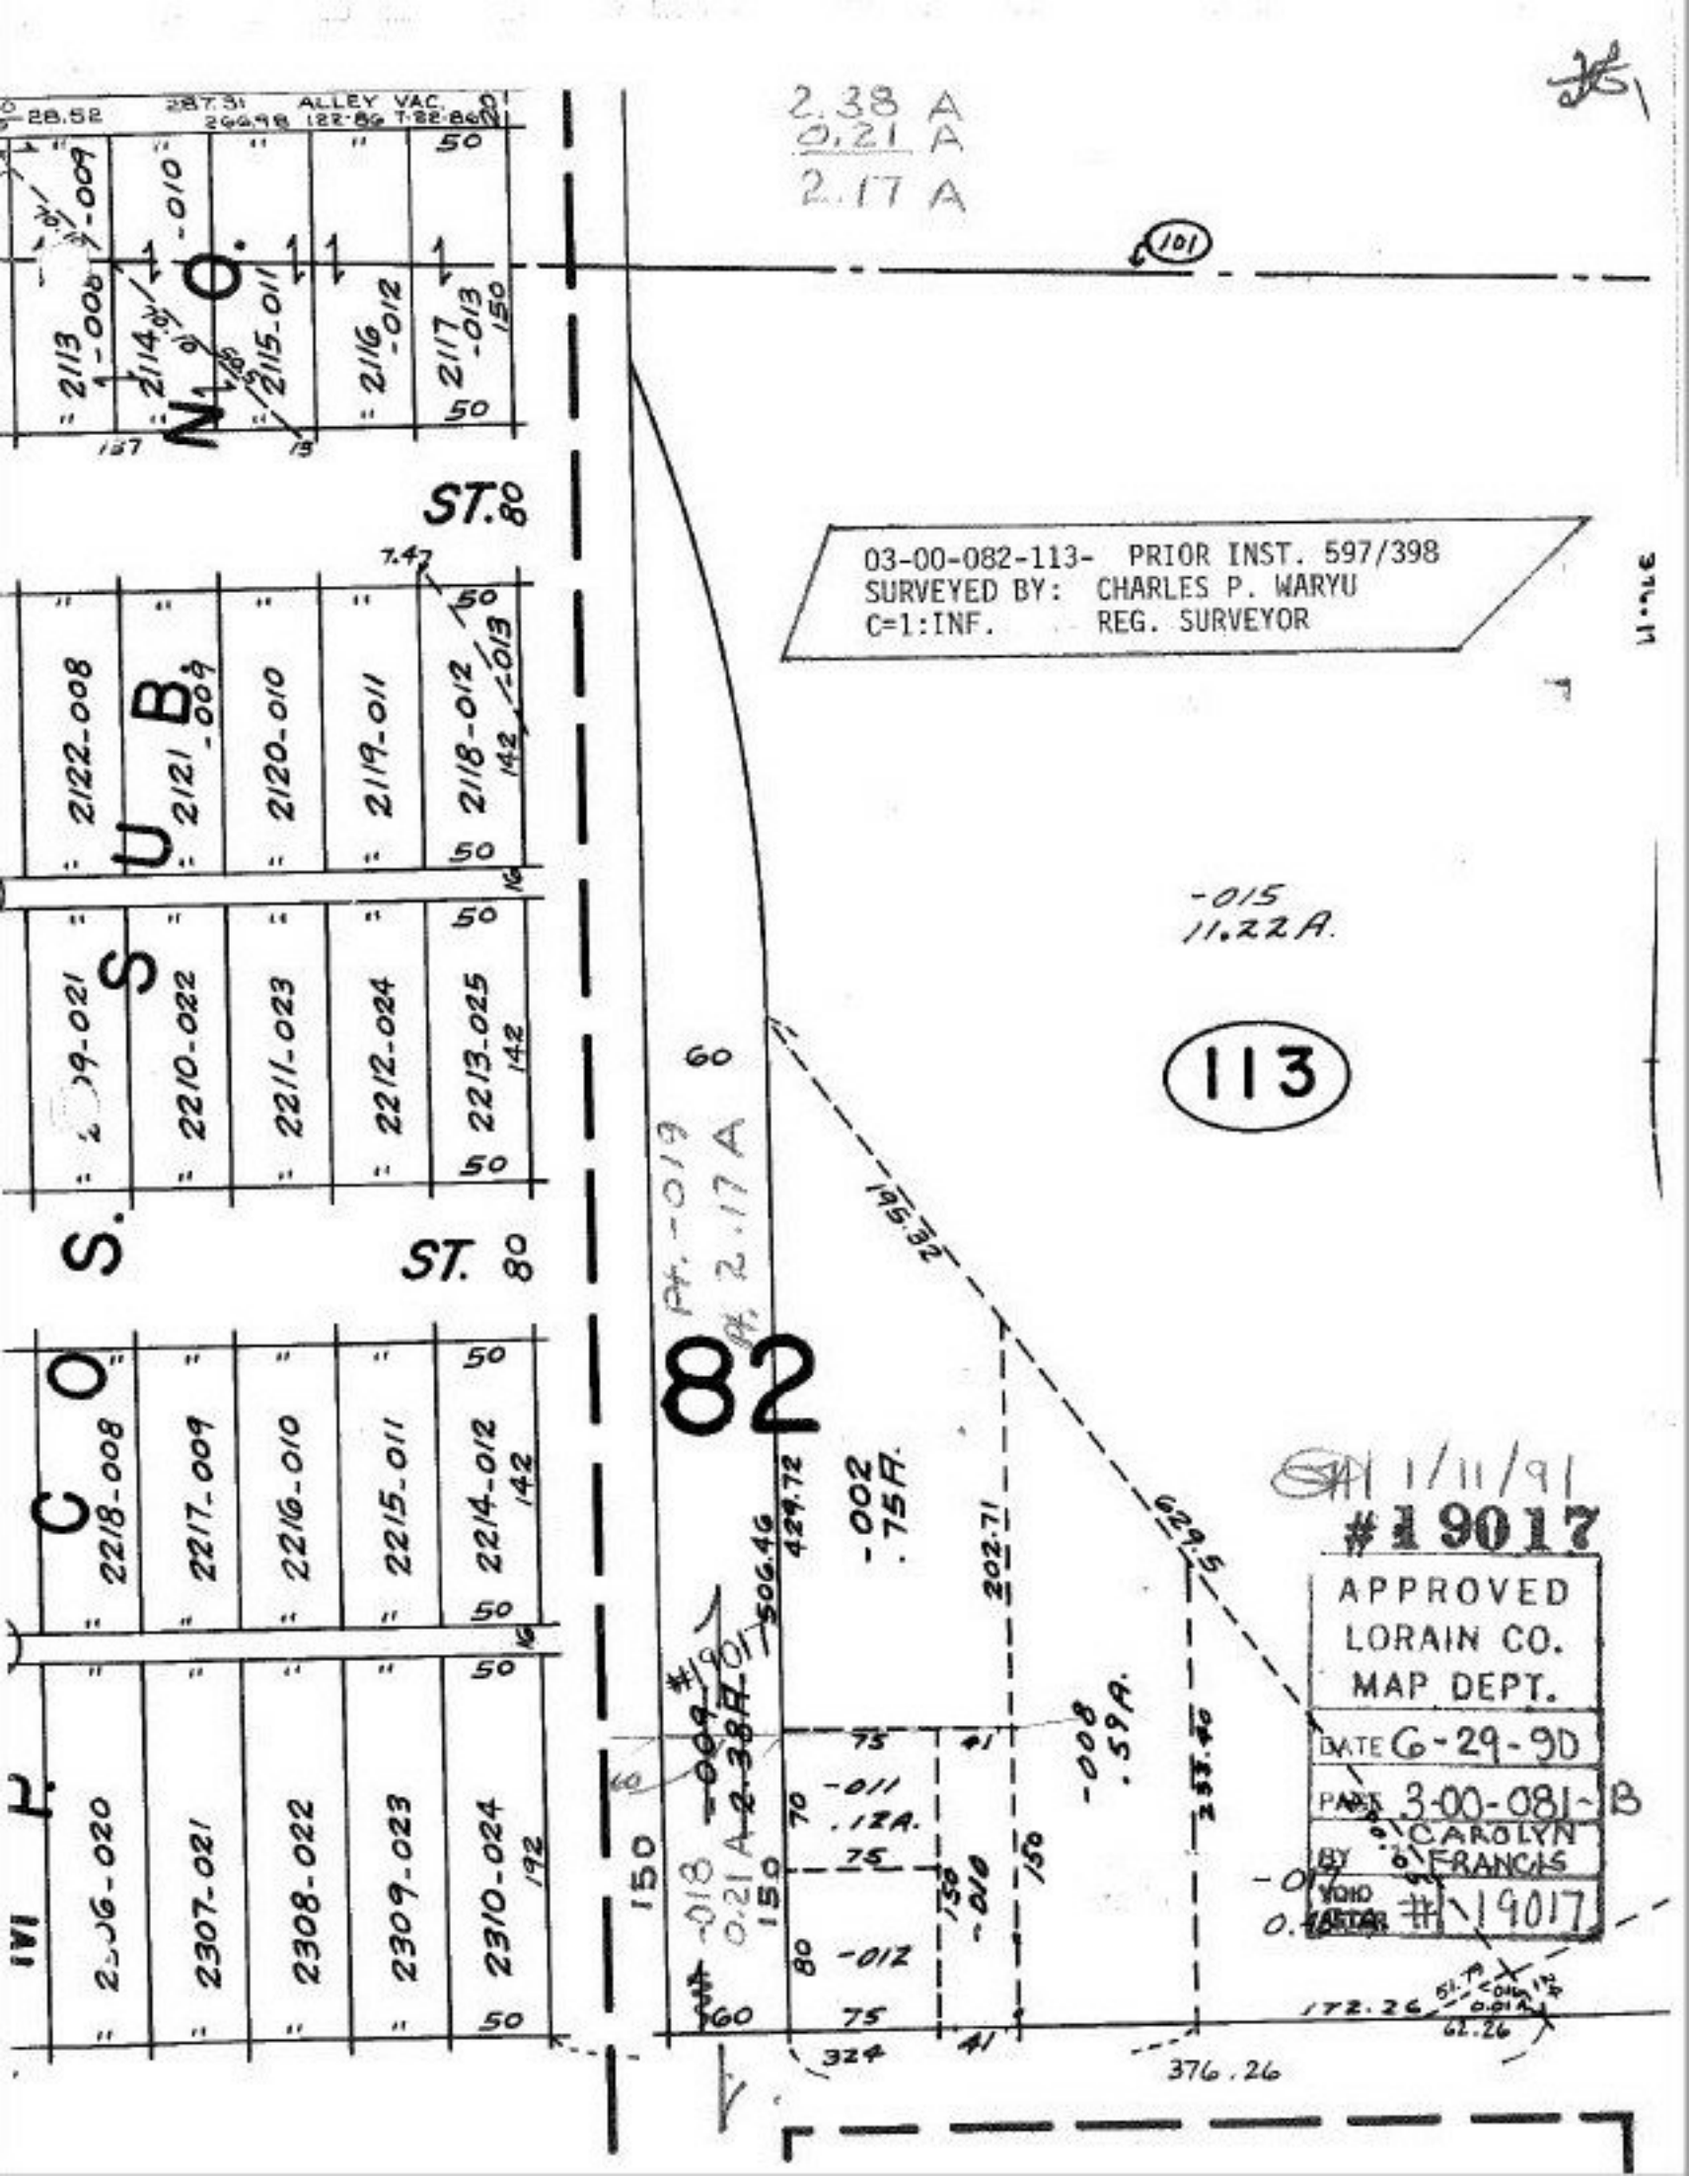
ALLEY VAC.
2.38 A
0.21 A
2.17 A
101
ST. 80
03-00-082-113- PRIOR INST. 597/398
SURVEYED BY: CHARLES P. WARYU
C=1:INF. REG. SURVEYOR
-015
11.22A.
113
82
Pt. -019
Pt. 2.17 A
-002
.75A.
-008
.59A.
-011
.12A.
-012
-010
-009
#18
0.21 A
-018
0.21 A
1/11/91
#19017
APPROVED
LORAIN CO.
MAP DEPT.
DATE 6-29-90
PAR 3-00-081-B
BY CAROLYN FRANCIS
VOID
ALTER #19017
S. ST. 80
N. P.
N. O.
S. U. B.
S. C. O.
P. M.