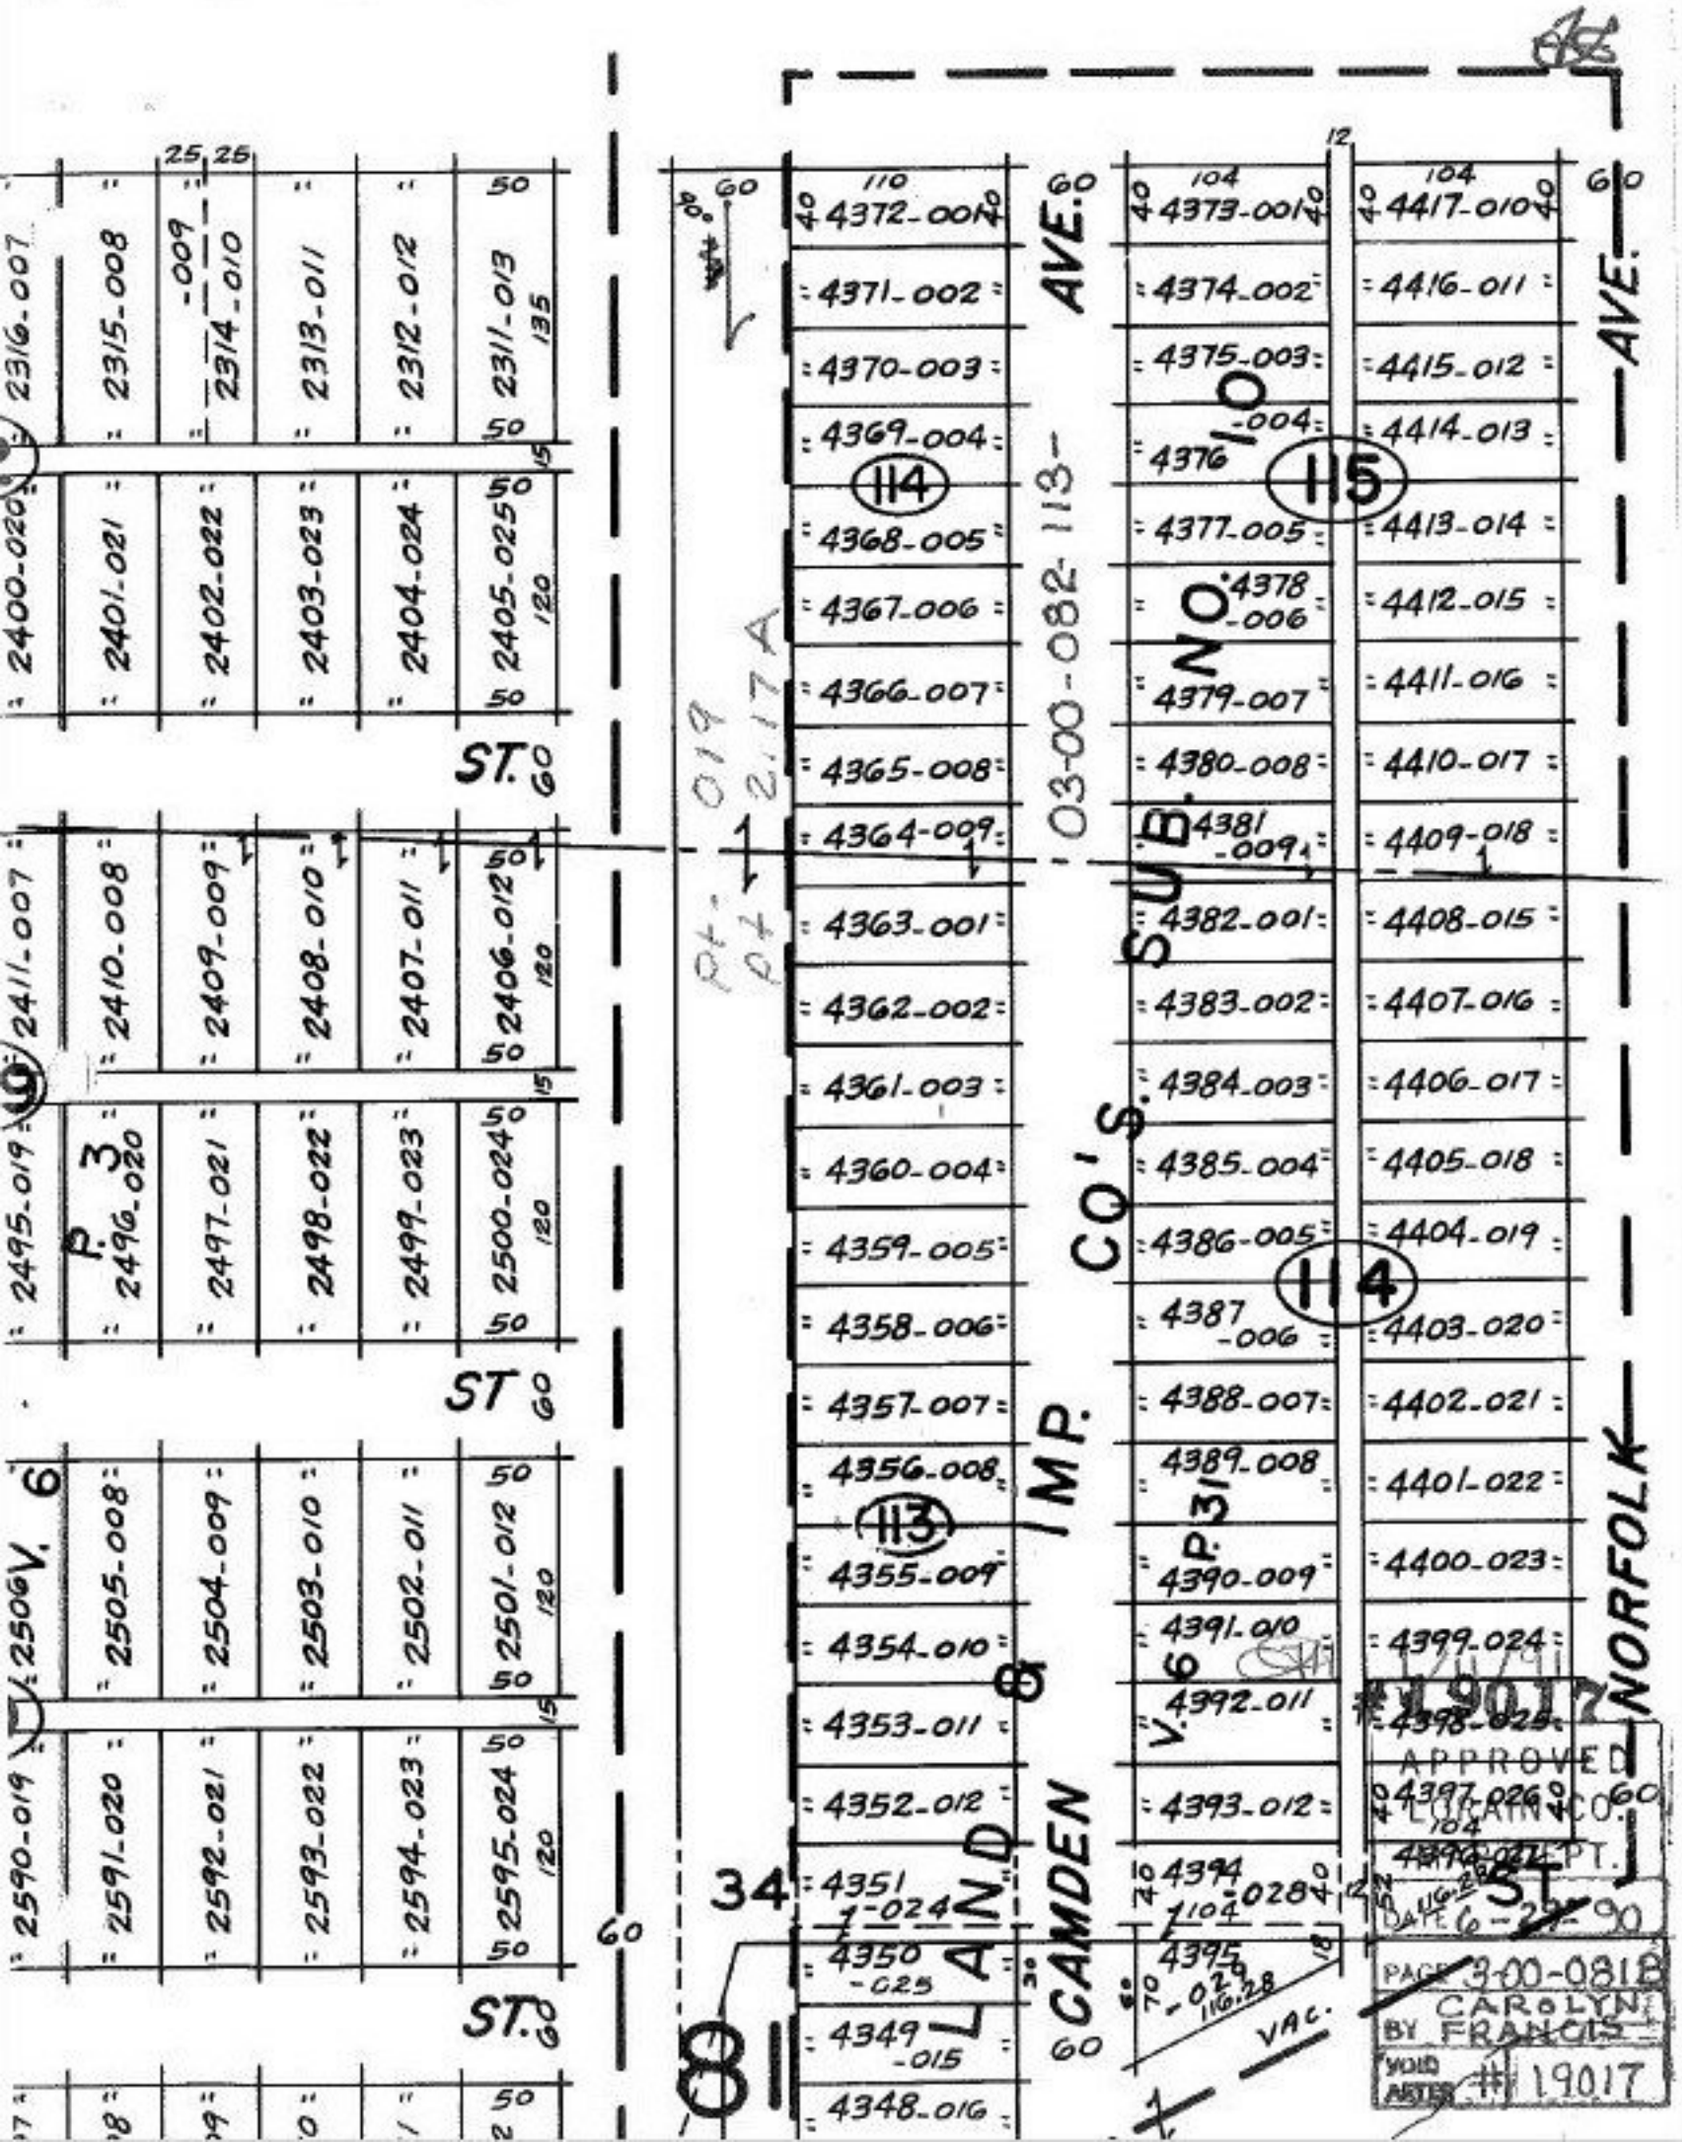

LAND & IMP. CO'S. SUB. NO. 10
CAMDEN AVE.
NORFOLK AVE.
ST.
ST
ST.
ST.
03-00-082-113-
Pt. 019
2.17A
114
115
113
114
34
81
V. 6
P. 3
P. 31
V. 6
2316-007
2315-008
2314-010
2313-011
2312-012
2311-013
2400-020
2401-021
2402-022
2403-023
2404-024
2405-025
2411-007
2410-008
2409-009
2408-010
2407-011
2406-012
2495-019
2496-020
2497-021
2498-022
2499-023
2500-024
2506
2505-008
2504-009
2503-010
2502-011
2501-012
2590-019
2591-020
2592-021
2593-022
2594-023
2595-024
4372-001
4371-002
4370-003
4369-004
4368-005
4367-006
4366-007
4365-008
4364-009
4363-001
4362-002
4361-003
4360-004
4359-005
4358-006
4357-007
4356-008
4355-009
4354-010
4353-011
4352-012
4351-024
4350-025
4349-015
4348-016
4373-001
4374-002
4375-003
4376-004
4377-005
4378-006
4379-007
4380-008
4381-009
4382-001
4383-002
4384-003
4385-004
4386-005
4387-006
4388-007
4389-008
4390-009
4391-010
4392-011
4393-012
4394-028
4395-029
4417-010
4416-011
4415-012
4414-013
4413-014
4412-015
4411-016
4410-017
4409-018
4408-015
4407-016
4406-017
4405-018
4404-019
4403-020
4402-021
4401-022
4400-023
4399-024
4398-025
4397-026
4396-027
VAC.
#19017
APPROVED
LORAIN CO.
PT.
DATE 6-29-90
PAGE 3-00-081B
BY CAROLYN FRANCIS
VOID AFTER #19017